


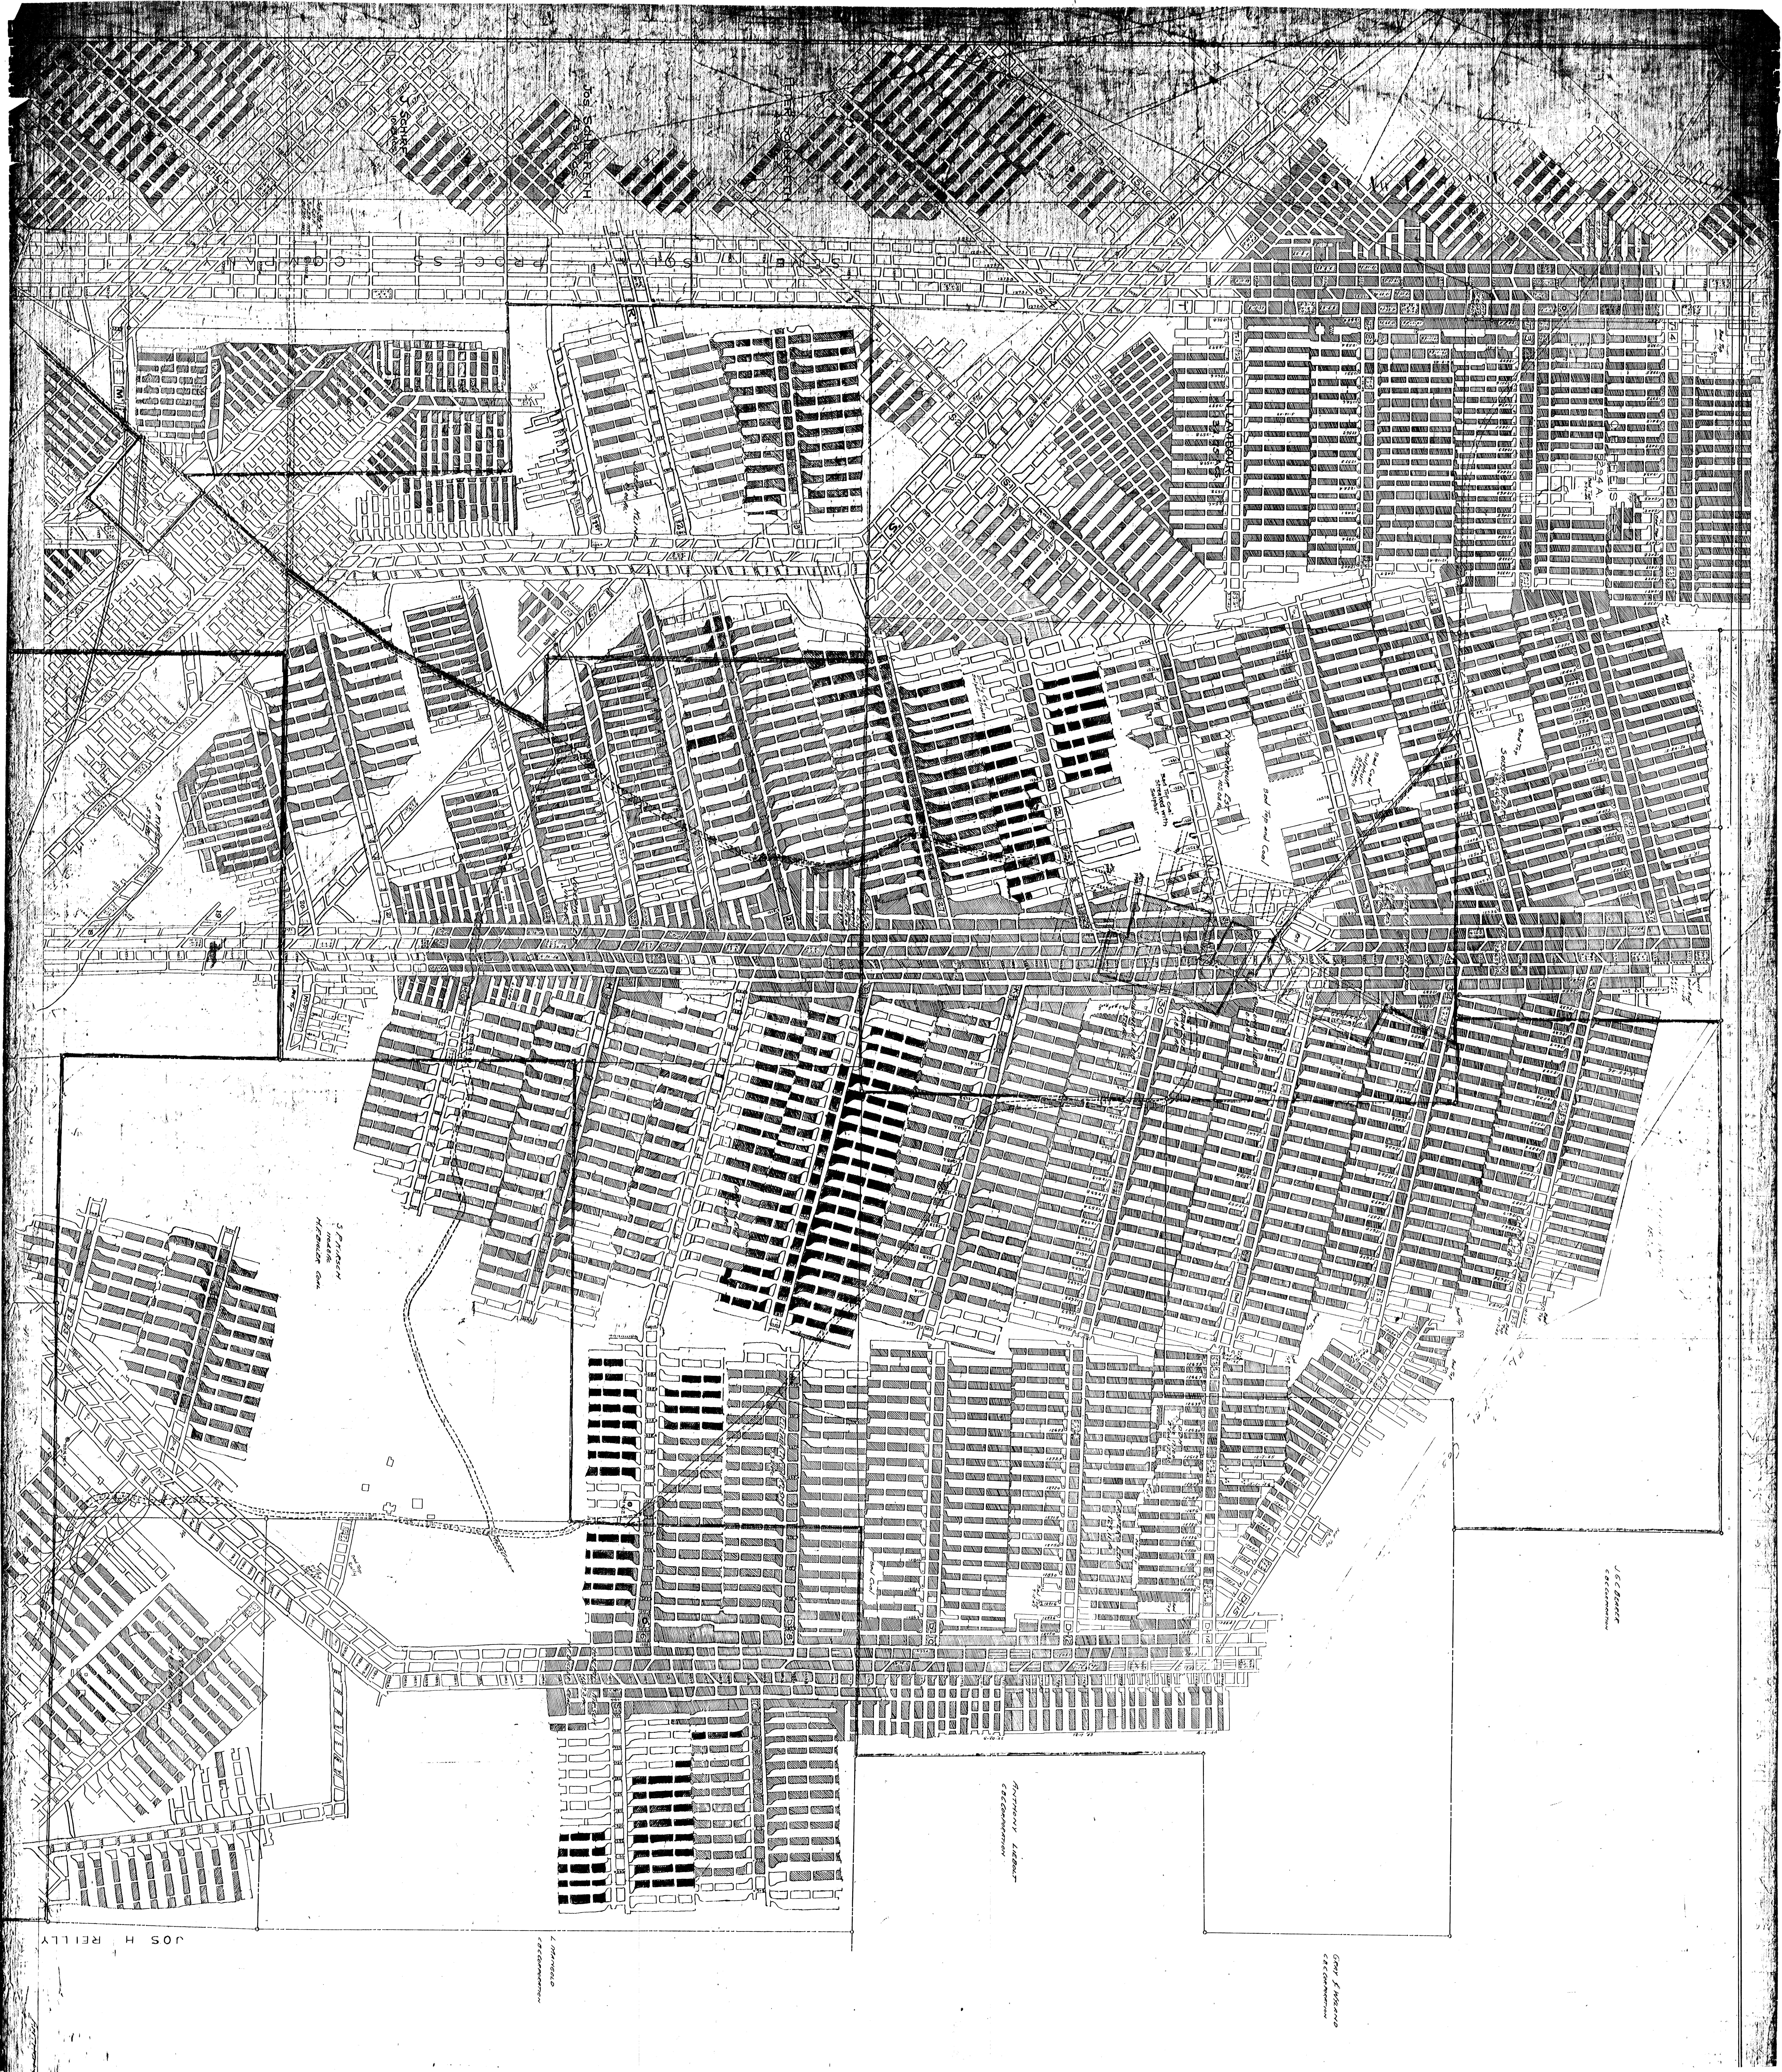

JOS. H. REILLY




