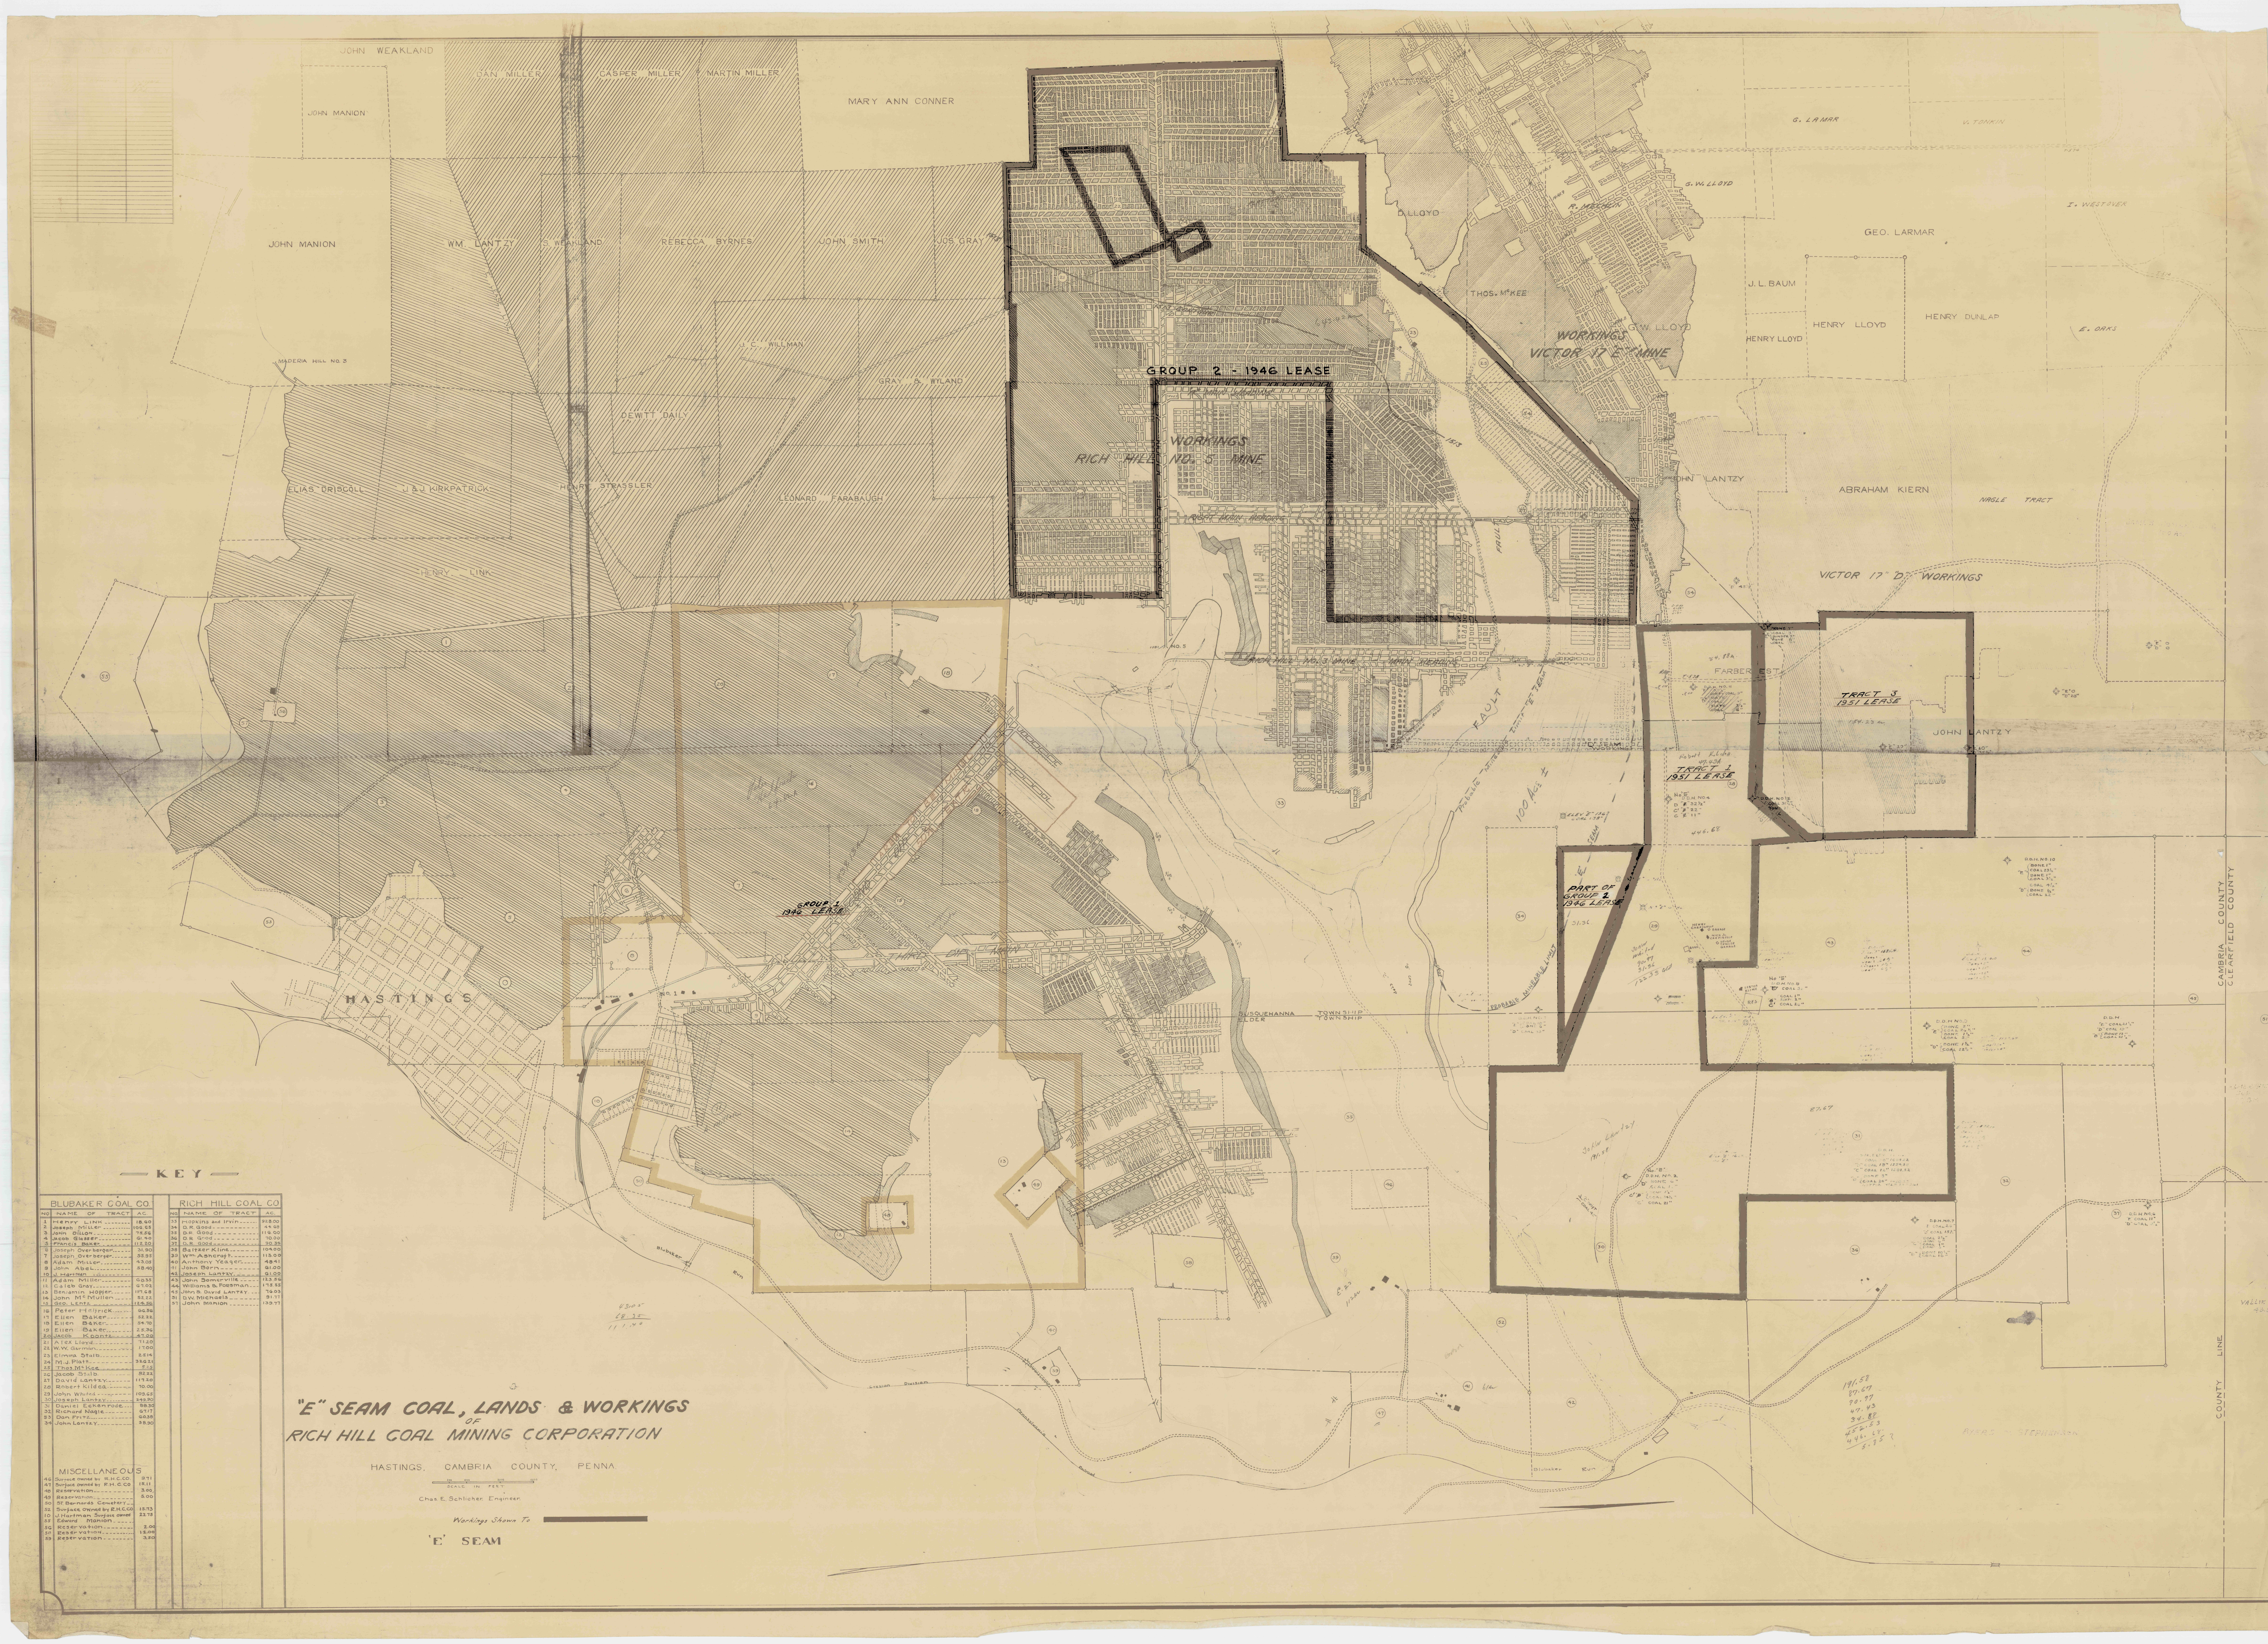
JOHN WEAKLAND
JOHN MANION
JAN MILLER
CASPER MILLER
MARTIN MILLER
MARY ANN CONNER
JOHN MANION
WM. LANTZY
REBECCA BYRNES
JOHN SMITH
JOS. GRAY
GRAY & BLAND
DEWITT DAIL
ELIAS DRISCOLL
J & J KIRKPATRICK
HENRY STRASSLER
LEONARD FARABAUGH
HENRY LINK
MADEIRA HILL NO. 2
GROUP 2 - 1946 LEASE
WORKINGS RICH HILL NO. 5 MINE
WORKINGS VICTOR 17 E MINE
D. LLOYD
THOS. McKEE
G.W. LLOYD
G. W. LLOYD
G. LAMAR
GEO. LARMAR
J. L. BAUM
HENRY LLOYD
HENRY LLOYD
HENRY DUNLAP
E. OAKS
JOHN LANTZY
ABRAHAM KIERN
NAGLE TRACT
VICTOR 17 "D" WORKINGS
FAULT
FAULT
100 feet
FARBER EST.
TRACT 3 1951 LEASE
JOHN LANTZY
TRACT 1 1951 LEASE
PART OF GROUP 1 1946 LEASE
GROUP 1 1946 LEASE
HASTINGS
SUSQUEHANNA TOWNSHIP
ELDER TOWNSHIP
CAMBRIA COUNTY
CLEARFIELD COUNTY
COUNTY LINE

"E" SEAM COAL, LANDS & WORKINGS
OF
RICH HILL COAL MINING CORPORATION

HASTINGS, CAMBRIA COUNTY, PENNA.

200 400 800 1200
SCALE IN FEET

Chas. E. Schlicher. Engineer.

Workings Shown To

'E' SEAM

43.05
68.35
111.40

— KEY —

BLUBAKER COAL CO.		
NO	NAME OF TRACT	AC.
1	Henry LINK	18.60
2	Joseph Miller	106.65
3	John DILLON	75.56
4	JACOB Glasser	61.40
5	Francis Baker	112.20
6	Joseph Overberger	31.90
7	Joseph Overberger	55.95
8	Adam Miller	43.05
9	John Abel	58.40
10	J. Hartman	
11	Adam Miller	68.35
12	Caleb Gray	67.02
13	Benjamin Hopfer	117.68
14	John McMullen	52.22
15	Geo. Lentz	124.56
16	Peter Helfrick	66.56
17	Ellen Baker	52.22
18	Ellen Baker	54.70
19	Ellen Baker	25.36
20	JACOB Koontz	47.00
21	Alex Lloyd	71.20
22	W.W. Garman	17.00
23	Elmira Stalb	25.14
24	M.J. Platt	326.21
25	Thos. McKee	5.25
26	Jacob Stalb	82.22
27	David Lantzy	117.20
28	Robert Kildea	70.00
29	John Whited	109.65
30	Joseph Lantzy	249.90
31	Daniel Eckenrode	88.30
32	Richard Nagle	67.17
53	Dan Fritz	60.38
34	John Lantzy	38.90

RICH HILL COAL CO		
NO.	NAME OF TRACT	AC.
33	Hopkins and Irvin	928.00
34	D. R. Good	44.68
35	D.R. Good	116.00
36	D.R Good	70.00
37	D.R. Good	90.34
38	Baltzer Kline	104.00
39	Wm. Ashcraft	113.00
40	Anthony Yeager	48.41
41	John Born	61.00
42	Joseph Lantzy	61.00
43	John Somerville	123.56
44	Williams & Forsman	175.55
45	John & David Lantzy	76.03
51	D.W. Michaels	91.77
57	John Manion	139.77

MISCELLANEOUS

46	Surface owned by R.H.C.CO.	9.71
47	Surface owned by R.H.C.CO	15.11
48	Reservation	3.00
49	Reservation	5.00
50	ST. Bernards Cemetery	
52	Surface owned by R.H.C.CO	15.73
10	J. Hartman Surface owned	22.75
55	Edward Manion	
56	Reservation	2.00
58	Reservation	12.00
59	Reservation	3.50