


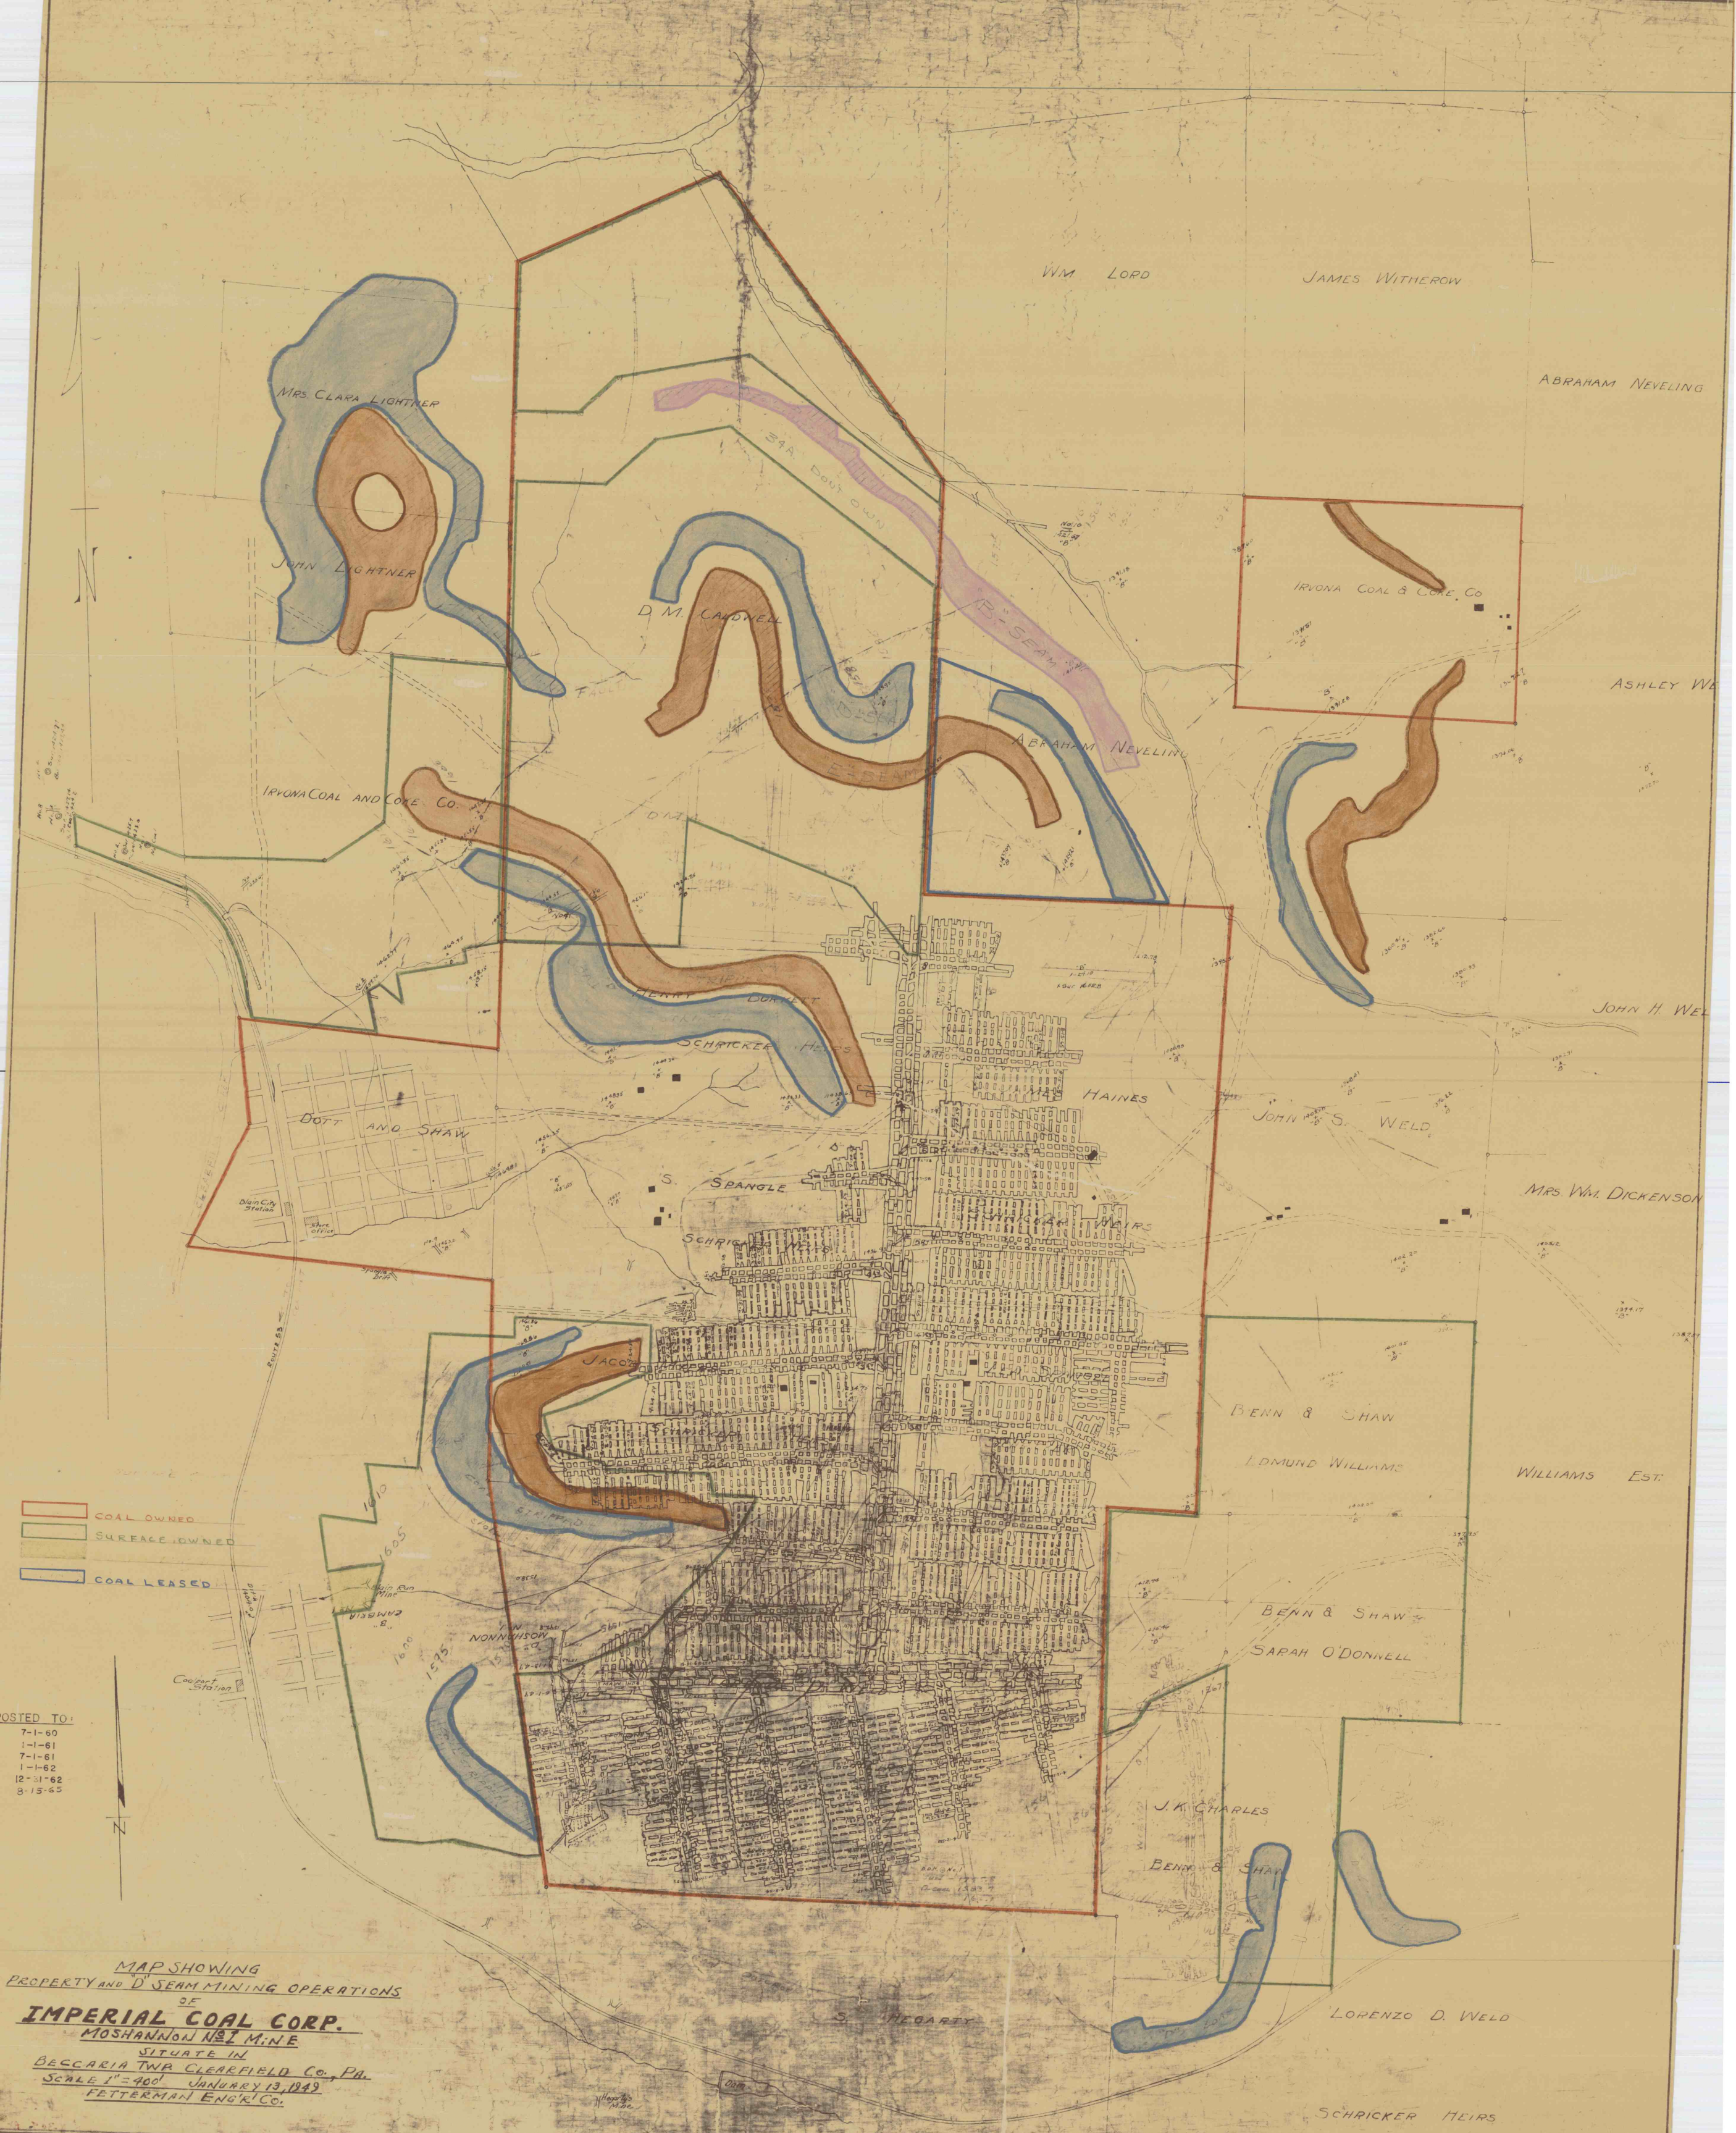

POSTED TO:
7-1-60
1-1-61
7-1-61
1-1-62
12-31-62
3-15-65

MAP SHOWING
PROPERTY AND D SEAM MINING OPERATIONS
OF
IMPERIAL COAL CORP.
MOSSHANNON NO. 1 MINE
SITUATE IN
BECCARIA TWP CLEARFIELD CO., PA.
SCALE 1"=400' JANUARY 13, 1949
FETTERMAN ENG'G CO.