


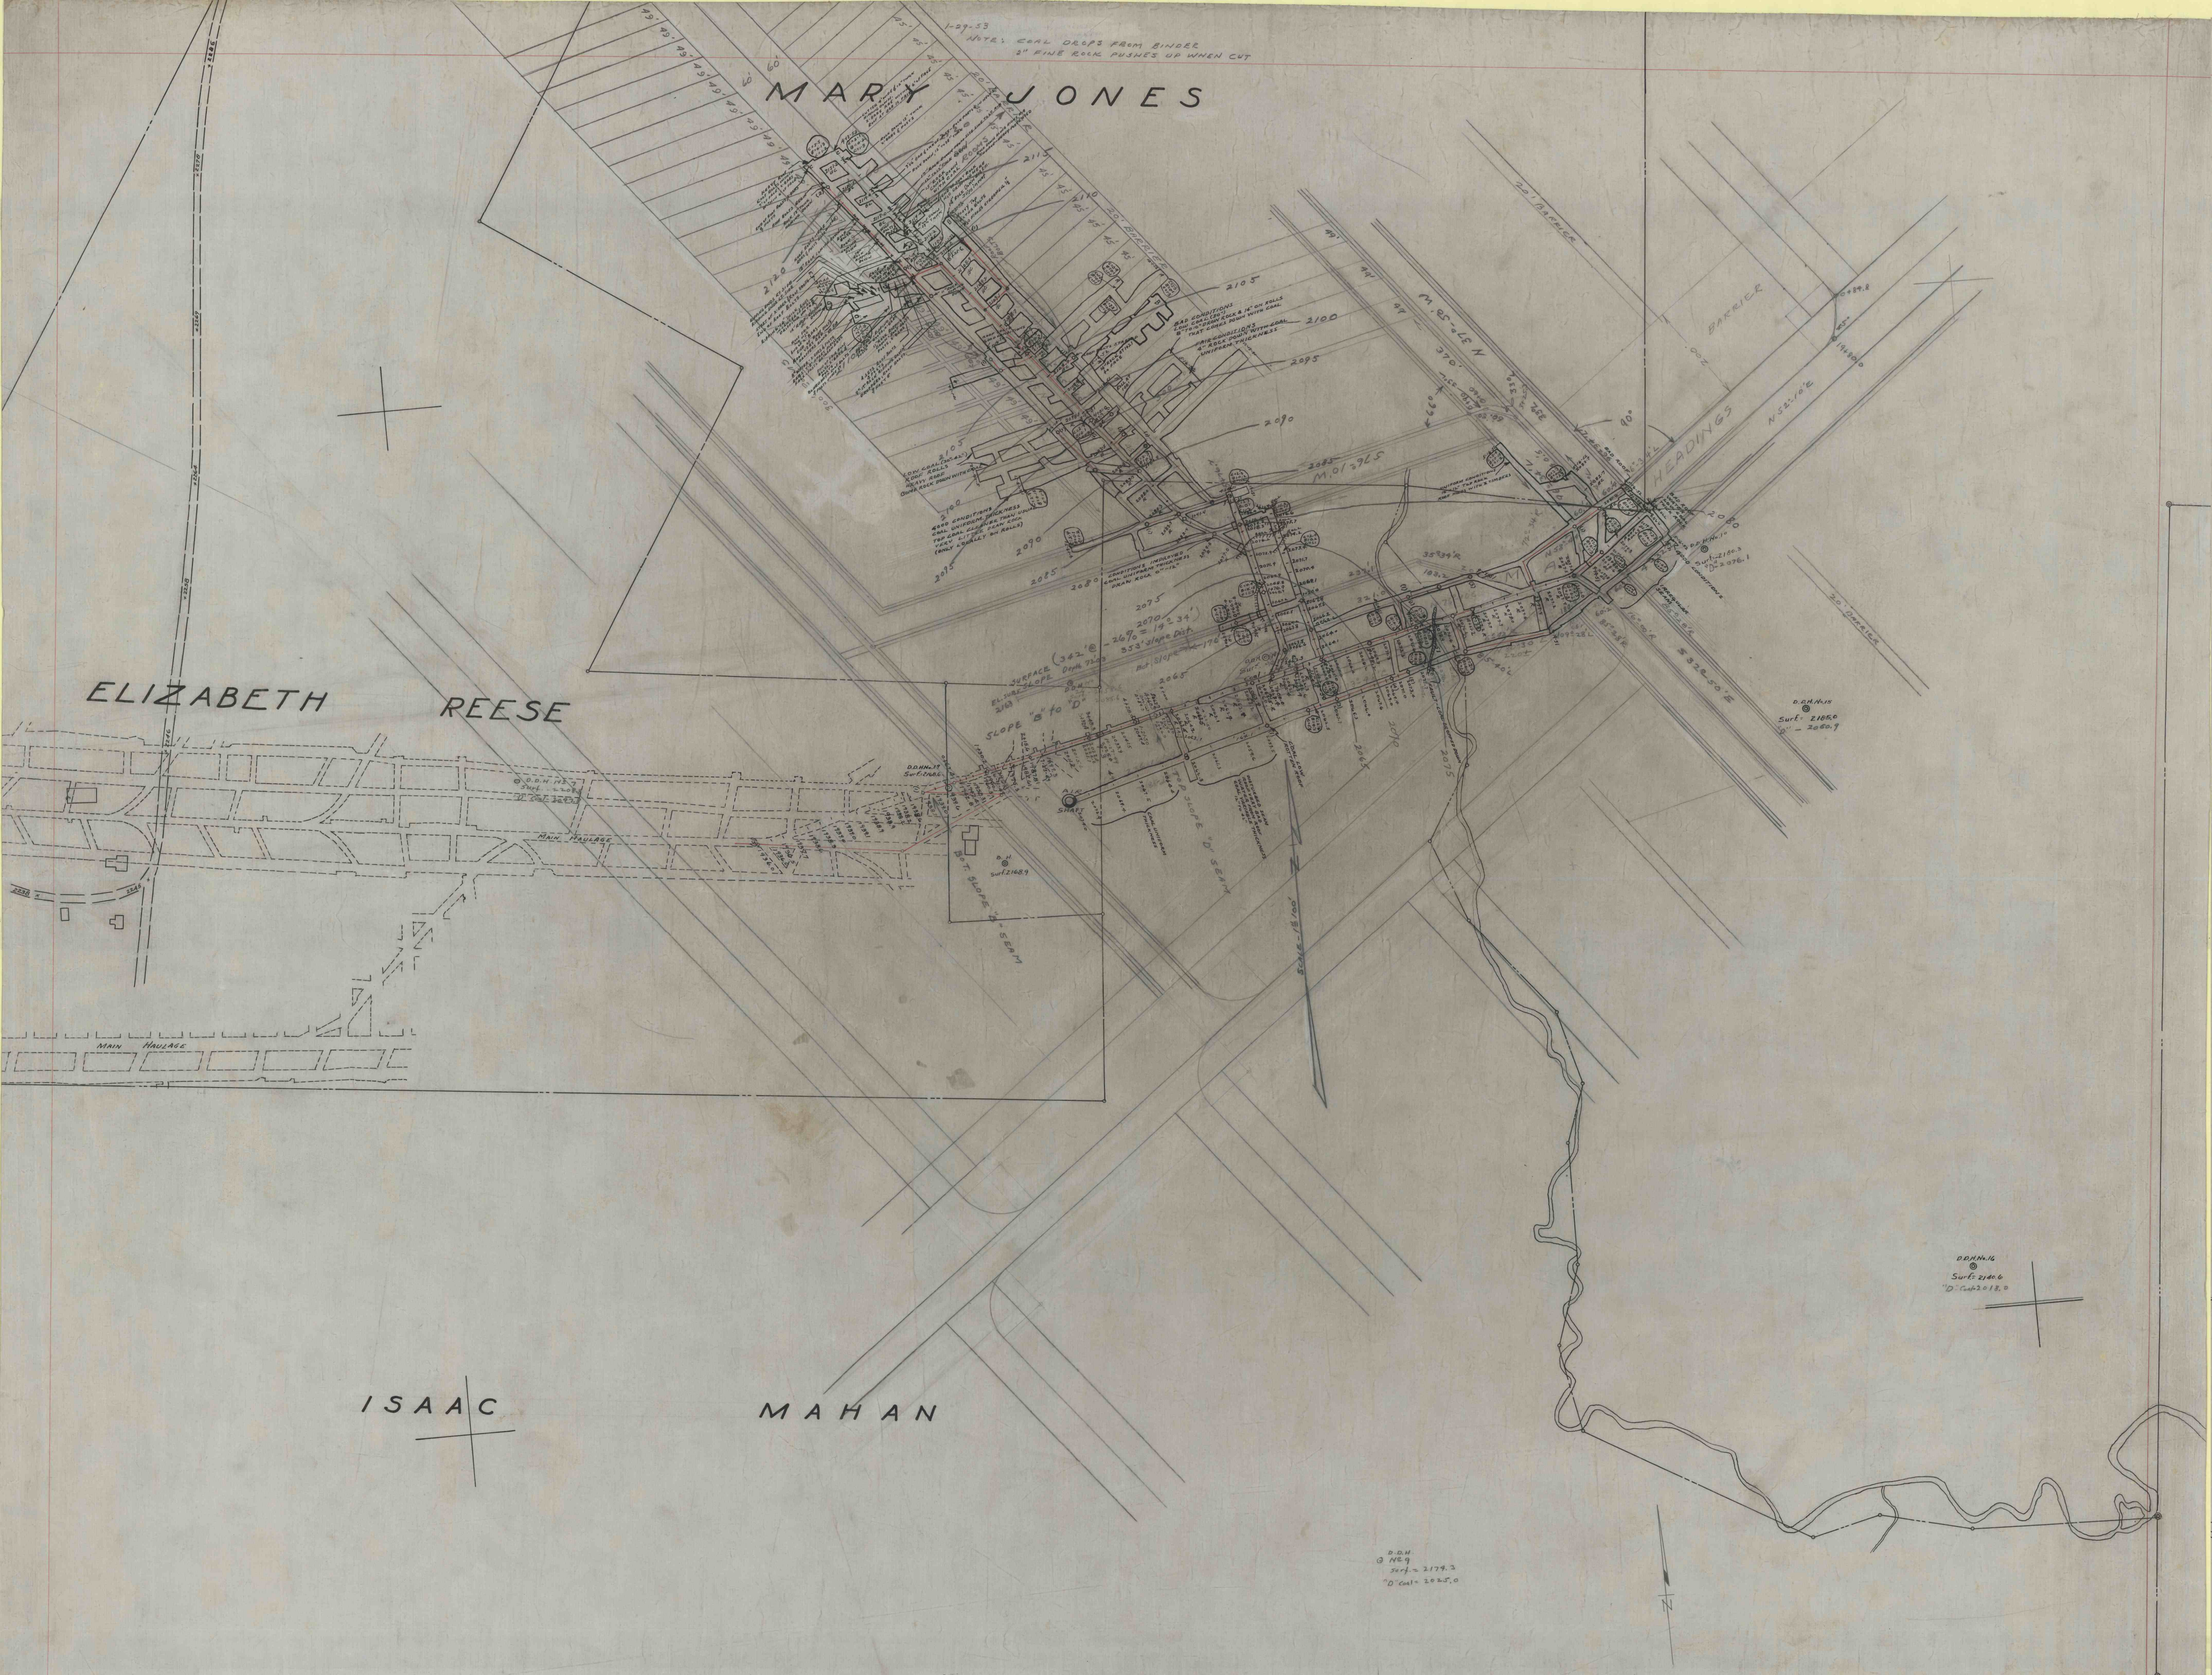

A	10-1-52
B	12-1-52
C	4-1-53
D	5-26-53

MAP SHOWING
"D" SEAM MINING OPERATIONS
OF
IMPERIAL CARDIFF COAL COMPANY
SITUATE IN
BLACKLICK & CAMBRIA TOWNSHIPS, CAMBRIA CO., PA.
SCALE - 1" = 100' JULY 13, 1949
FETTERMAN ENGR. CO.