


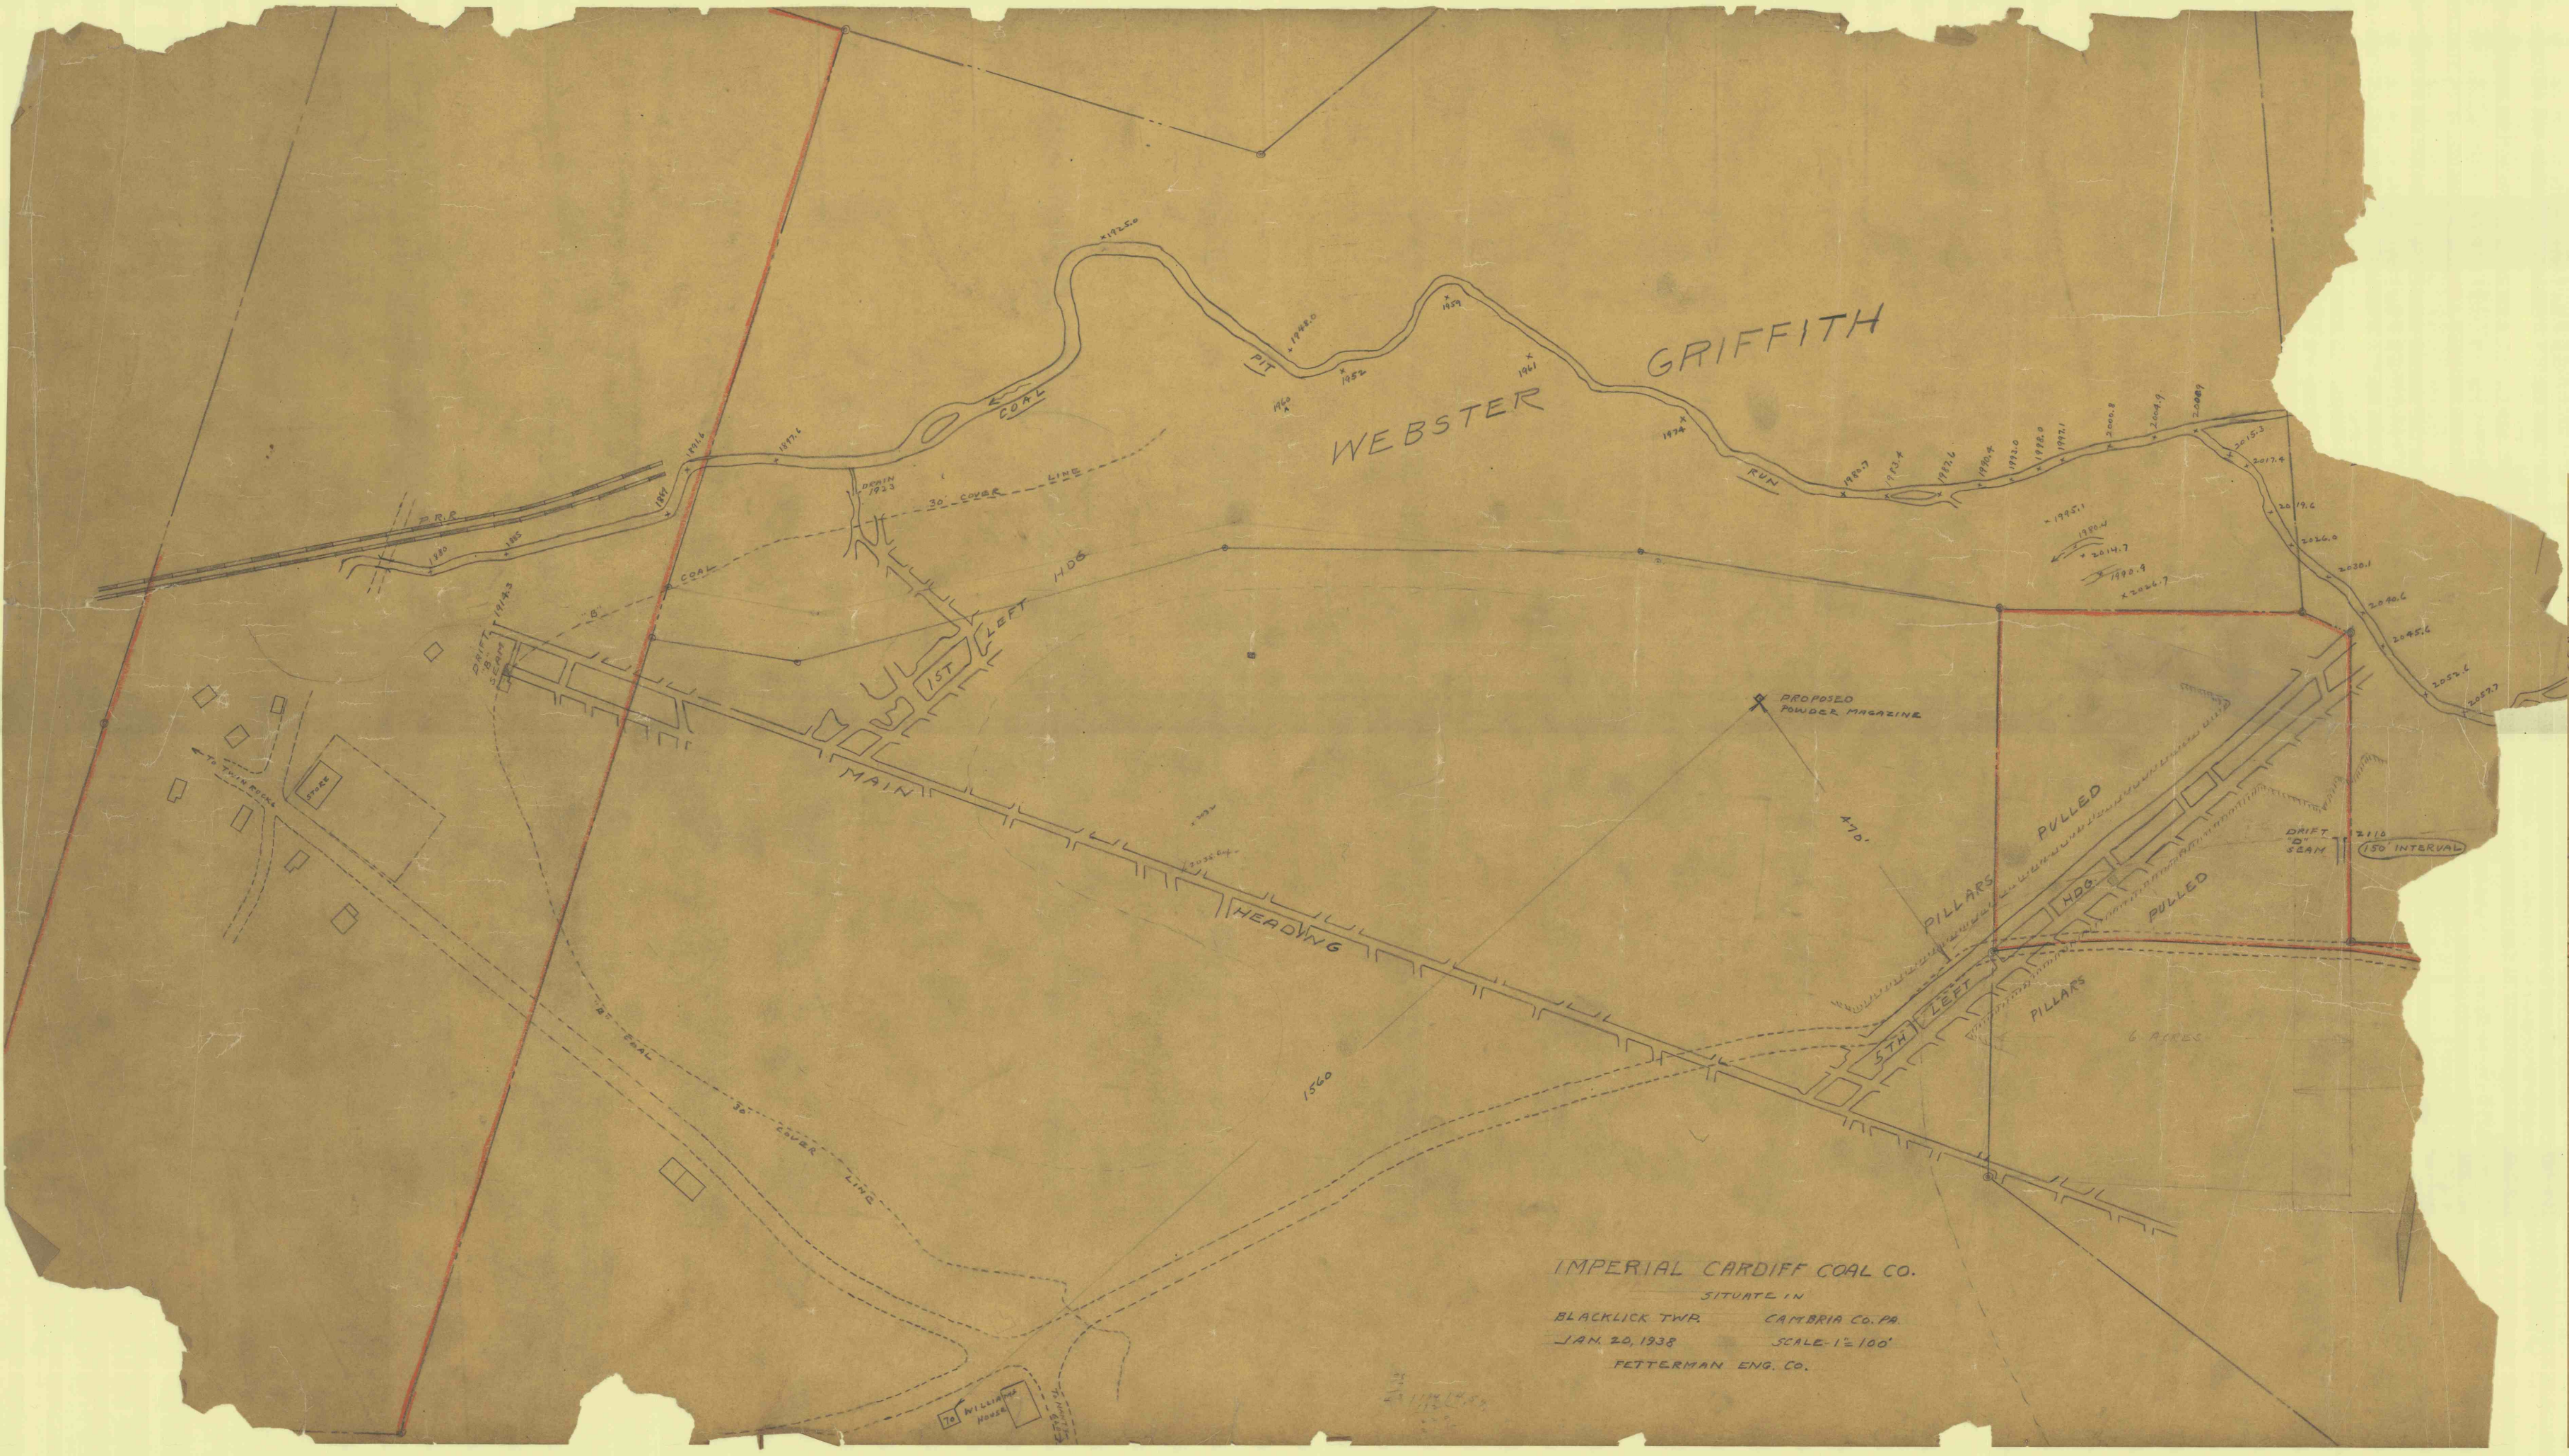

IMPERIAL CARDIFF COAL CO.
SITUATE IN
BLACKLICK TWP. CAMBRIA CO. PA.
JAN. 20, 1938 SCALE 1"=100'
FETTERMAN ENG. CO.