


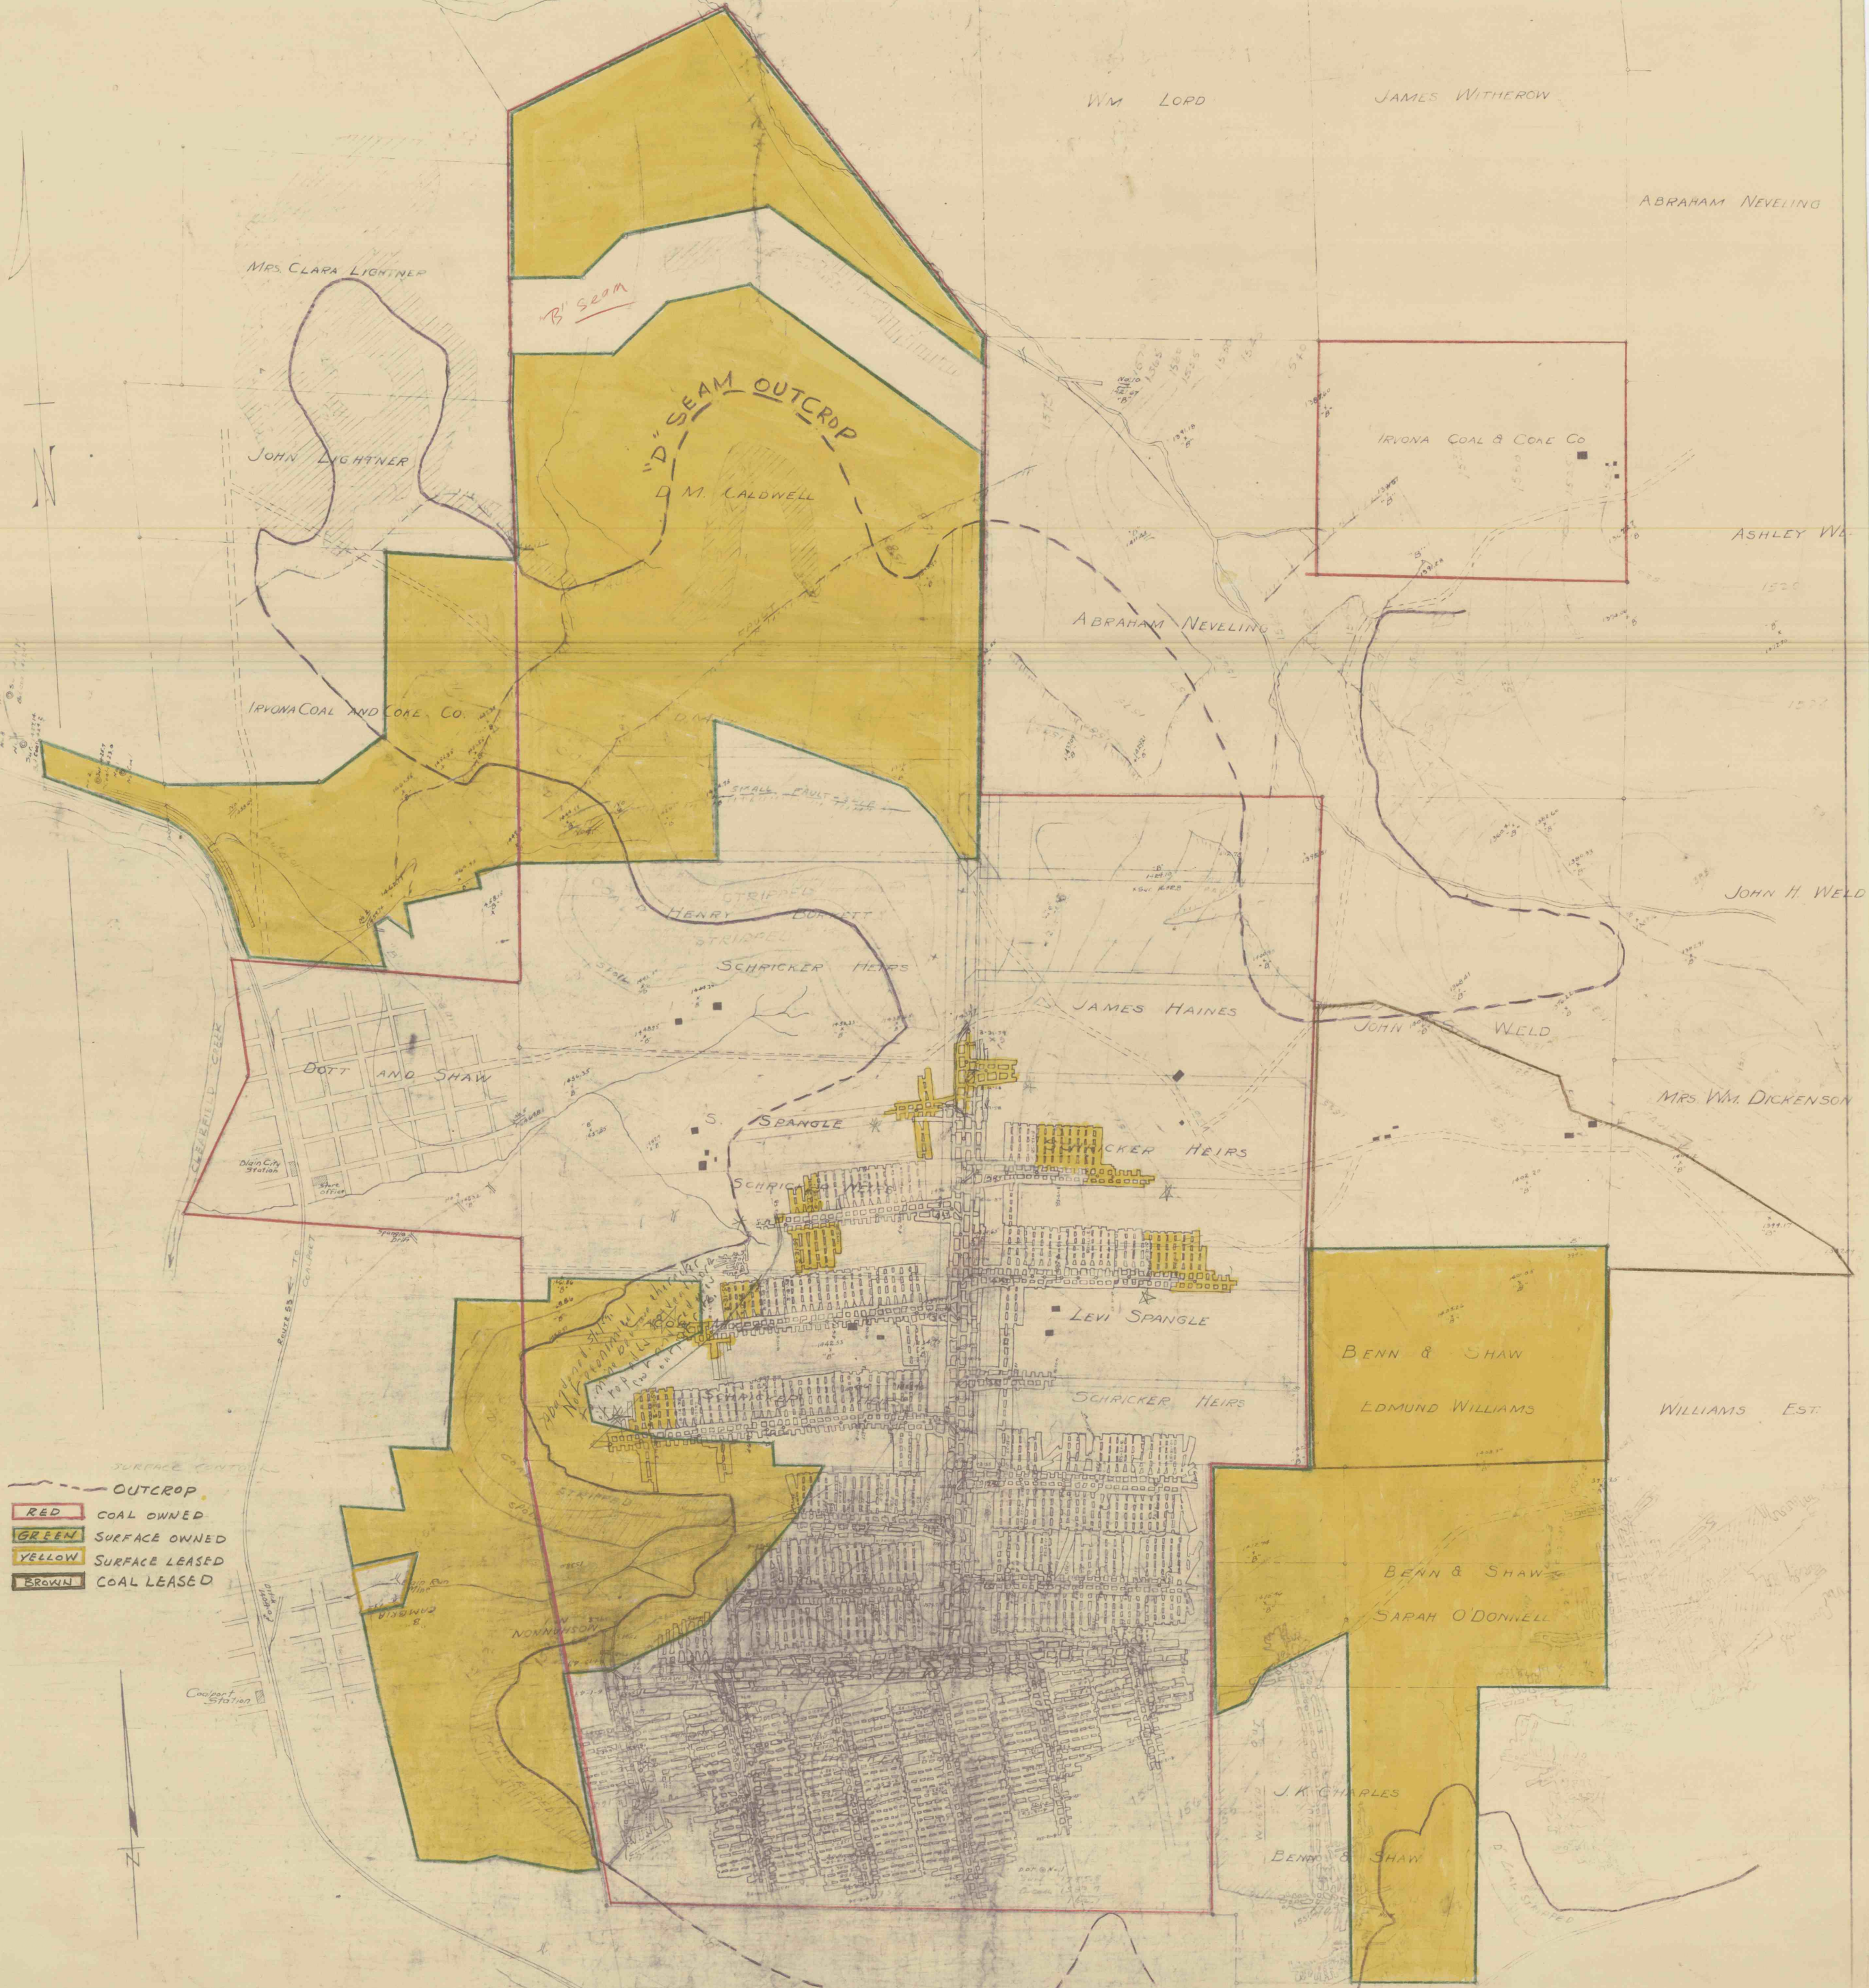

MAP SHOWING
PROPERTY AND "D" SEAM MINING OPERATIONS
OF
IMPERIAL COAL CORP.
MOSHANNON NO. 1 MINE
SITUATE IN
BESSARIA TWP CLEARFIELD CO., PA.
SCALE 1" = 400' JANUARY 13, 1949
FETTERMAN ENGR'G CO.

POSTED TO: 3/31/59