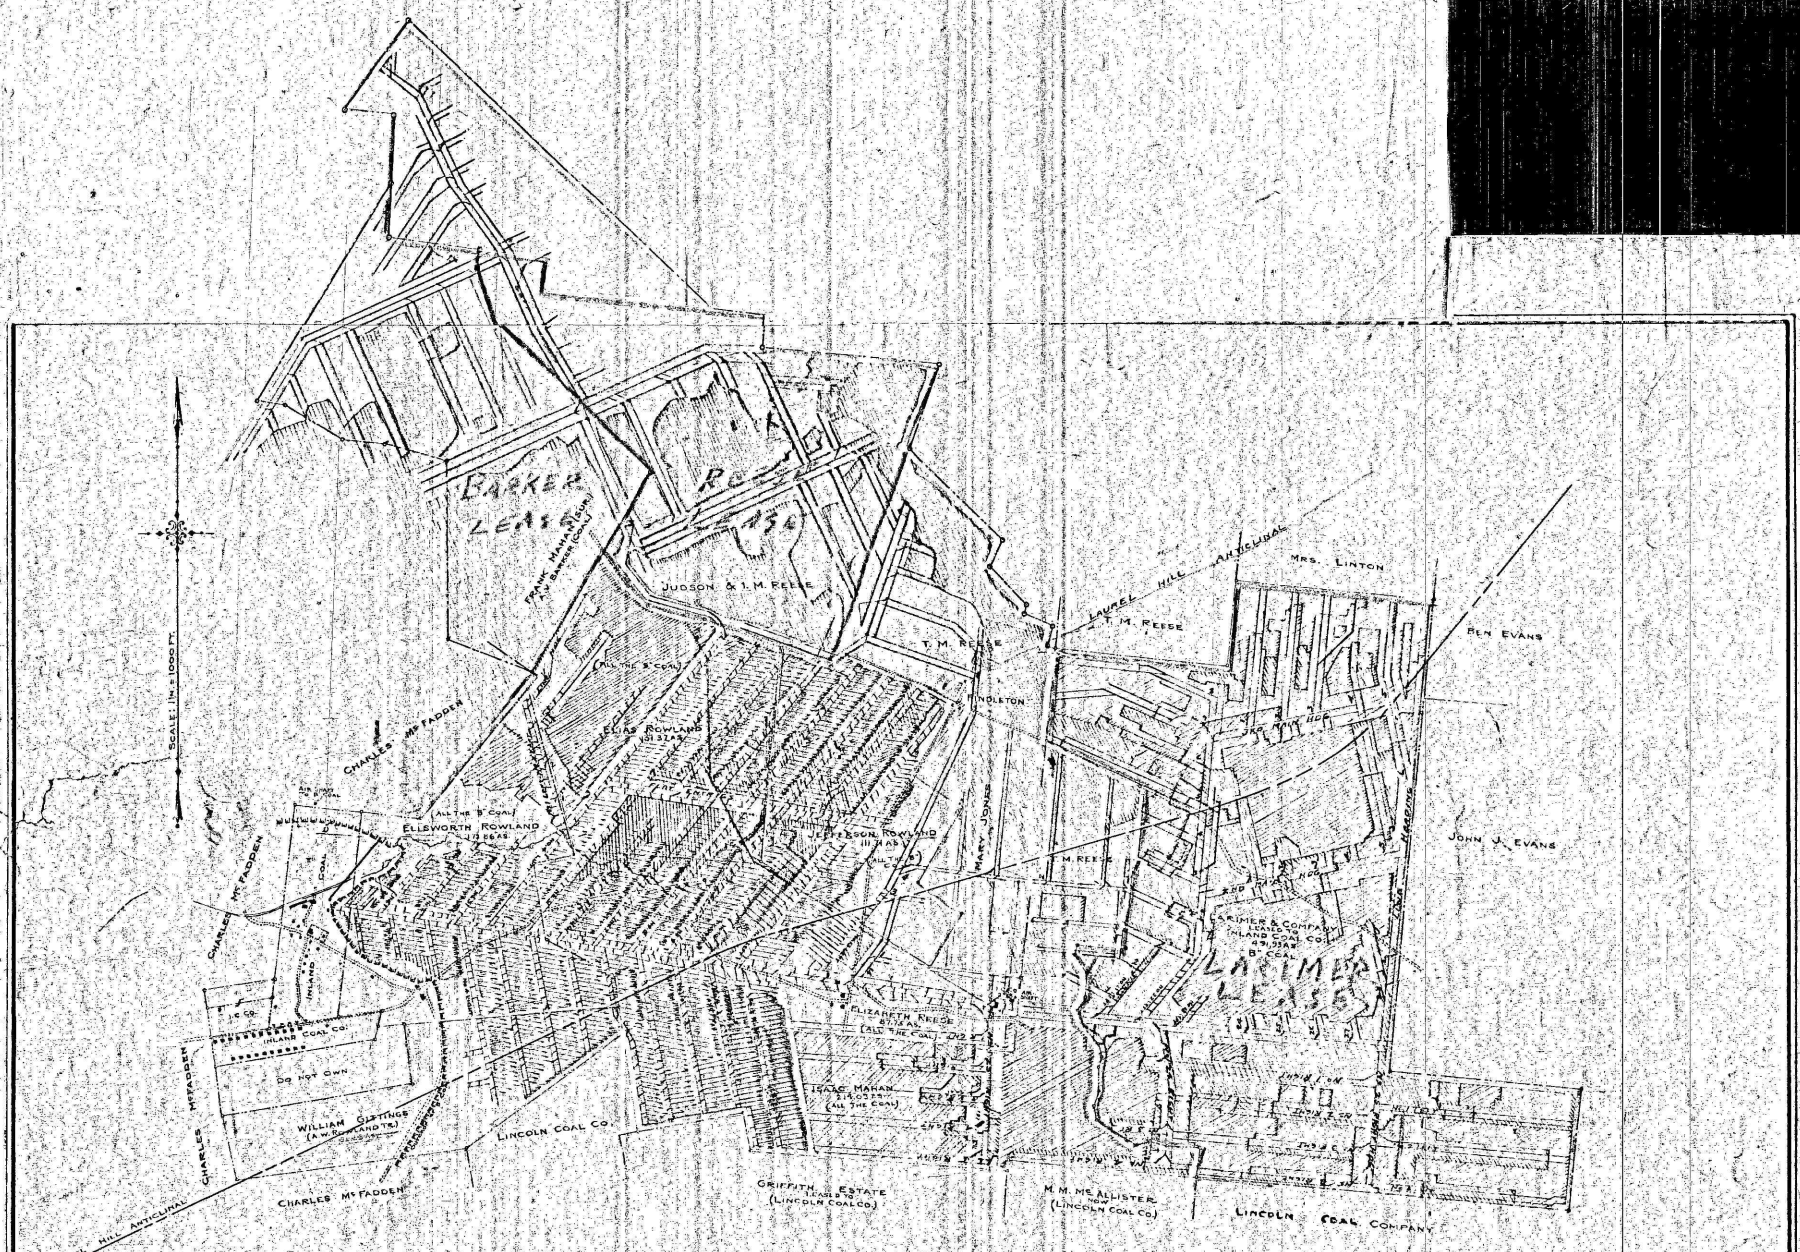

MAP OF
IMPERIAL COAL CORPORATION'S
CARDIFF MINE
SITUATE AT
NANT-Y-GLO
BLACKLICK TWP. CAMBRIA CO. PA.
SCALE: 1 In. = 1000 FT.

POSTED TO DATE AUG. 1-1917