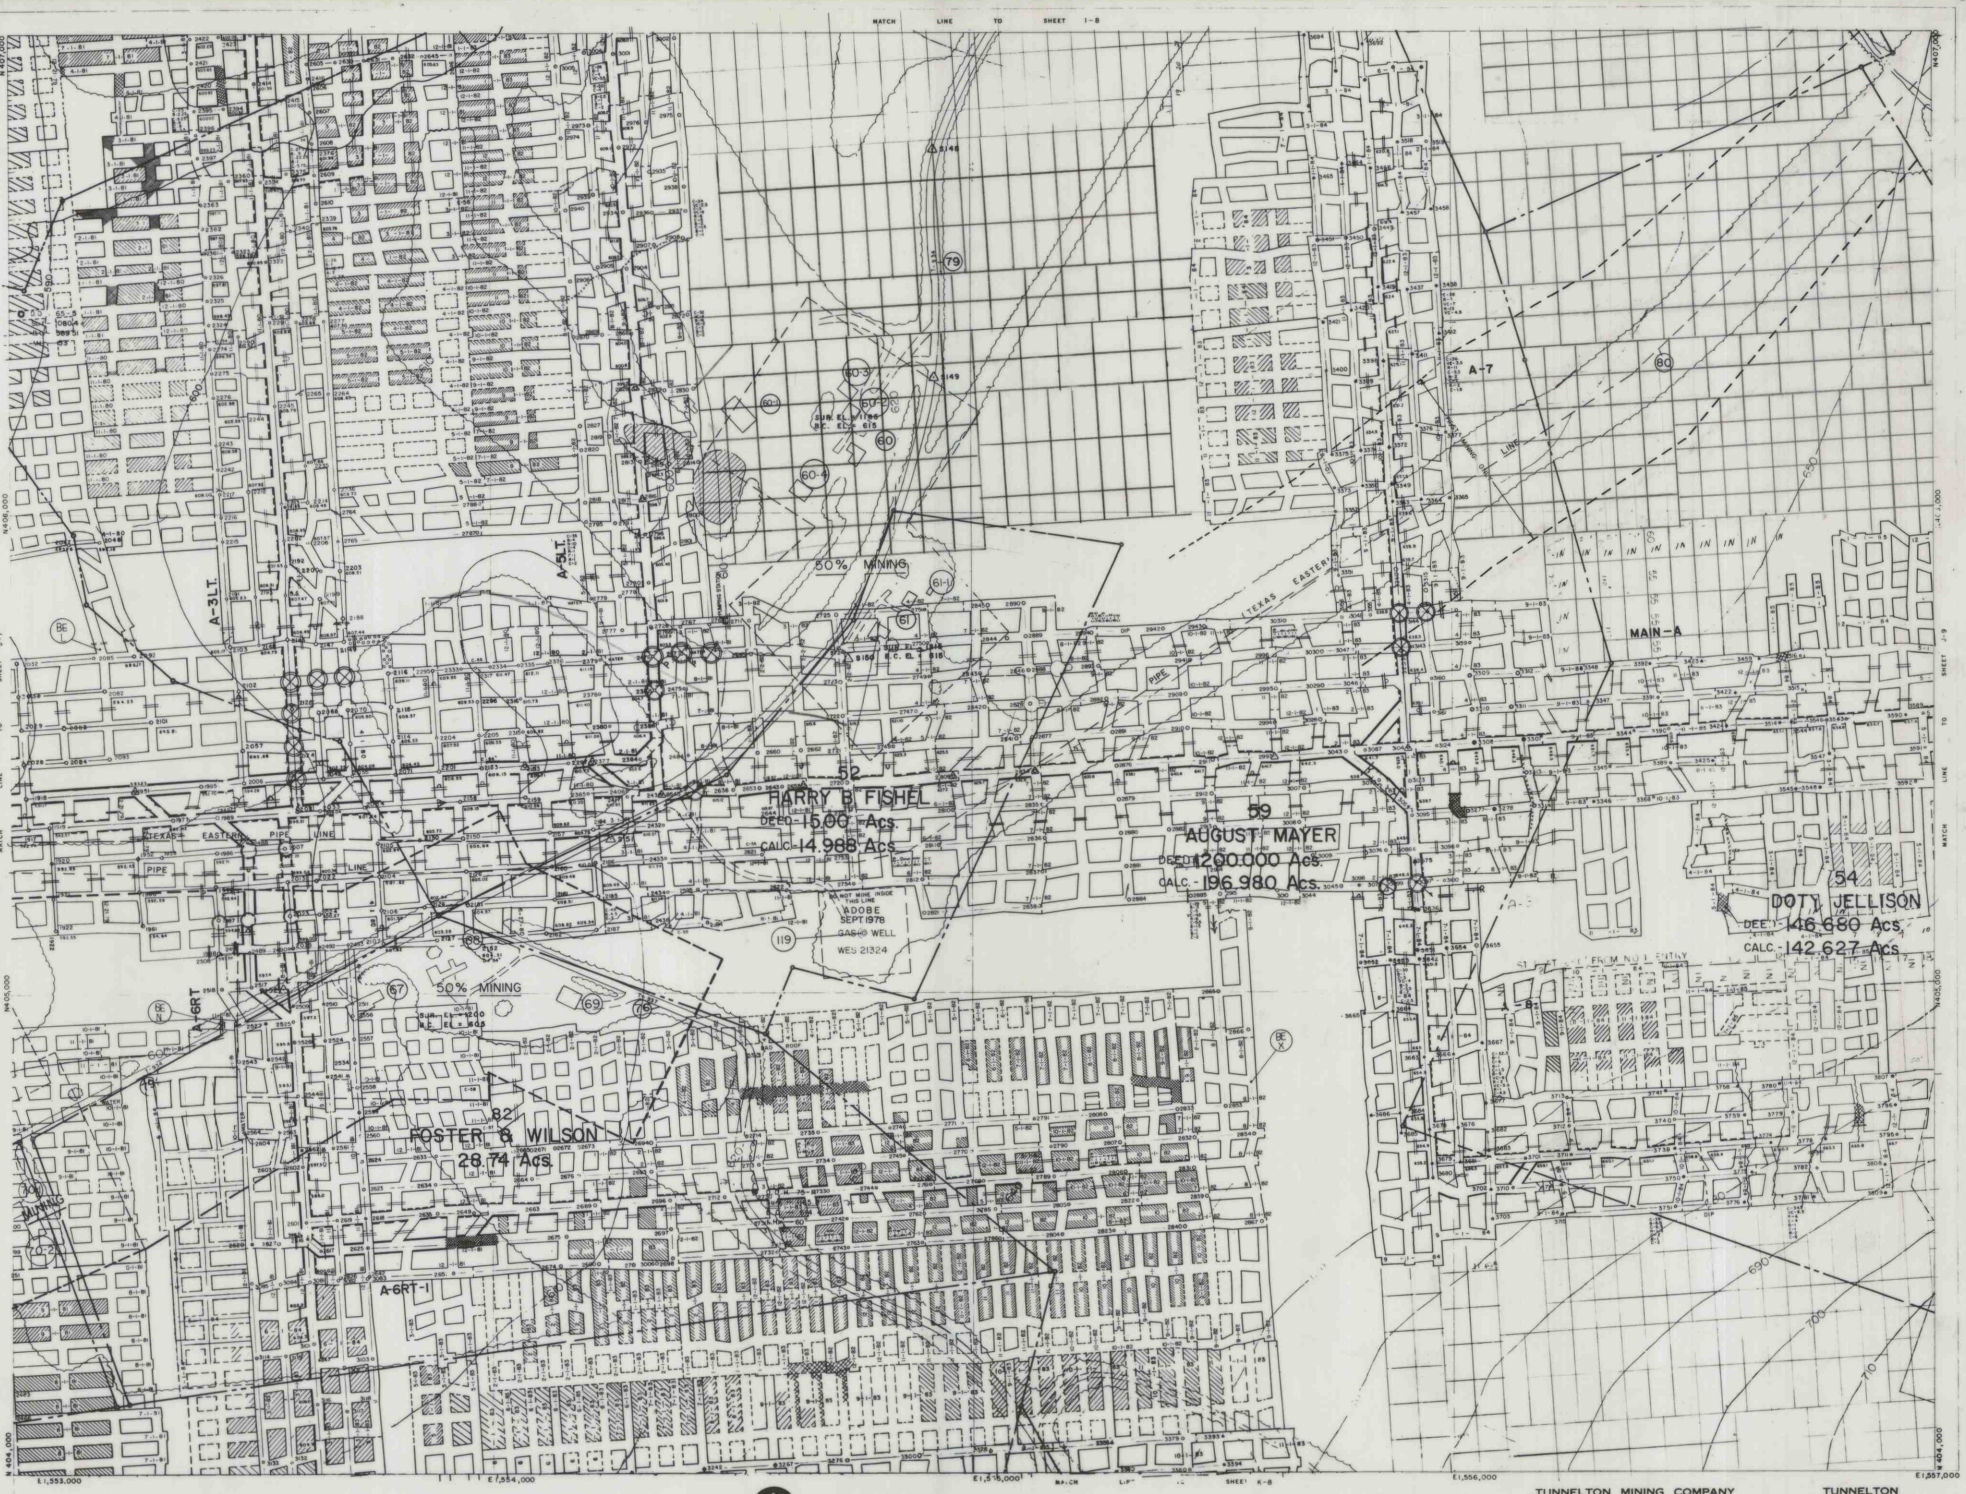

TUNNELTON MINING COMPANY
MARION MINE U.S.B.M. NO. 36 00929
LOCATION CONEMAUGH TWP. INDIANA CO., PA.
ADDRESS , BOX 327 EBENSBURG, PA. 15931

TUNNELTON
MARION MINE
SCALE 1" = 200' SHEET 2-8
INDIANA & WESTMORELAND COUNTIES

1-1-85