


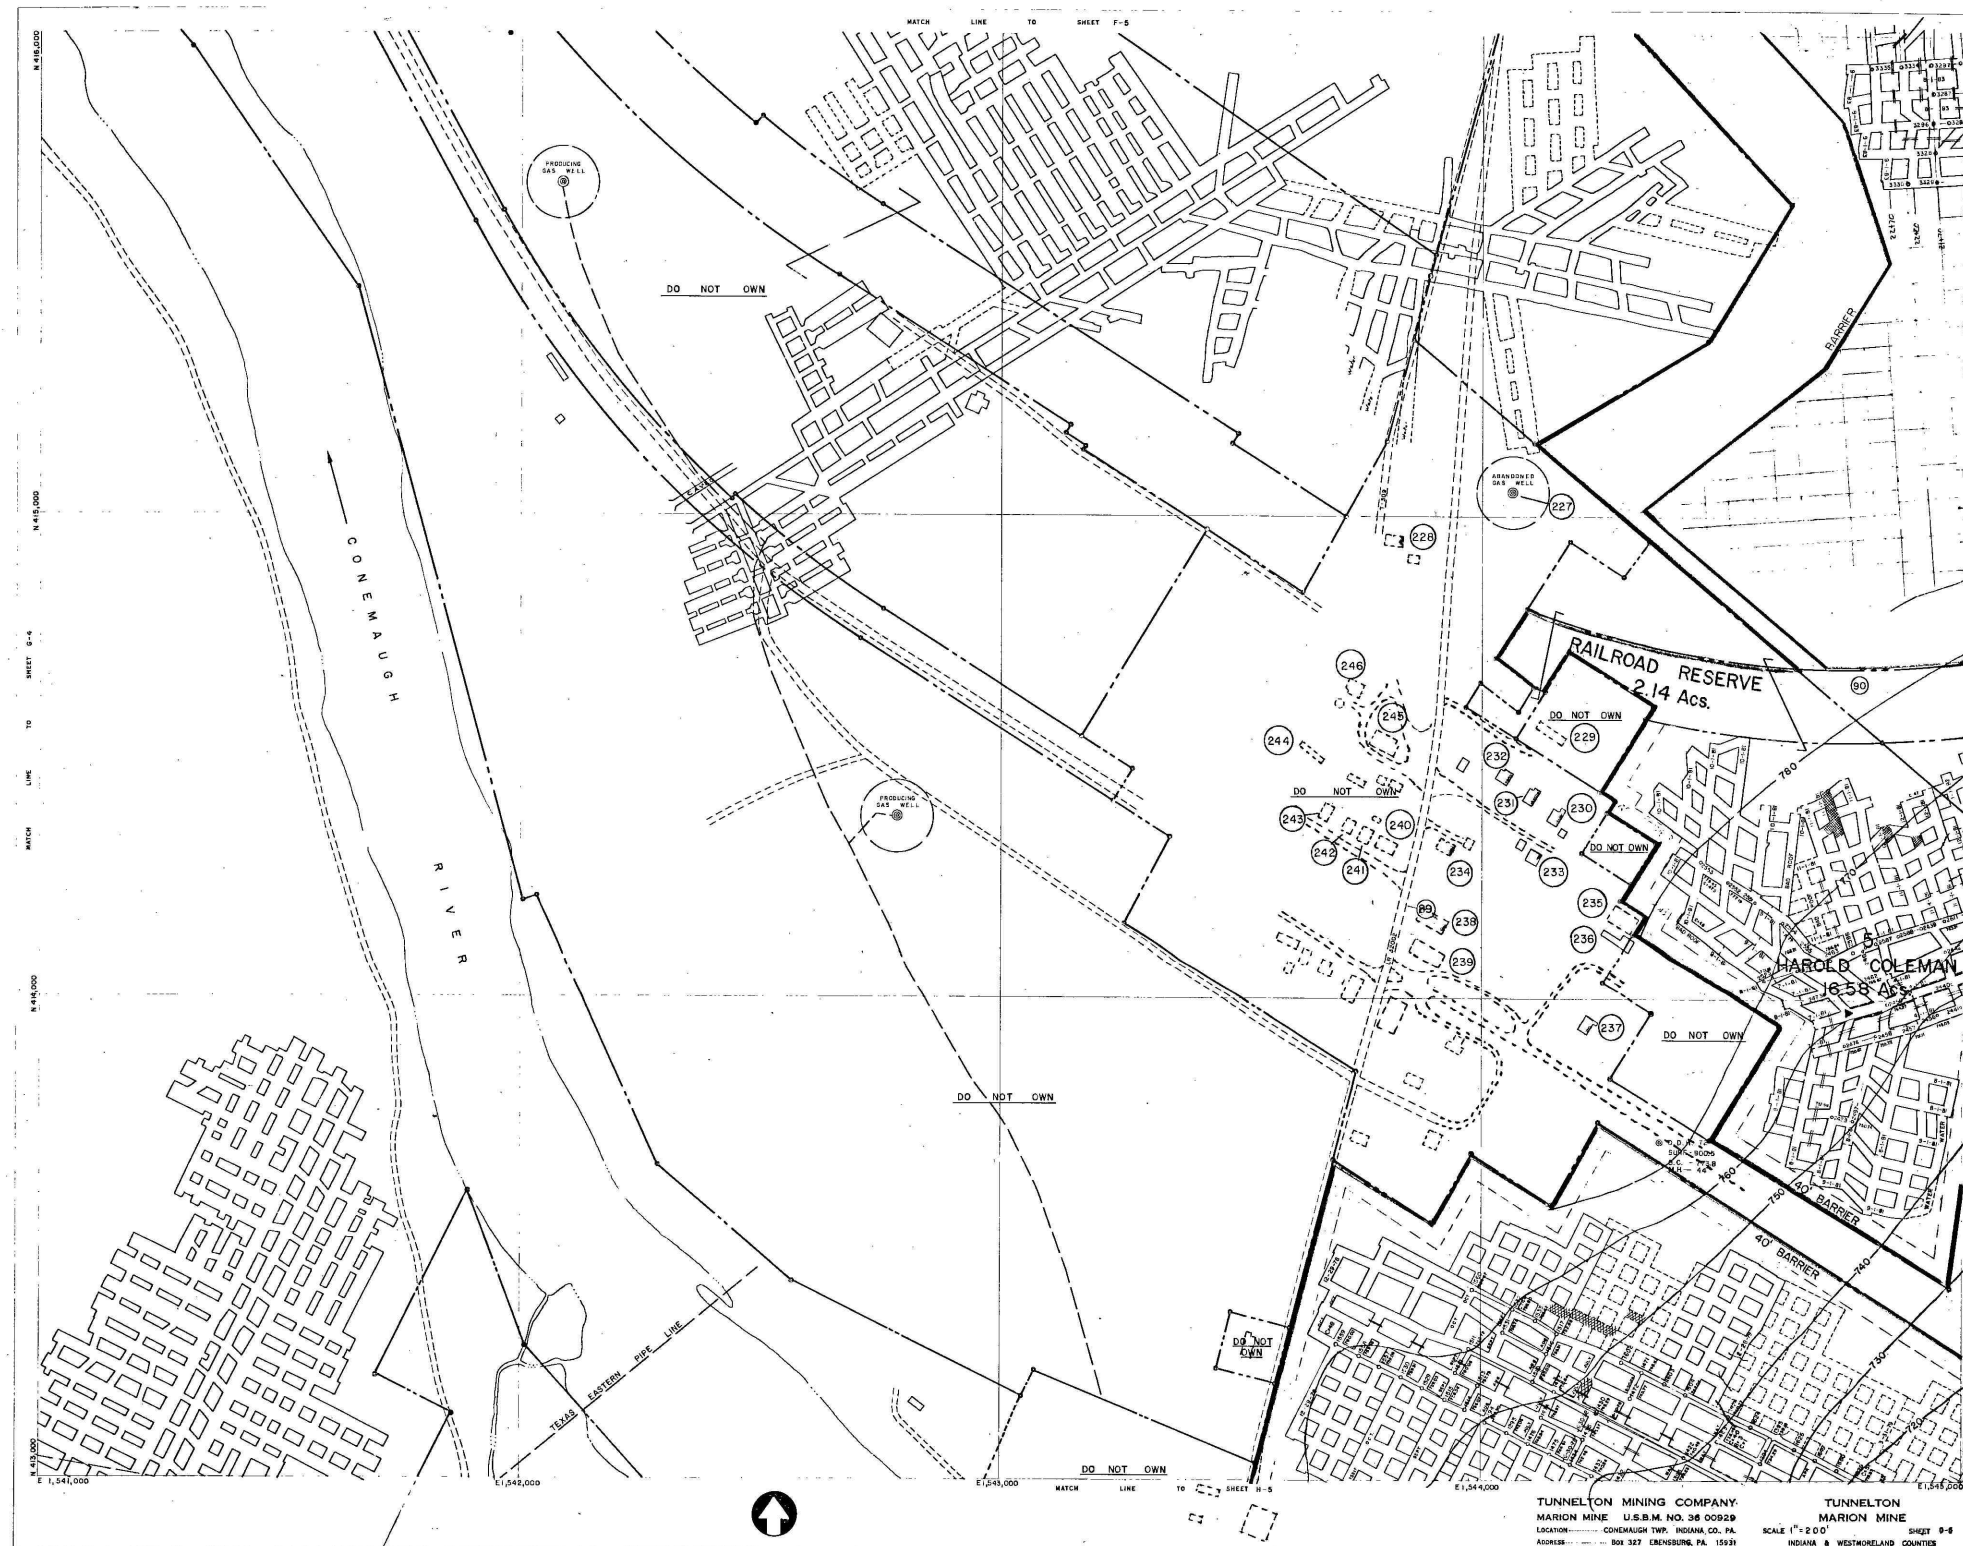


EXHIBIT "A"

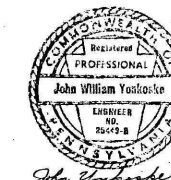

TUNNELTON MINING CO.
MARION MINE
DIV. OF PENNSYLVANIA MINES CORP.
 UPPER FREEPORT "E" SEAM
 CONEMAUGH TWP. INDIANA CO., PA.
 DERRY & LOYALHANNA TWPS. WESTMORELAND CO., PA.
 SCALE 1"=200'

DWELLINGS & CEMETERIES (IN PLACE BEFORE 1966 ACT) 
 PUBLIC BUILDINGS 
 BOUNDARY OF MINE 
 POLITICAL SUBDIVISION BOUNDARIES 
 FIVE YEAR MINE OUTLINE 
 OUTCROP OF "E" SEAM (N/A) 
 FEATURE IDENTIFICATION NO. 
 PERIOD COVERED 6-1-84 TO 6-1-89