


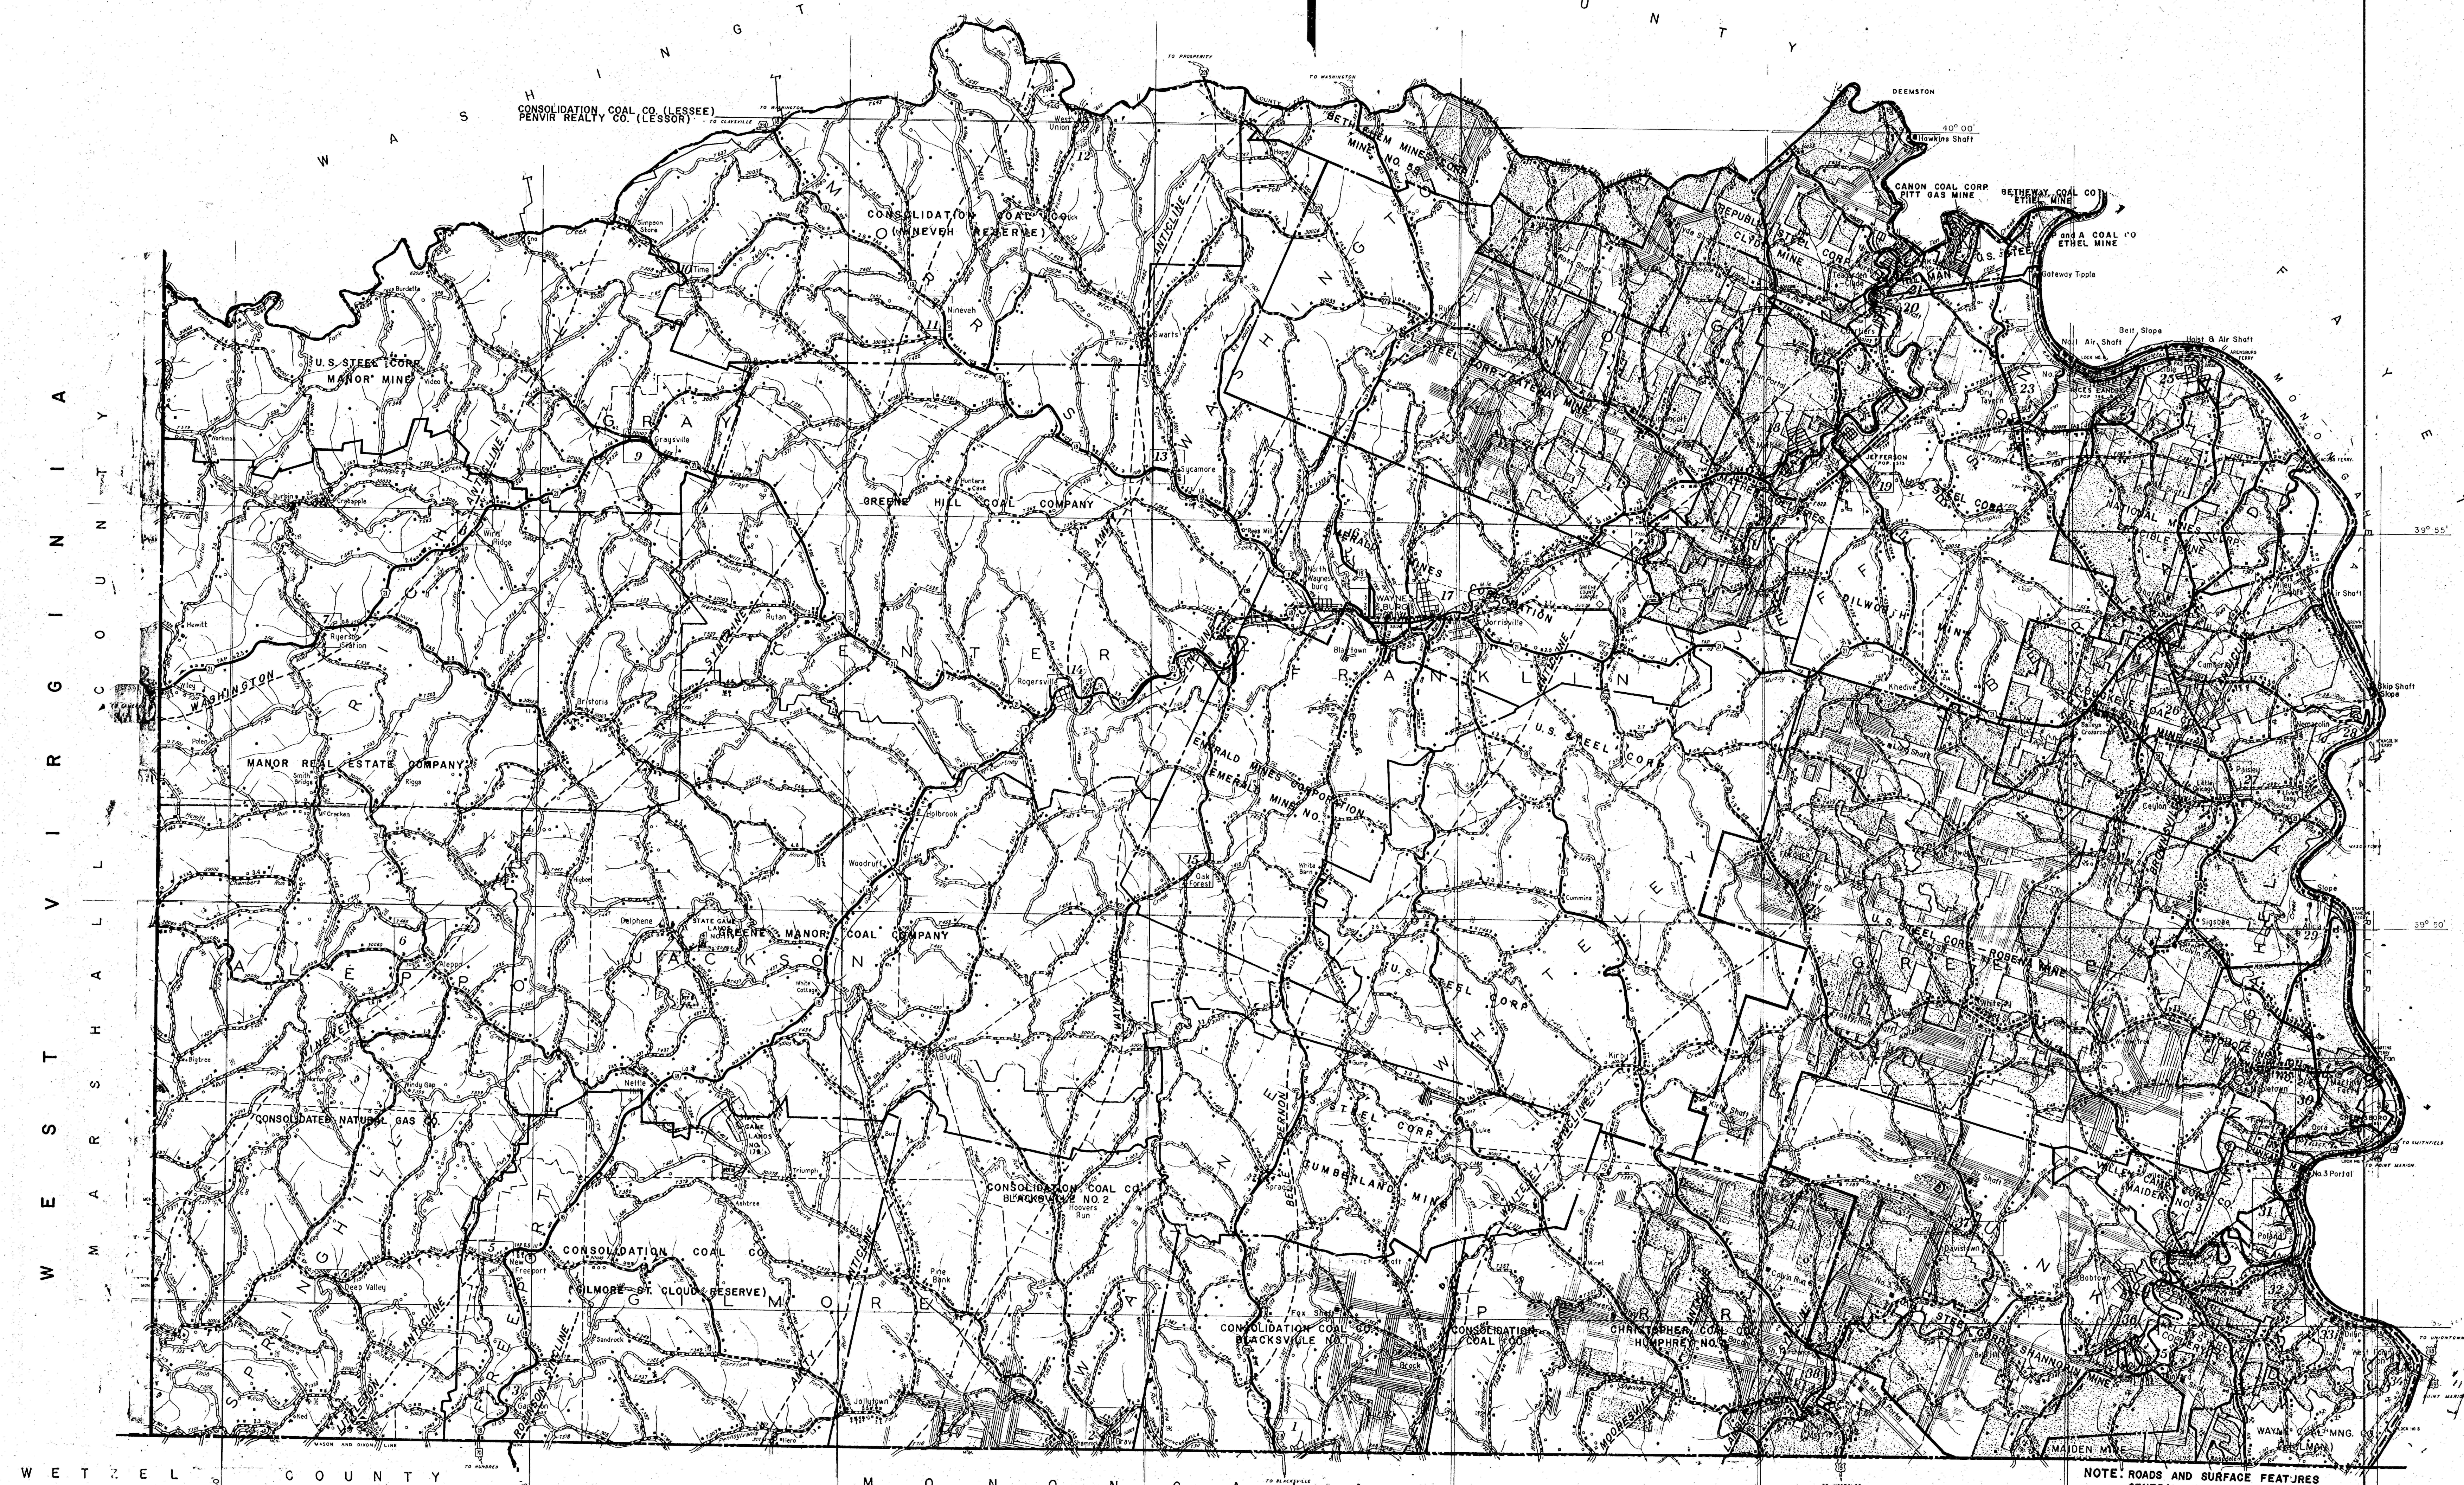

COMMONWEALTH OF PENNSYLVANIA
 DEPARTMENT OF ENVIRONMENTAL RESOURCES
 BUREAU OF LAND PROTECTION
 DIVISION OF MINE SUBSIDENCE REGULATION
 MINE MAP
 OF
 GREENE COUNTY, PA.

JANUARY-1970

SCALE
 1" = 1 MILE

MINING COMPLETED AREAS
 PITTSBURGH COAL SEAM

REVISED: MARCH 1978

NOTE: ROADS AND SURFACE FEATURES
 GENERAL HIGHWAY MAP, 1963