


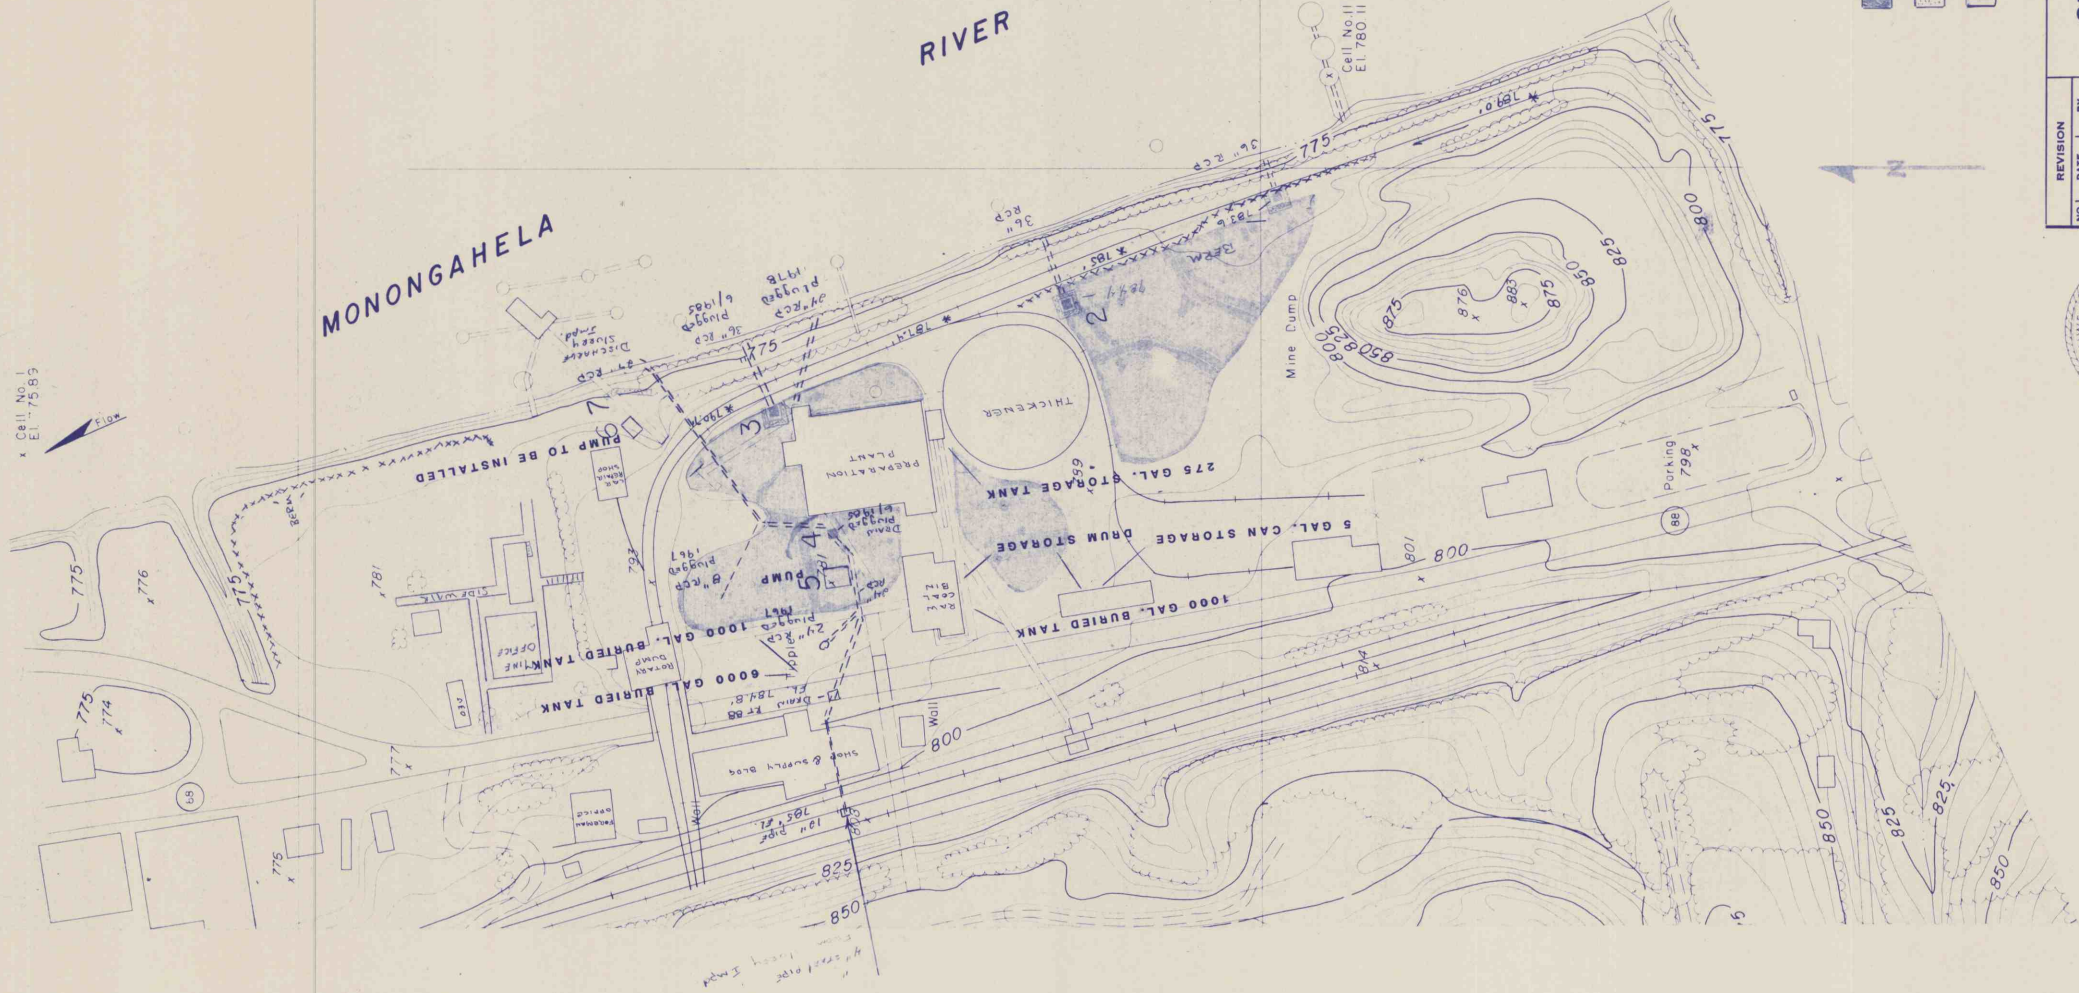

KEY

- SURFACE DRAIN
- FILTER STRUCTURE
- FLOODED AREA

EXHIBIT A

CLYDE MINE PLANT AREA

WORKS
DEPARTMENT SITE LAYOUT

REVISION	NO.	DATE	BY



LOCATIONS 5 & 6 PUMP TO PREP PLANT

SCALE 1/4" = 100' 11"
DRAWN DATE
CHECKED DATE
DESIGNED DATE
APPROVED DATE