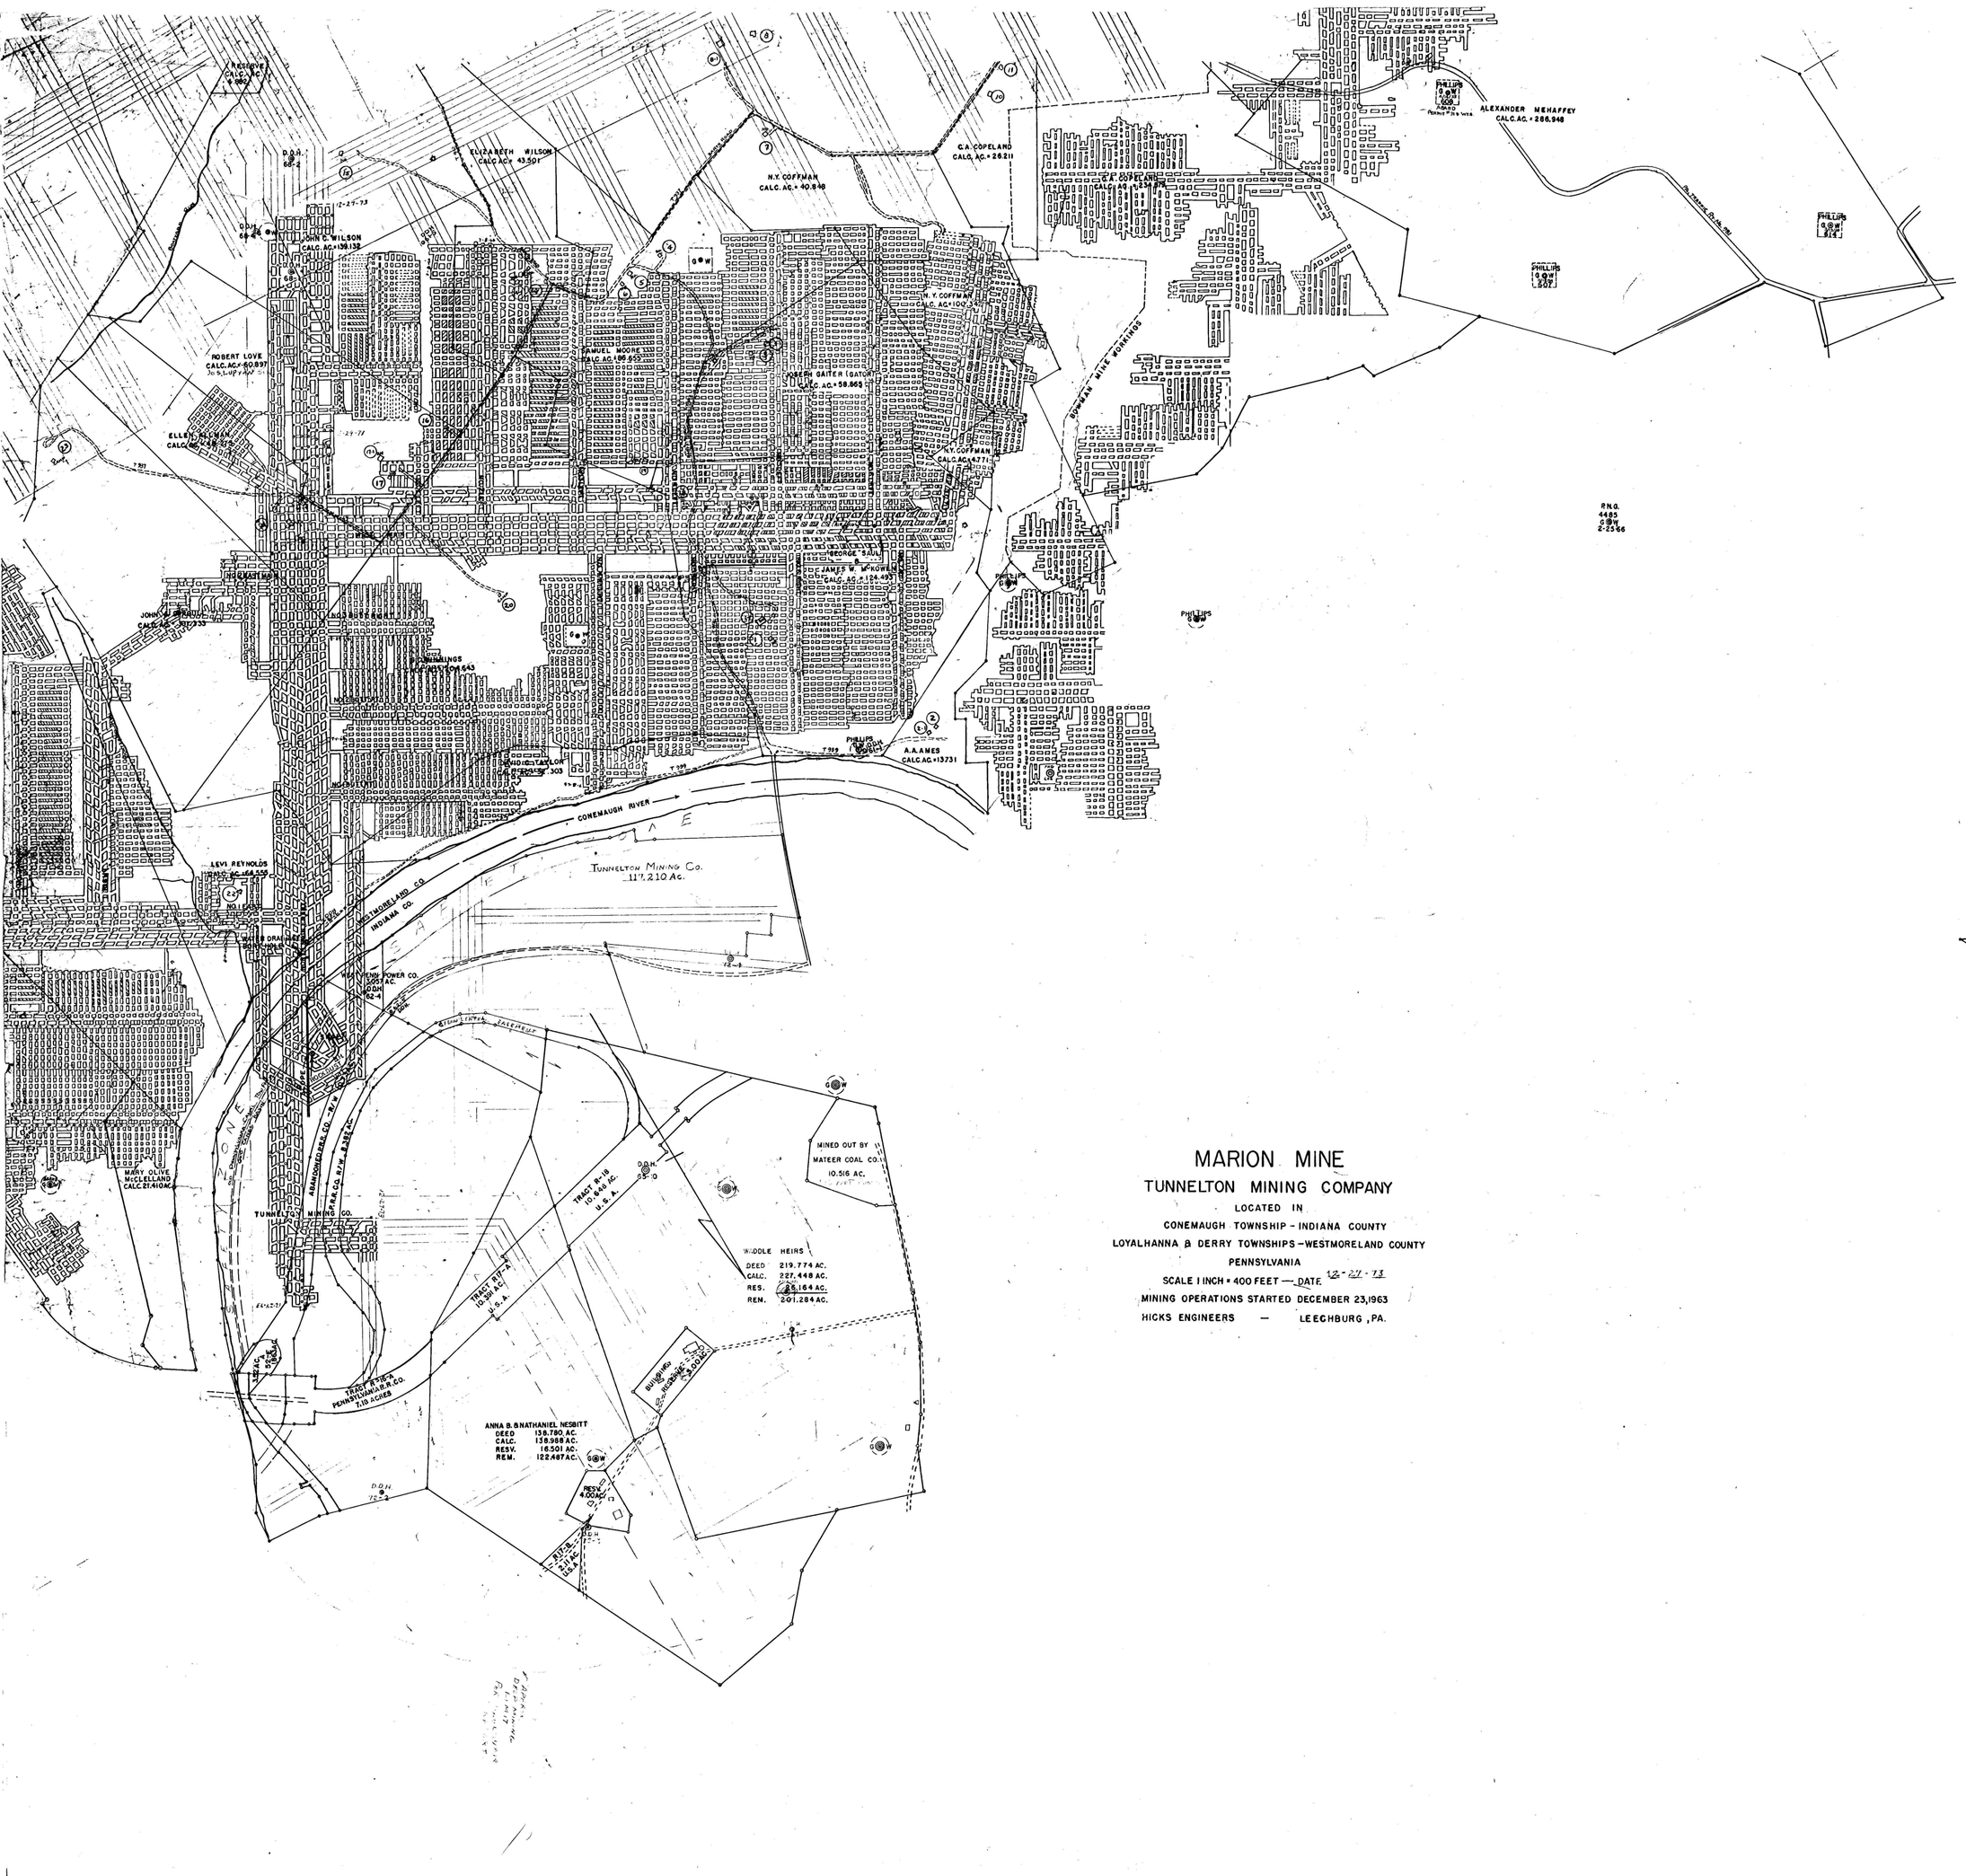

MARION MINE

TUNNELTON MINING COMPANY

LOCATED IN

CONEMAUGH TOWNSHIP - INDIANA COUNTY

LOYALHANNA & DERRY TOWNSHIPS - WESTMORELAND COUNTY

PENNSYLVANIA

SCALE 1 INCH = 400 FEET — DATE 12-27-73

MINING OPERATIONS STARTED DECEMBER 23, 1963

HICKS ENGINEERS — LEECHBURG, PA.