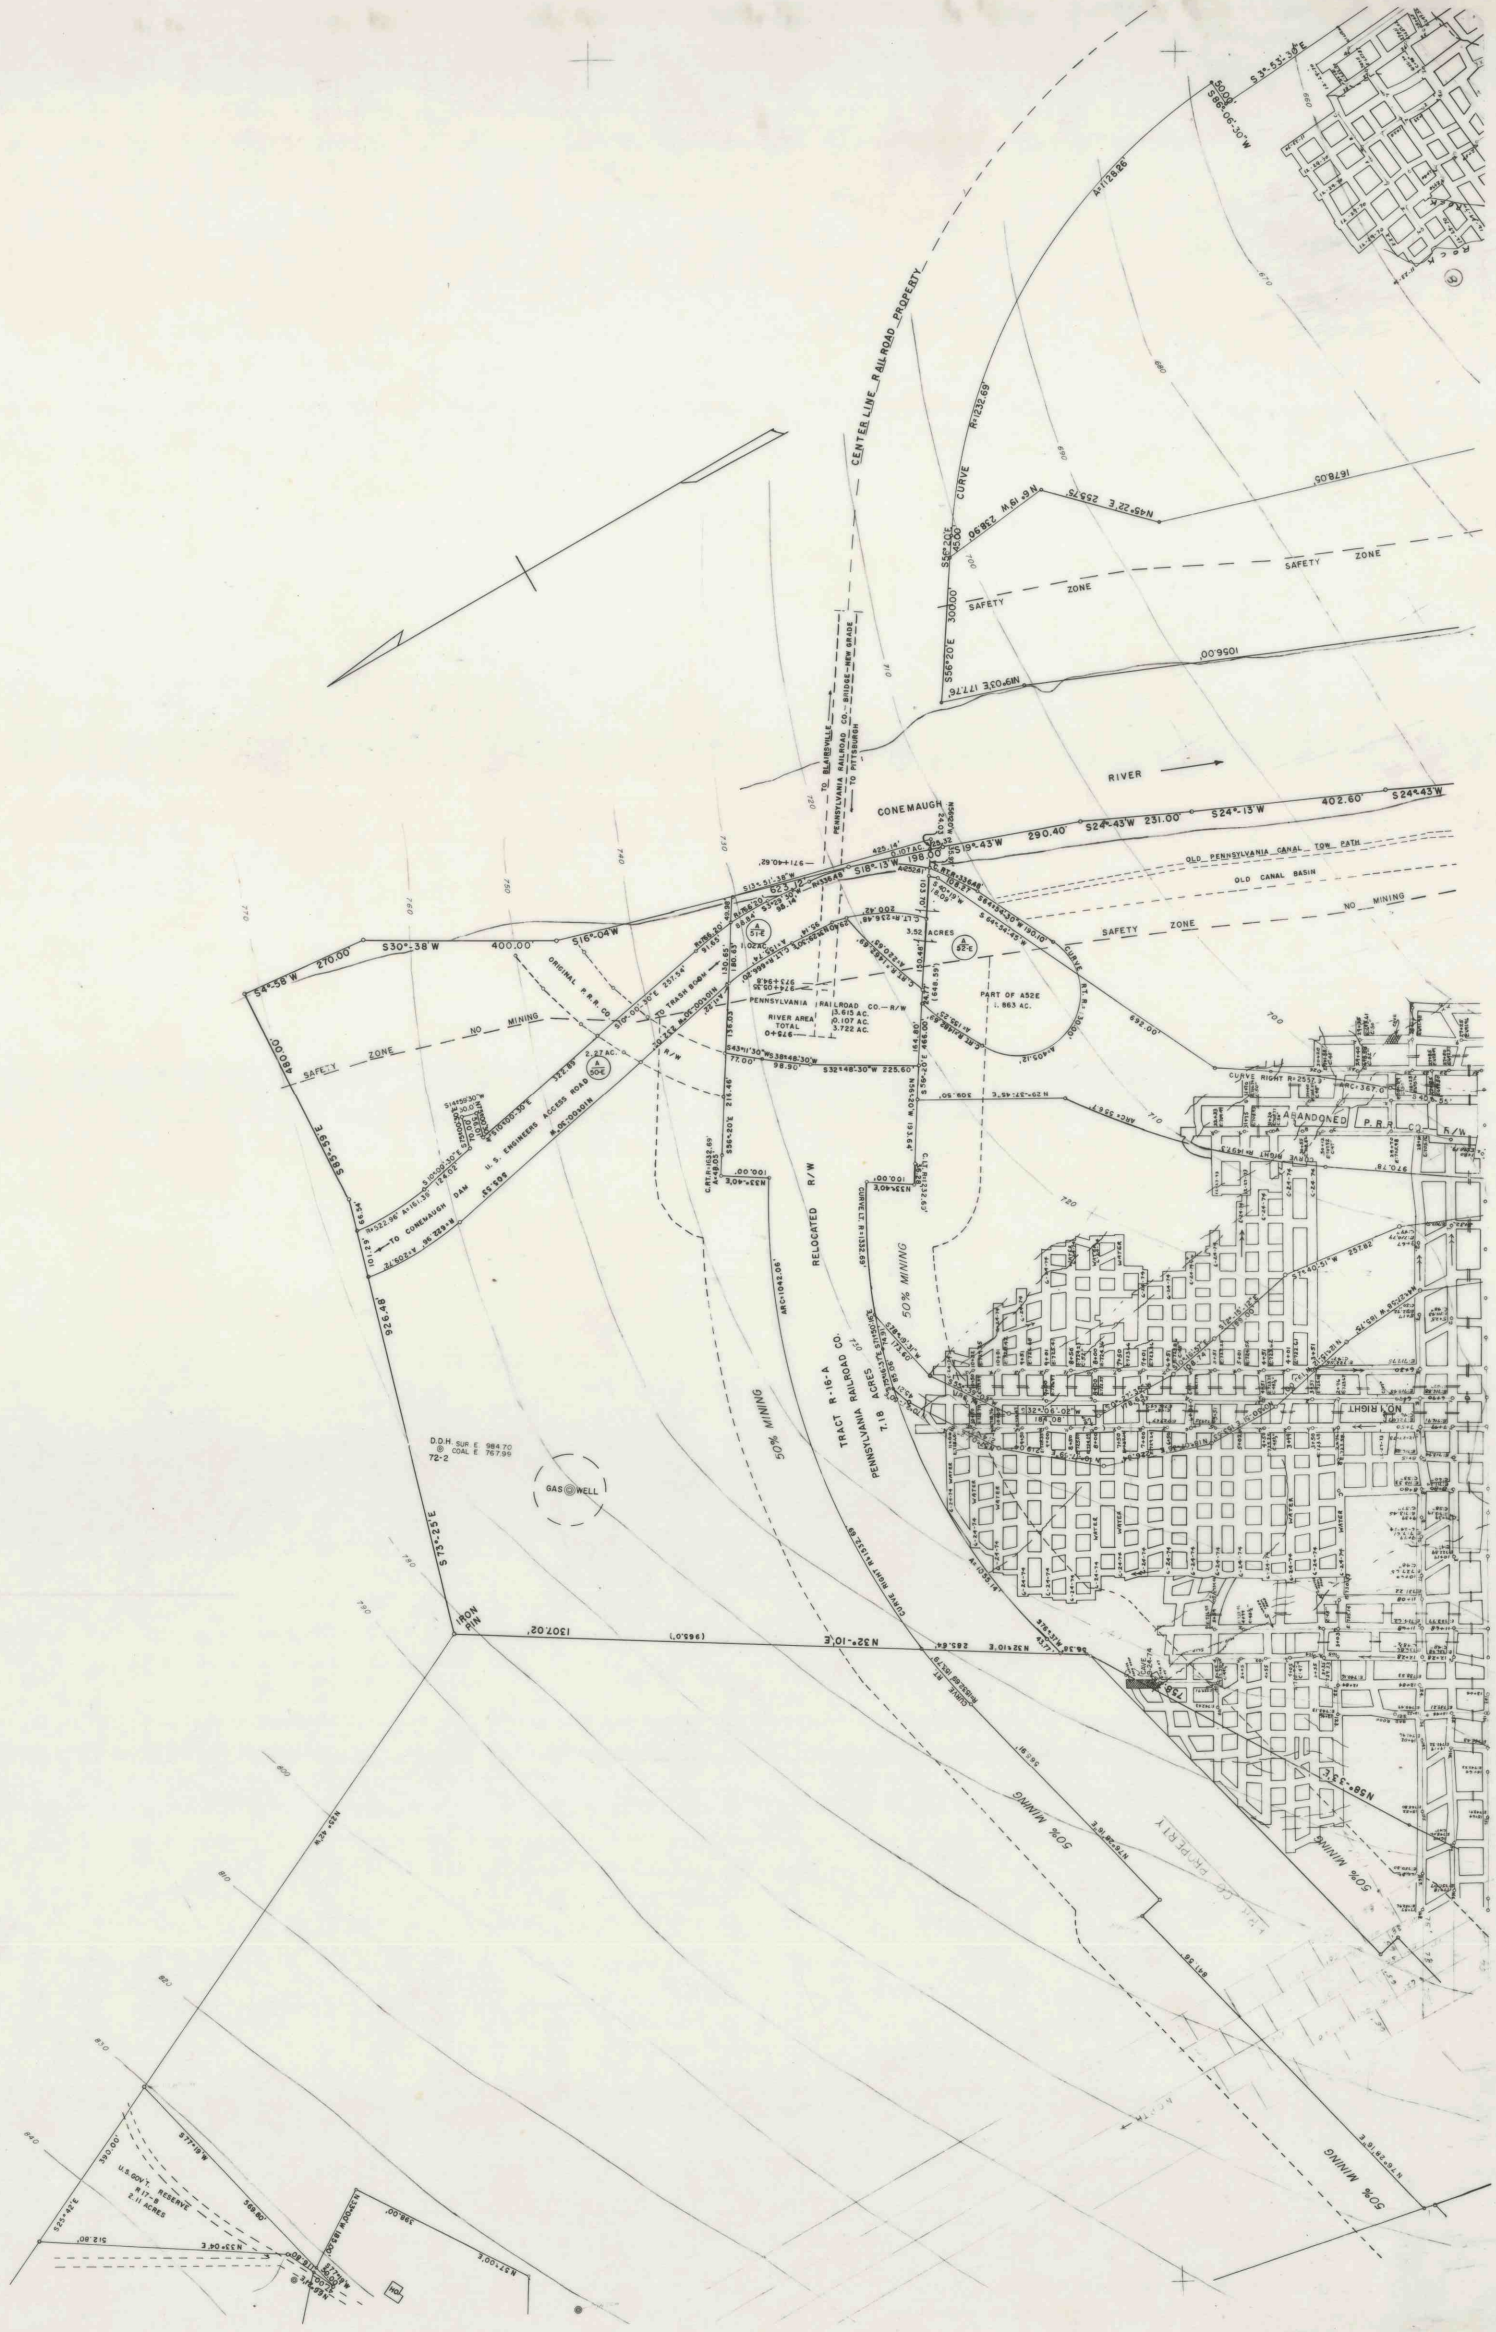
CENTER LINE RAILROAD PROPERTY
CURVE
SAFETY ZONE
RIVER
CONEMAUGH
OLD PENNSYLVANIA CANAL TOW PATH
OLD CANAL BASIN
NO MINING
PENNSYLVANIA RAILROAD CO. R/W
RIVER AREA TOTAL
PART OF A52E
ORIGINAL P.R.R. CO.
TO TRASH RIDGE
U. S. ENGINEERS ACCESS ROAD
TO CONEMAUGH DAM
RELOCATED R/W
50% MINING
TRACT R-16-A
PENNSYLVANIA RAILROAD CO.
7.18 ACRES
D.D.H. SUR E 984.70
COAL E 767.99
72-2
GAS WELL
IRON PIN
ABANDONED P.R.R. CO. R/W
NO RIGHT
U.S. GOV'T. RESERVE
R-17-B
2.11 ACRES
TO BLAIRSVILLE
PENNSYLVANIA RAILROAD CO. BRIDGE NEW GRADE
TO PITTSBURGH

4