


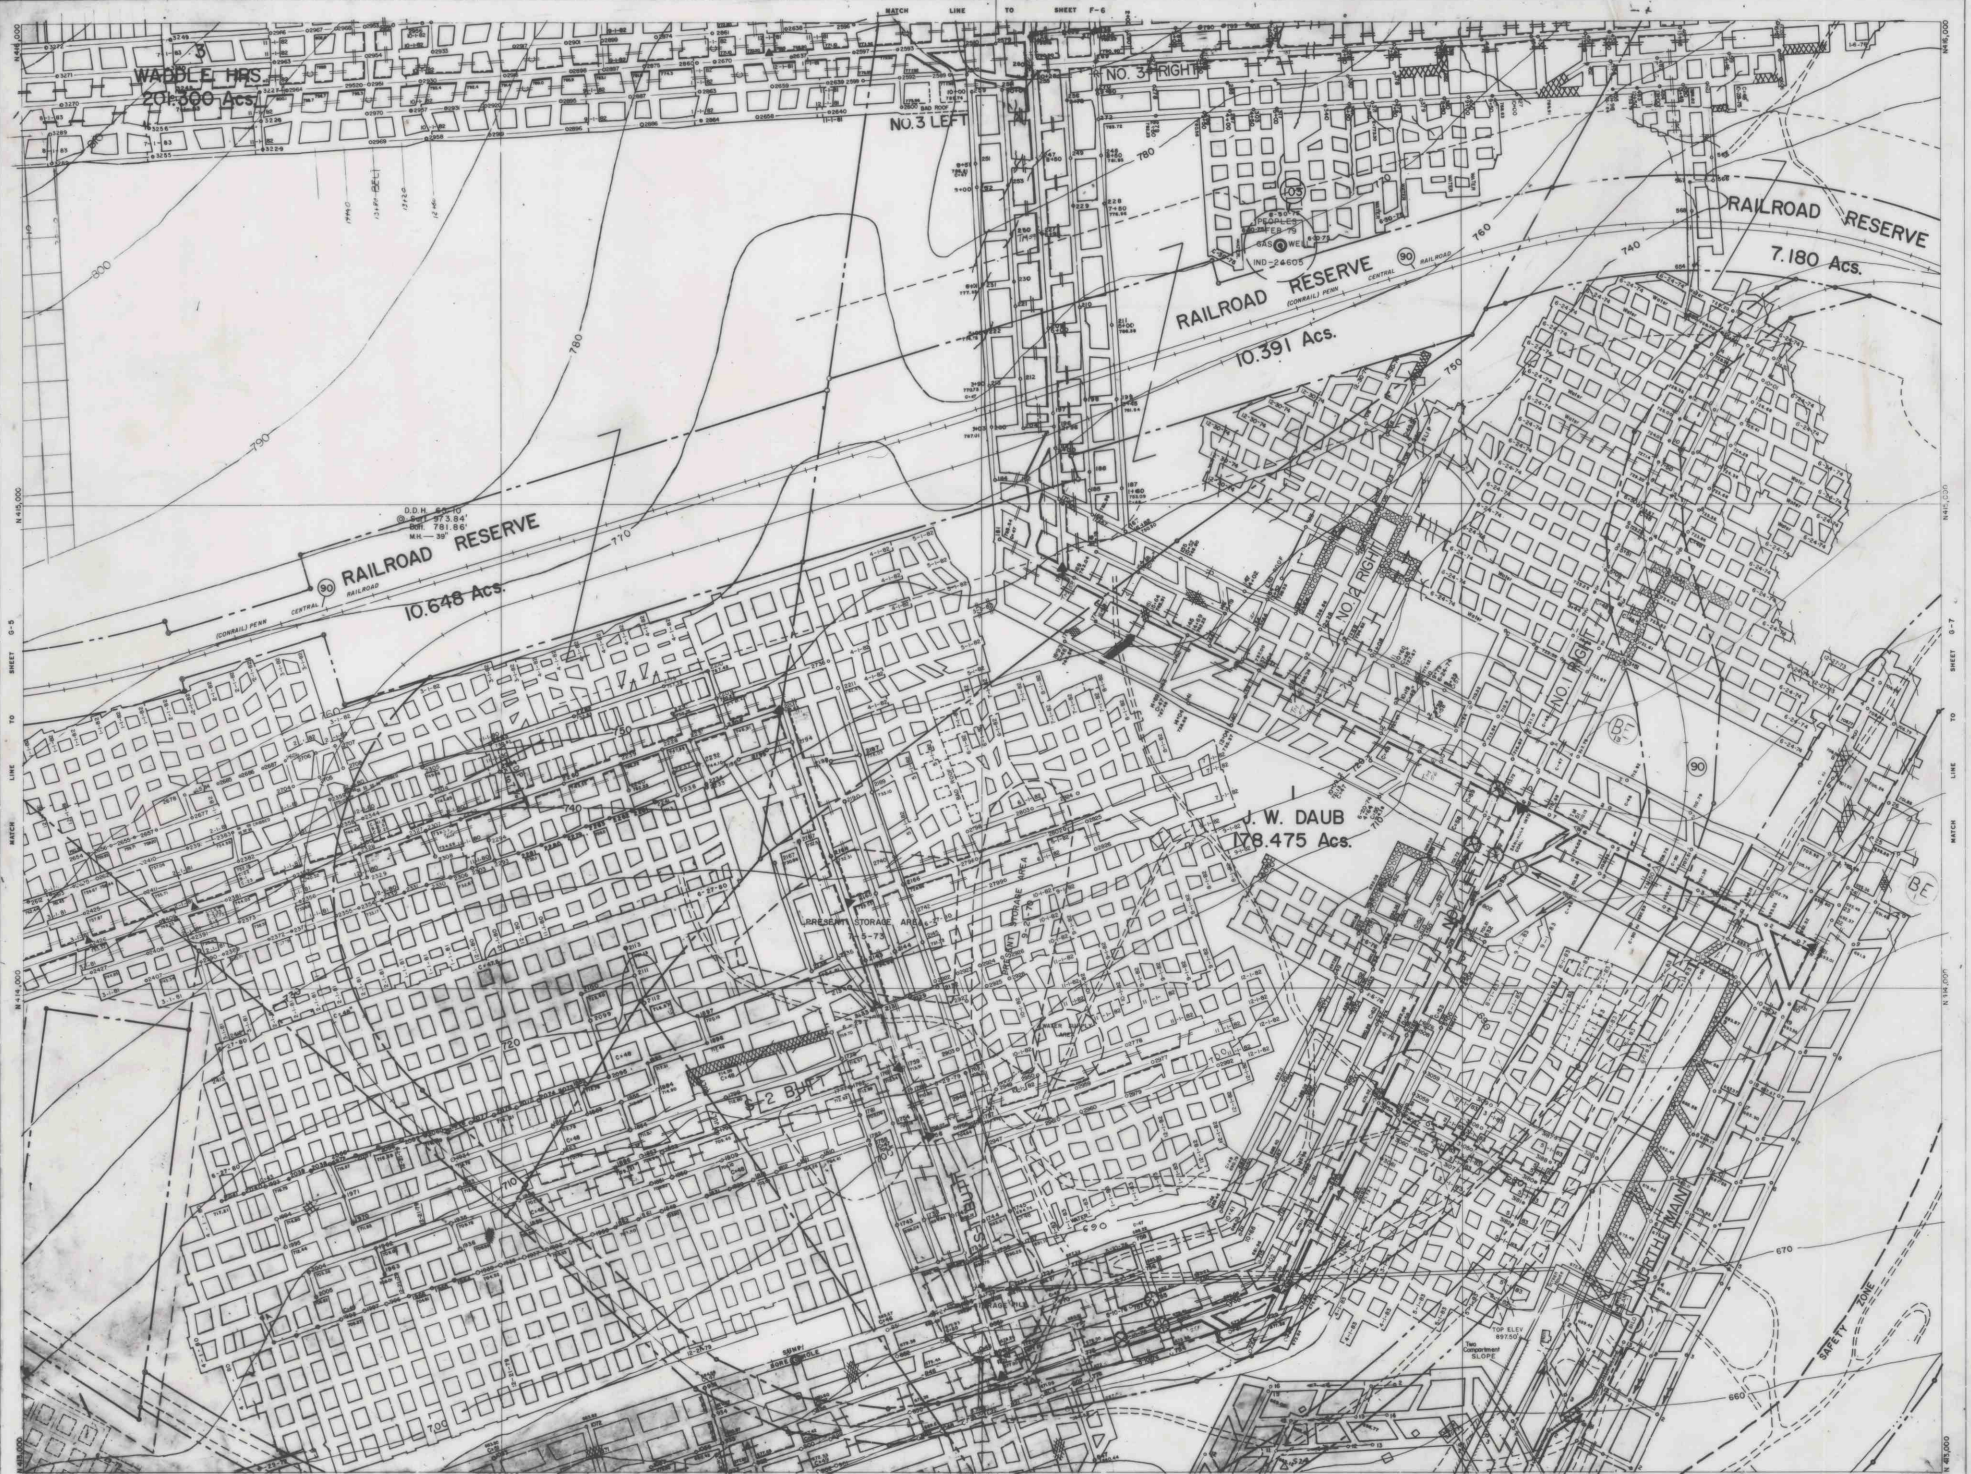

TUNNELTON MINING COMPANY
MARION MINE U.S.B.M. NO. 36 00829
SCALE 1" = 200'
DESIGNED & WESTMORELAND COUNTY