


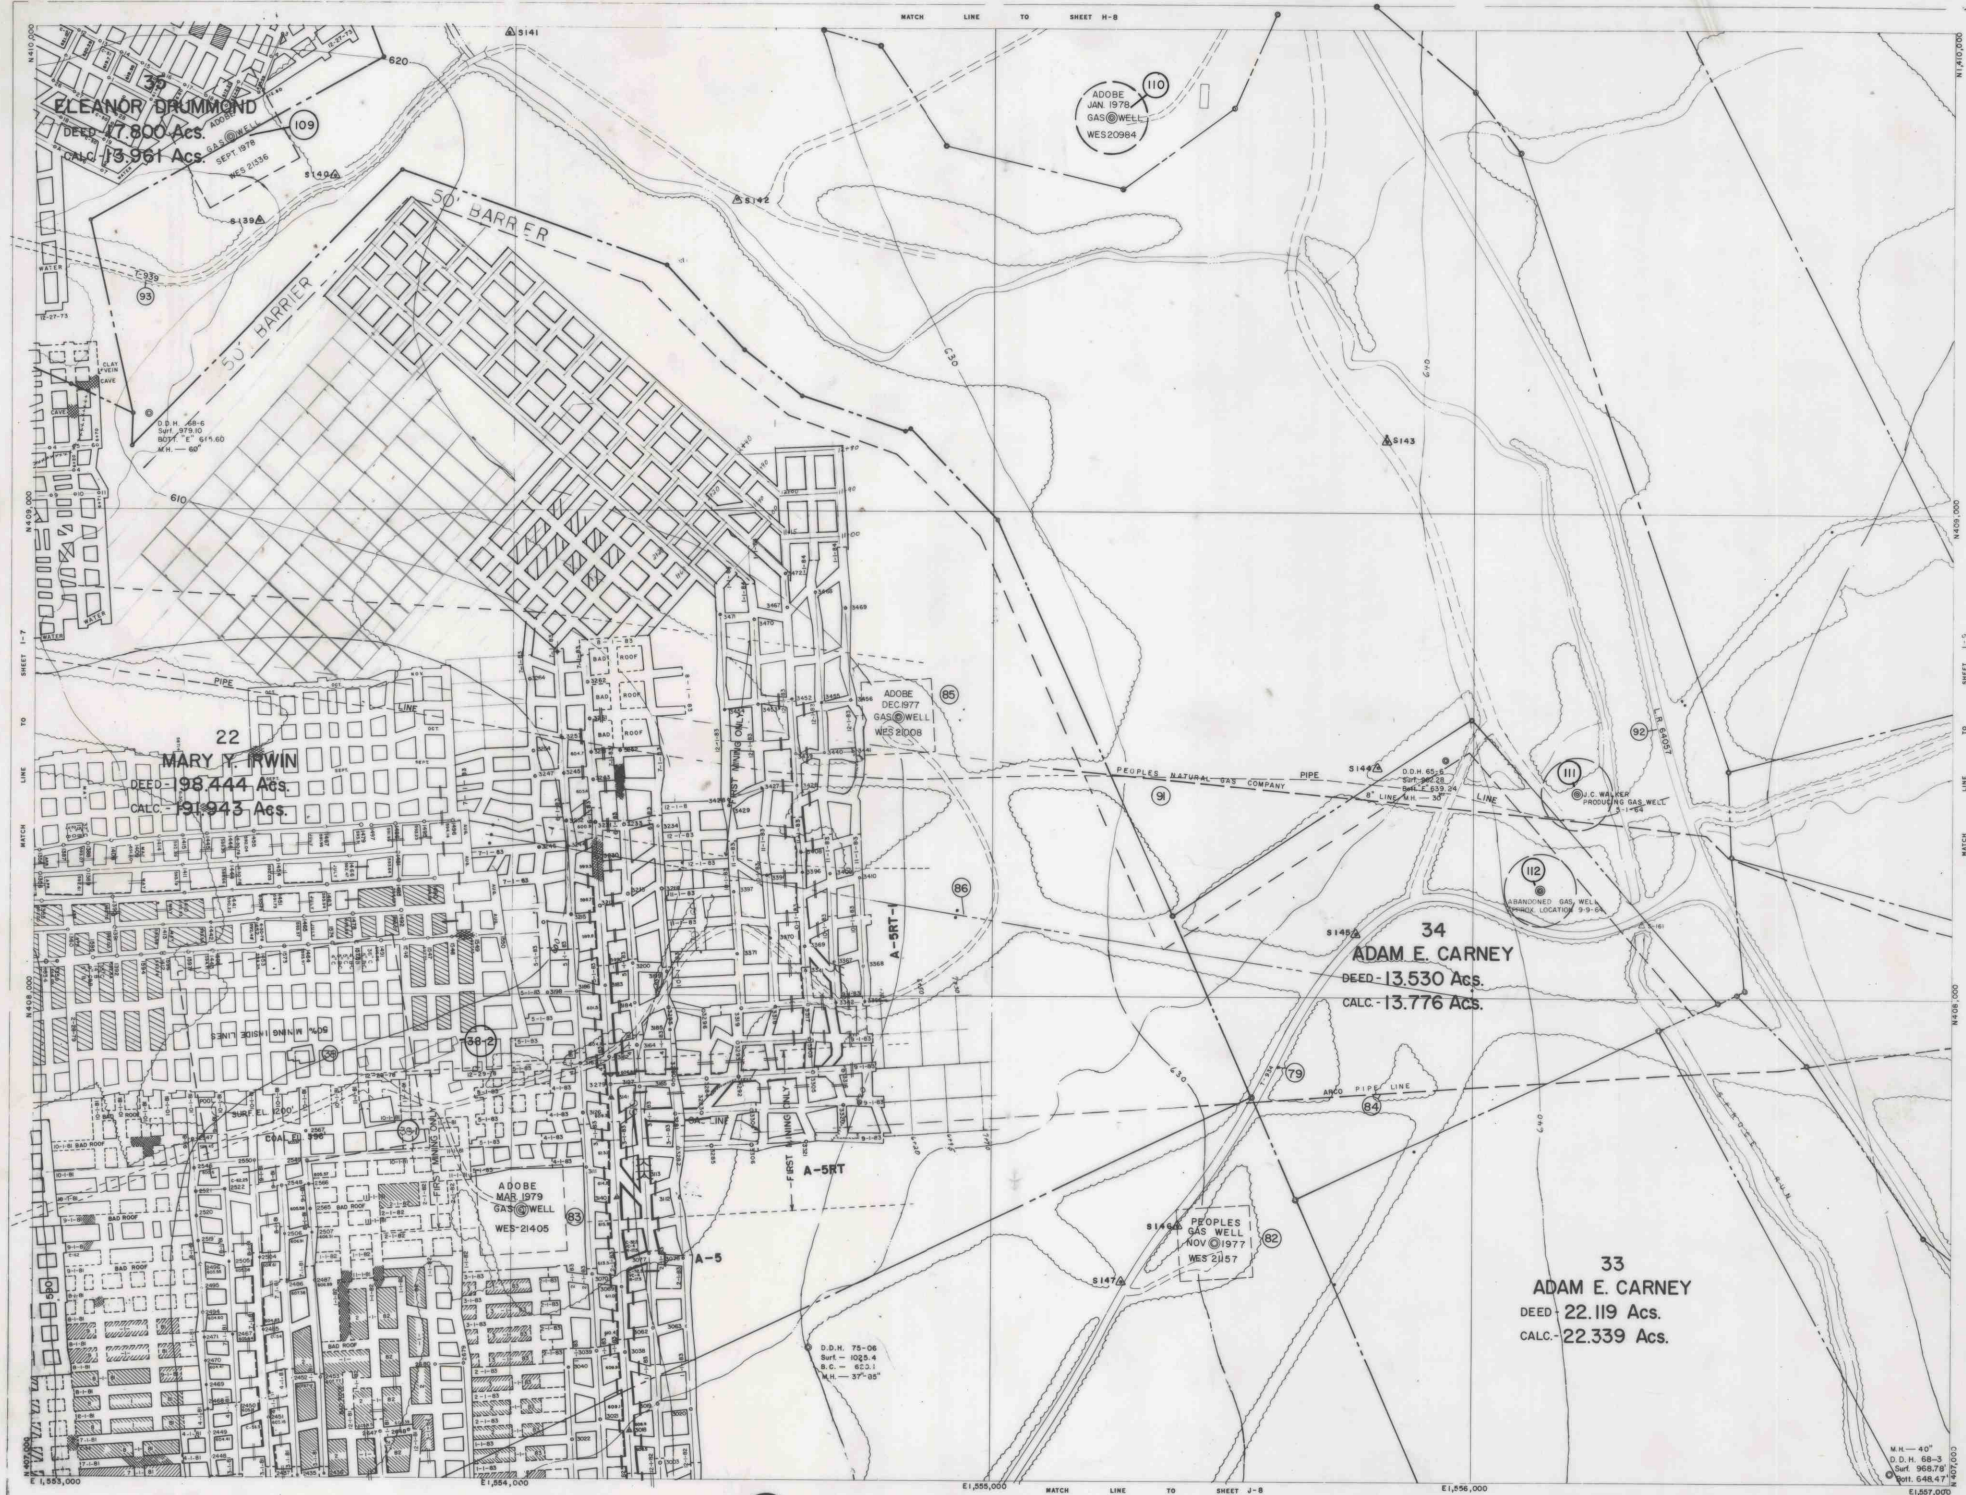

**TUNNELTON MINING COMPANY**  
MARION MINE U.S.B.M. NO. 36 00929  
LOCATION.....CONEMAUGH TWP. INDIANA CO., PA.  
ADDRESS.....Box 327 EBENSBURG, PA. 15931

TUNNELTON  
MARION MINE  
SCALE 1" = 200' SHEET 1-8  
INDIANA & WESTMORELAND COUNTIES