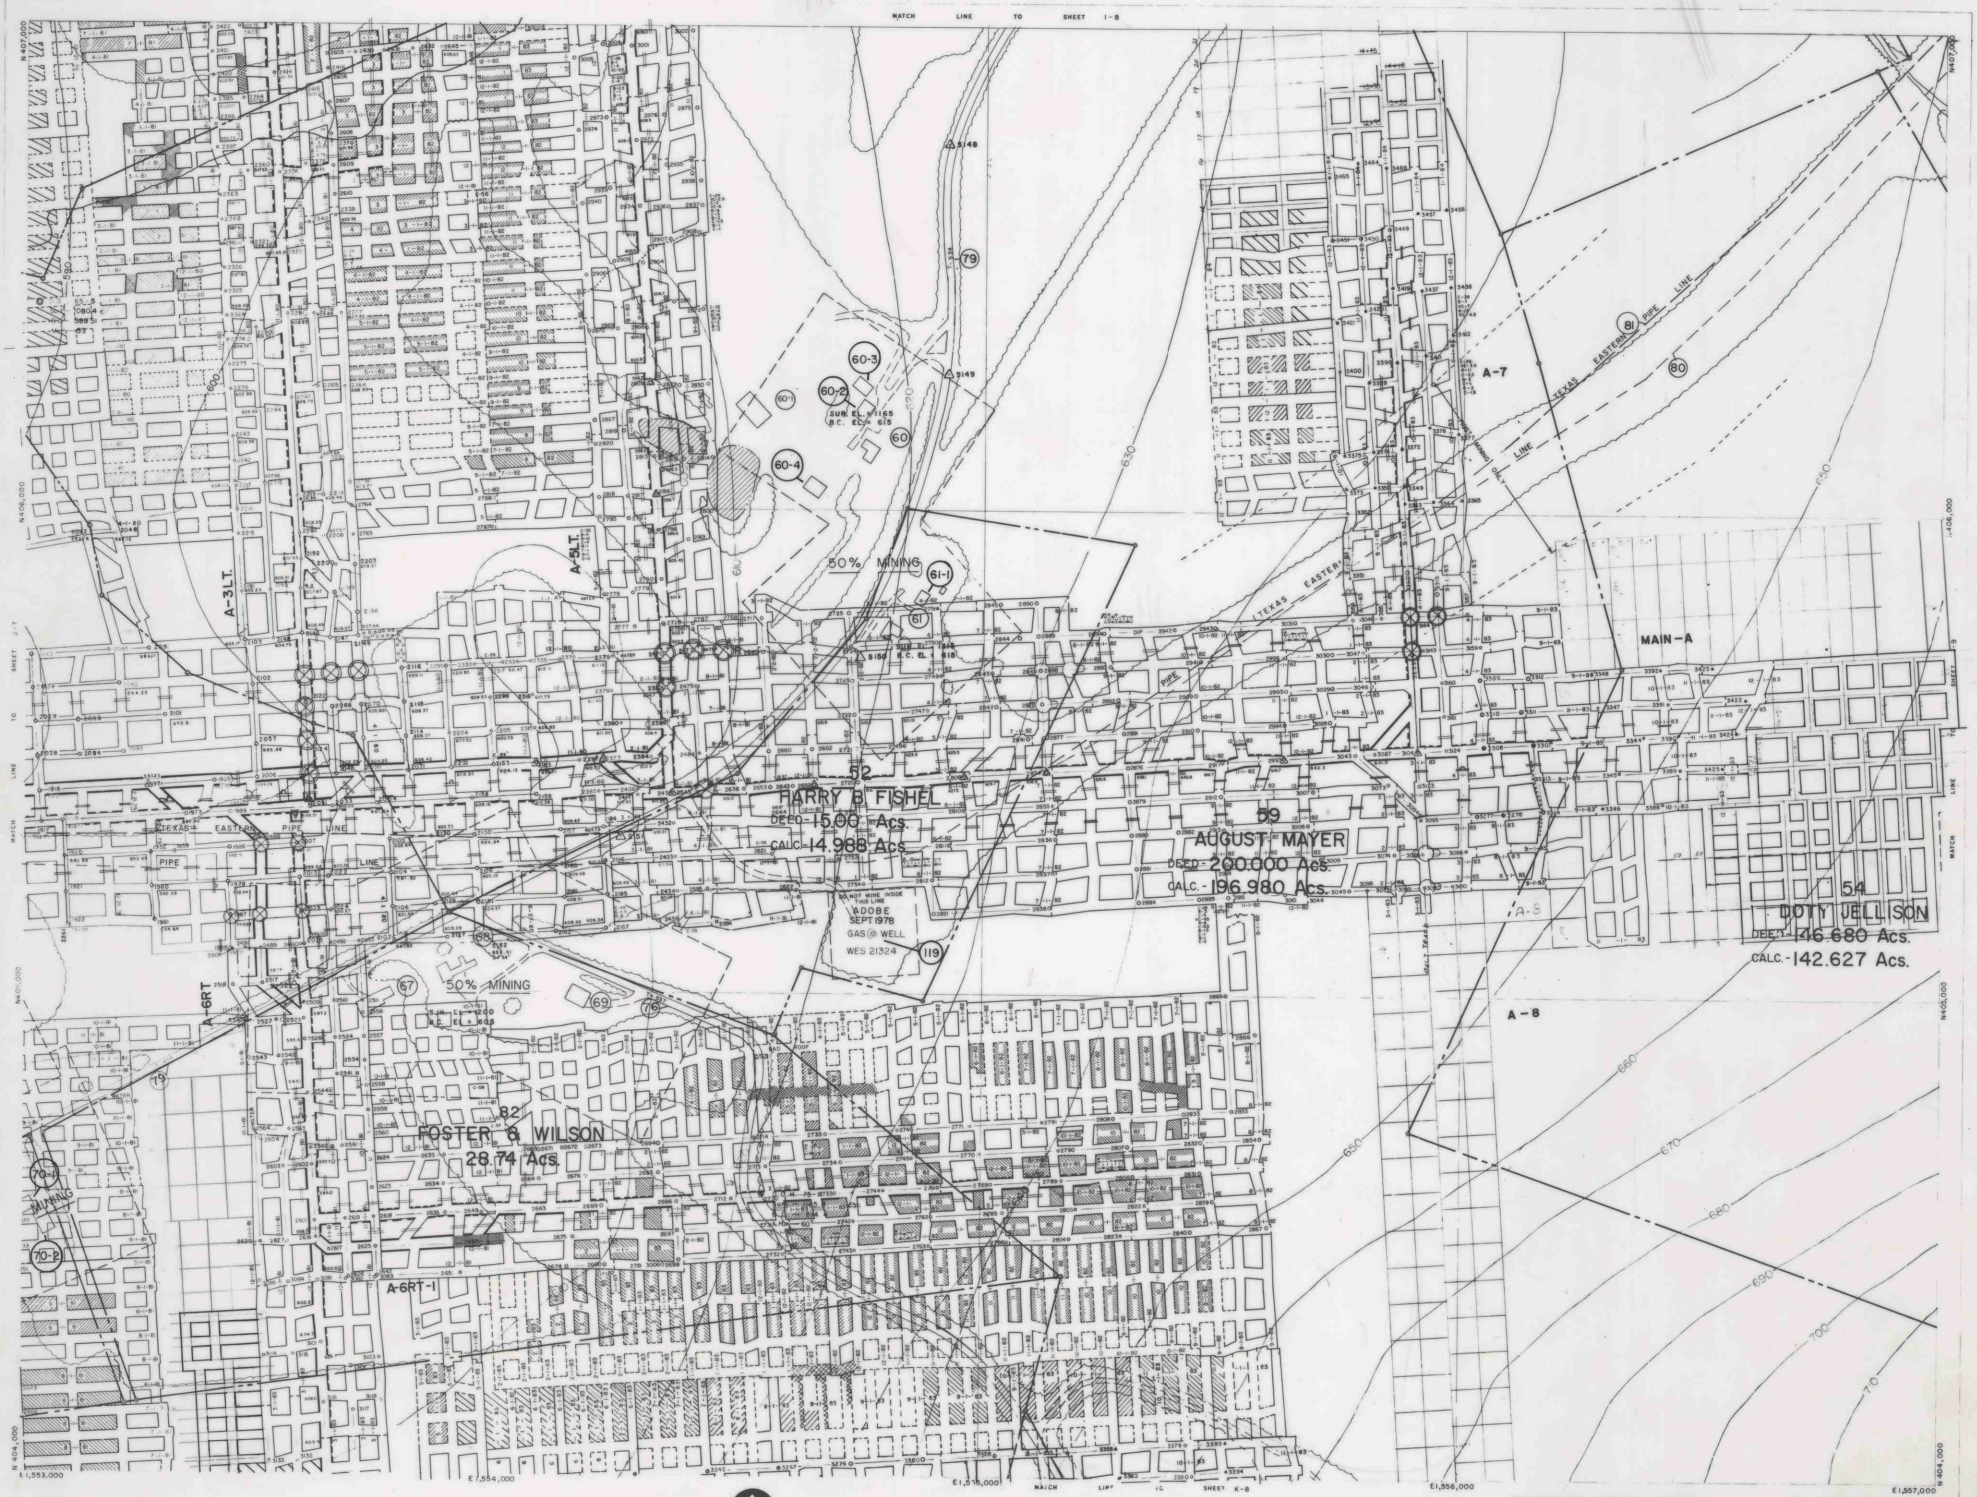

TUNNELTON MINING COMPANY
MARION MINE U.S.B.M. NO. 36 00929
LOCATION ..... CONEMAUGH TWP. INDIANA CO. PA.
ADDRESS ..... Box 327 EBENSBURG, PA. 15931

TUNNELTON
MARION MINE
SHEET J-8
SCALE 1"=200'
INDIANA & WESTMORELAND COUNTIES