


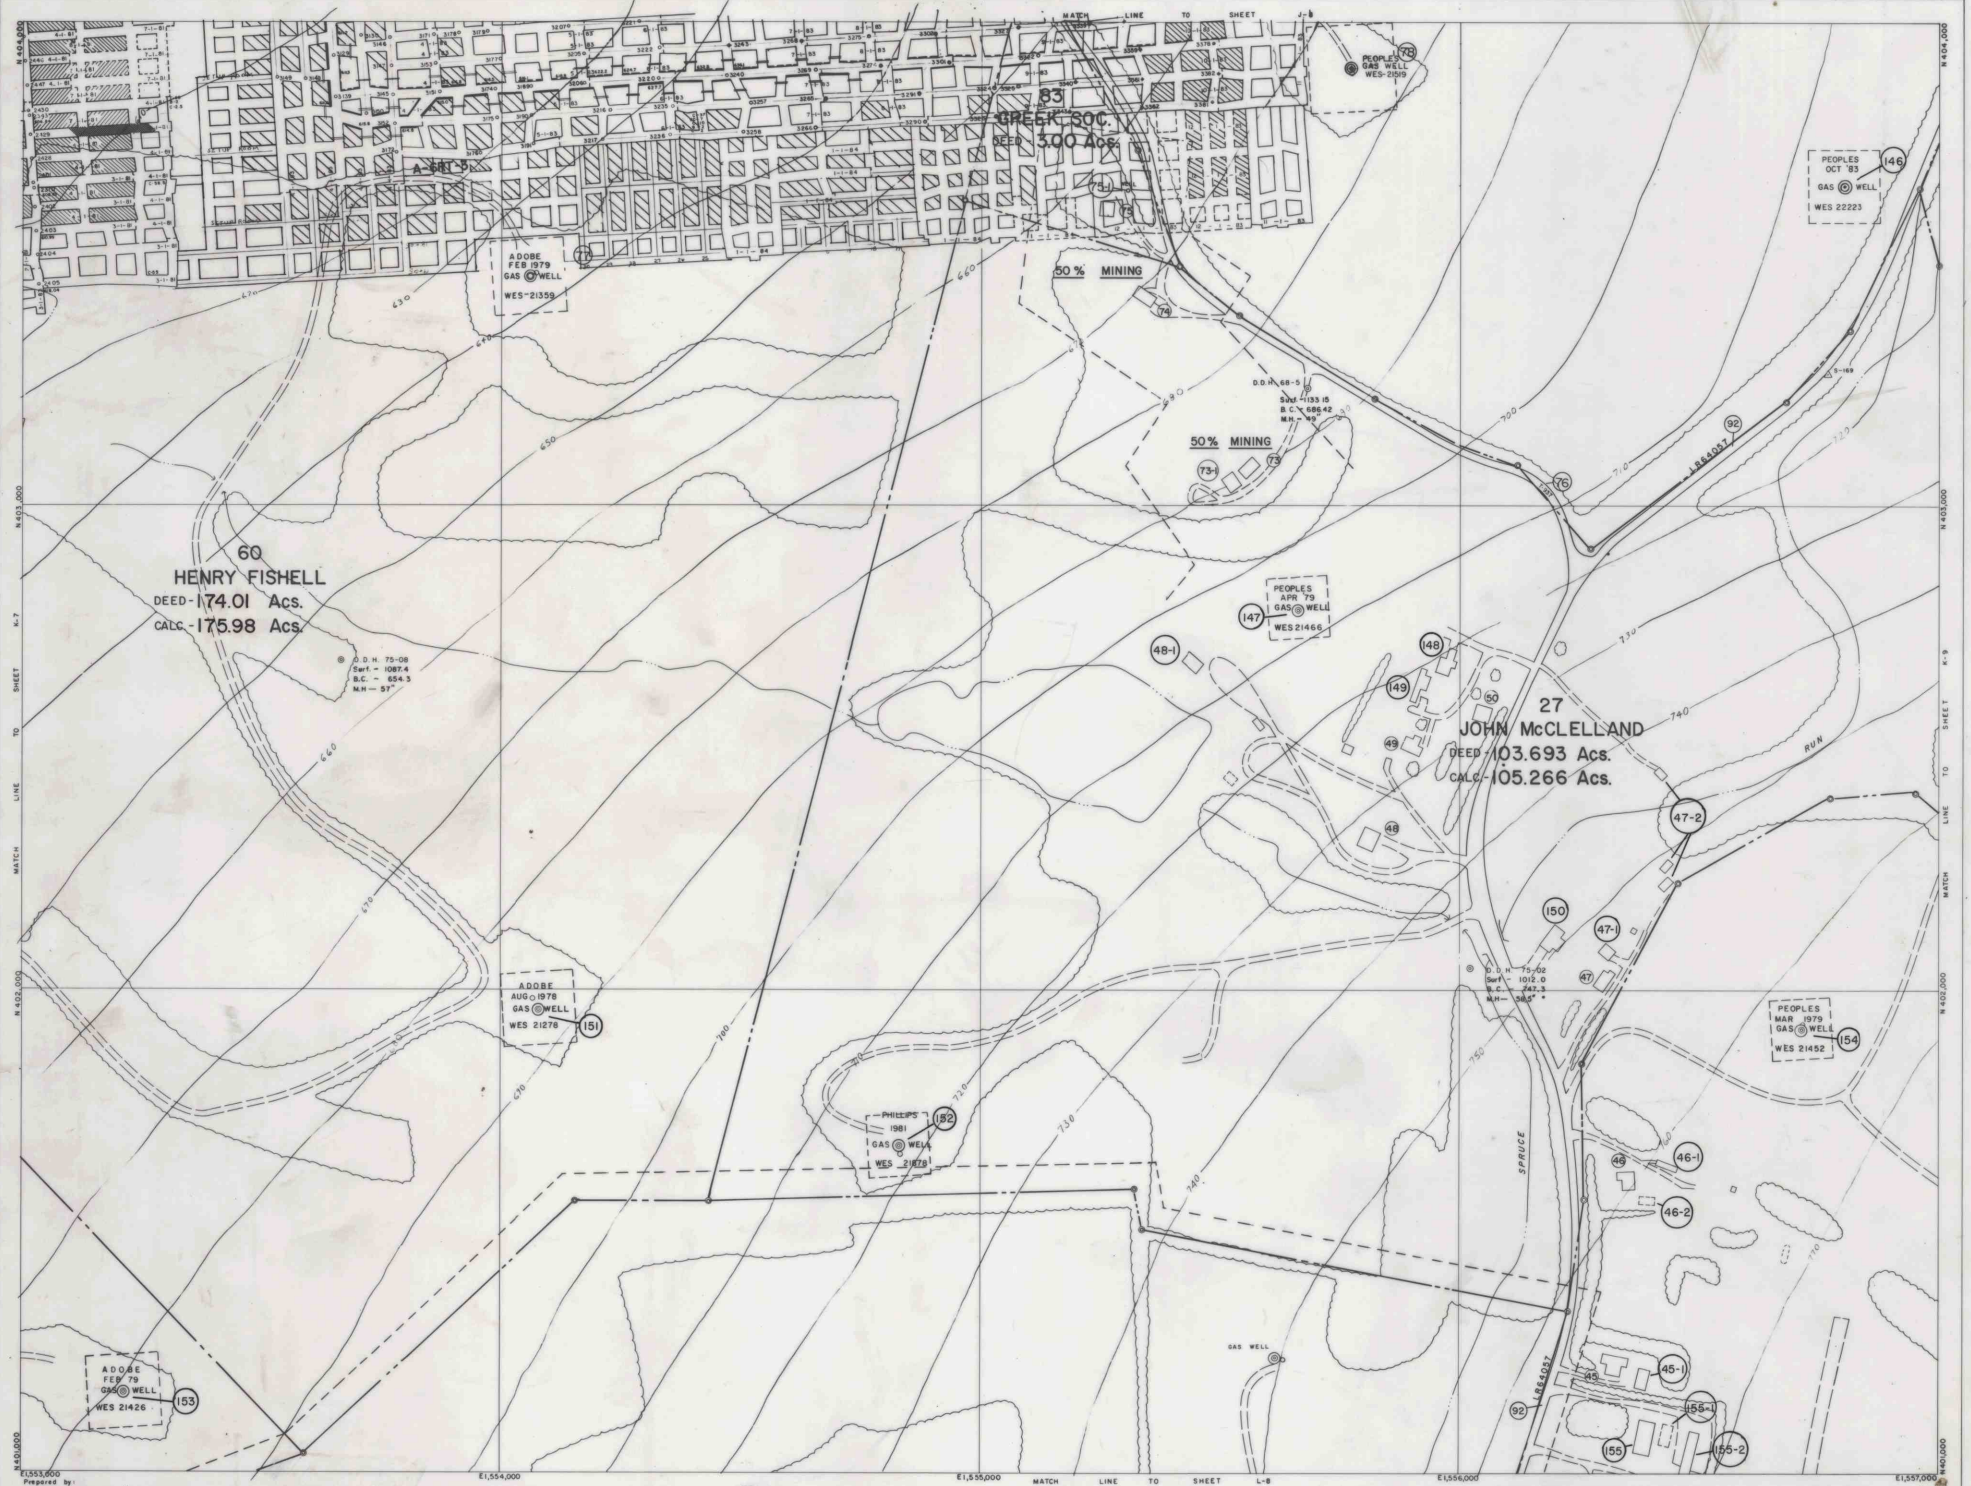

PREPARED BY
GREENHORNE & O'MARA, INC.
7710 LINCOLN HWY
NORTH HUNTINGDON, PA 15642
PHOTOGRAPHY DATED 5-6-83



TUNNELTON MINING COMPANY
MARION MINE U.S.B.M. NO 36 00929
Location... CONEMAUGH TWP. INDIANA CO., PA.
Address... Box 327 EMBURG, PA 15931

TUNNELTON MARION MINE
SCALE 1"=200'
INDIANA & WESTMORELAND COUNTIES

SHEET K-8