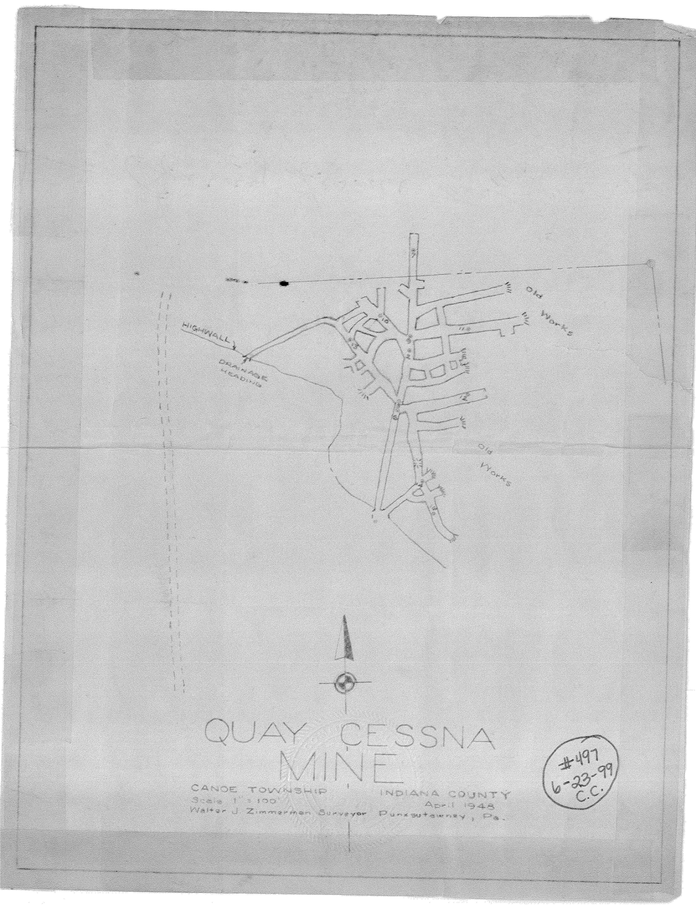
Old Works
HIGHWALL
DRAINAGE HEADING
Old Works
QUAY CESSNA MINE
CANOE TOWNSHIP
INDIANA COUNTY
Scale 1" = 100'
April 1948
Walter J. Zimmerman Surveyor
Punxsutawney, Pa.

#497
6-23-99
C.C.