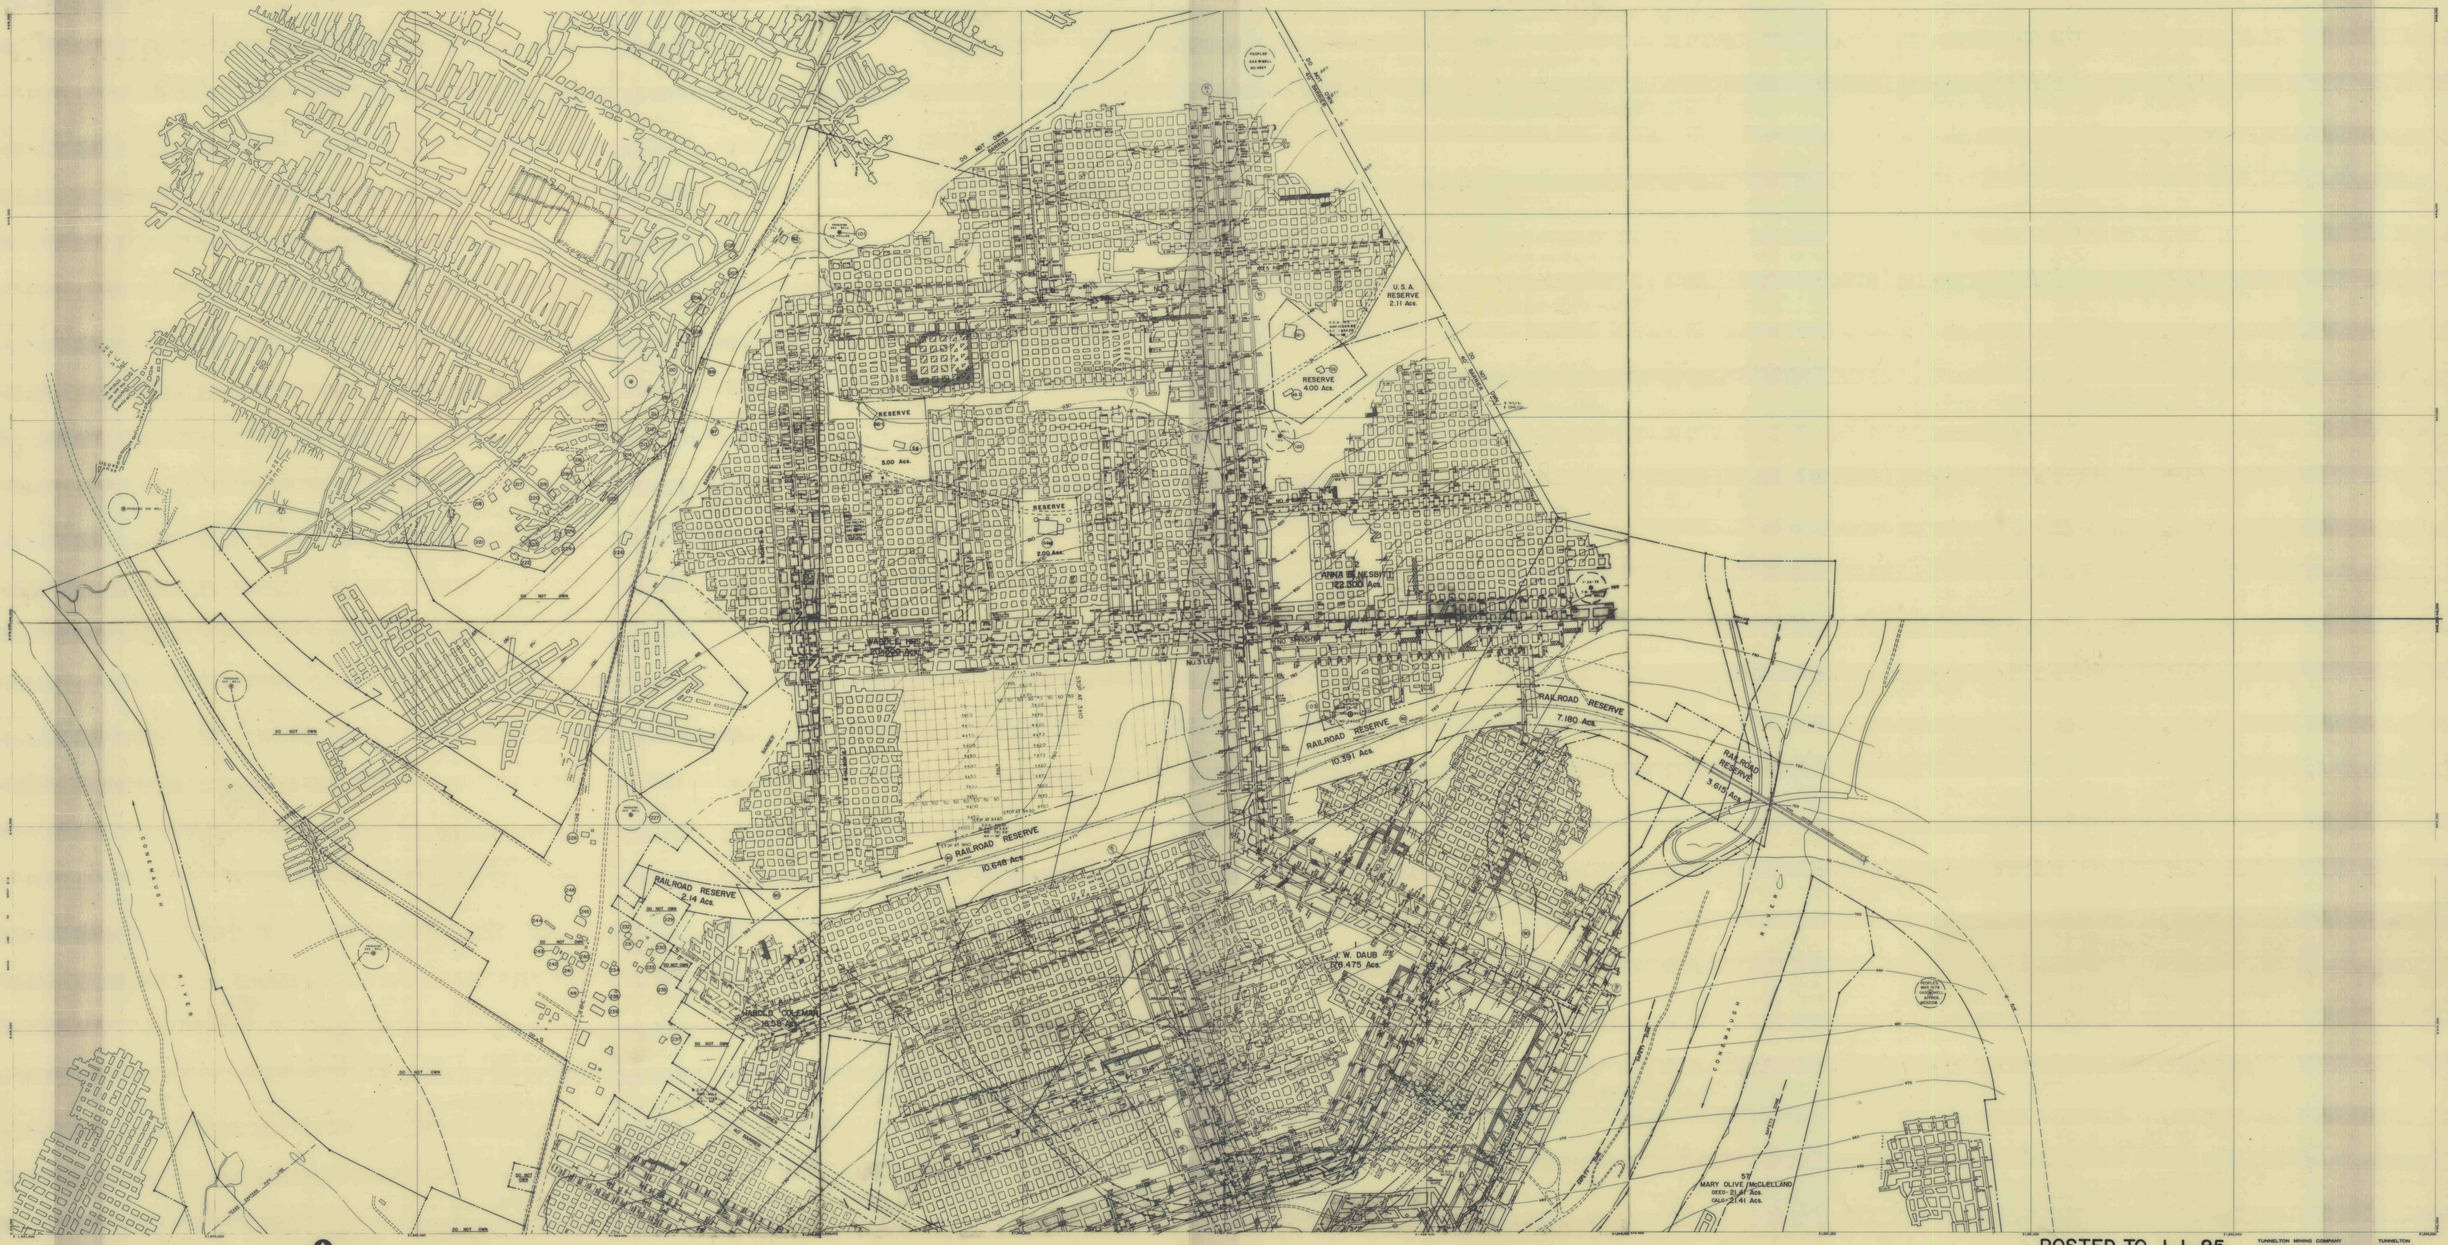


POSTED TO 1-1-85

1"=400'



