


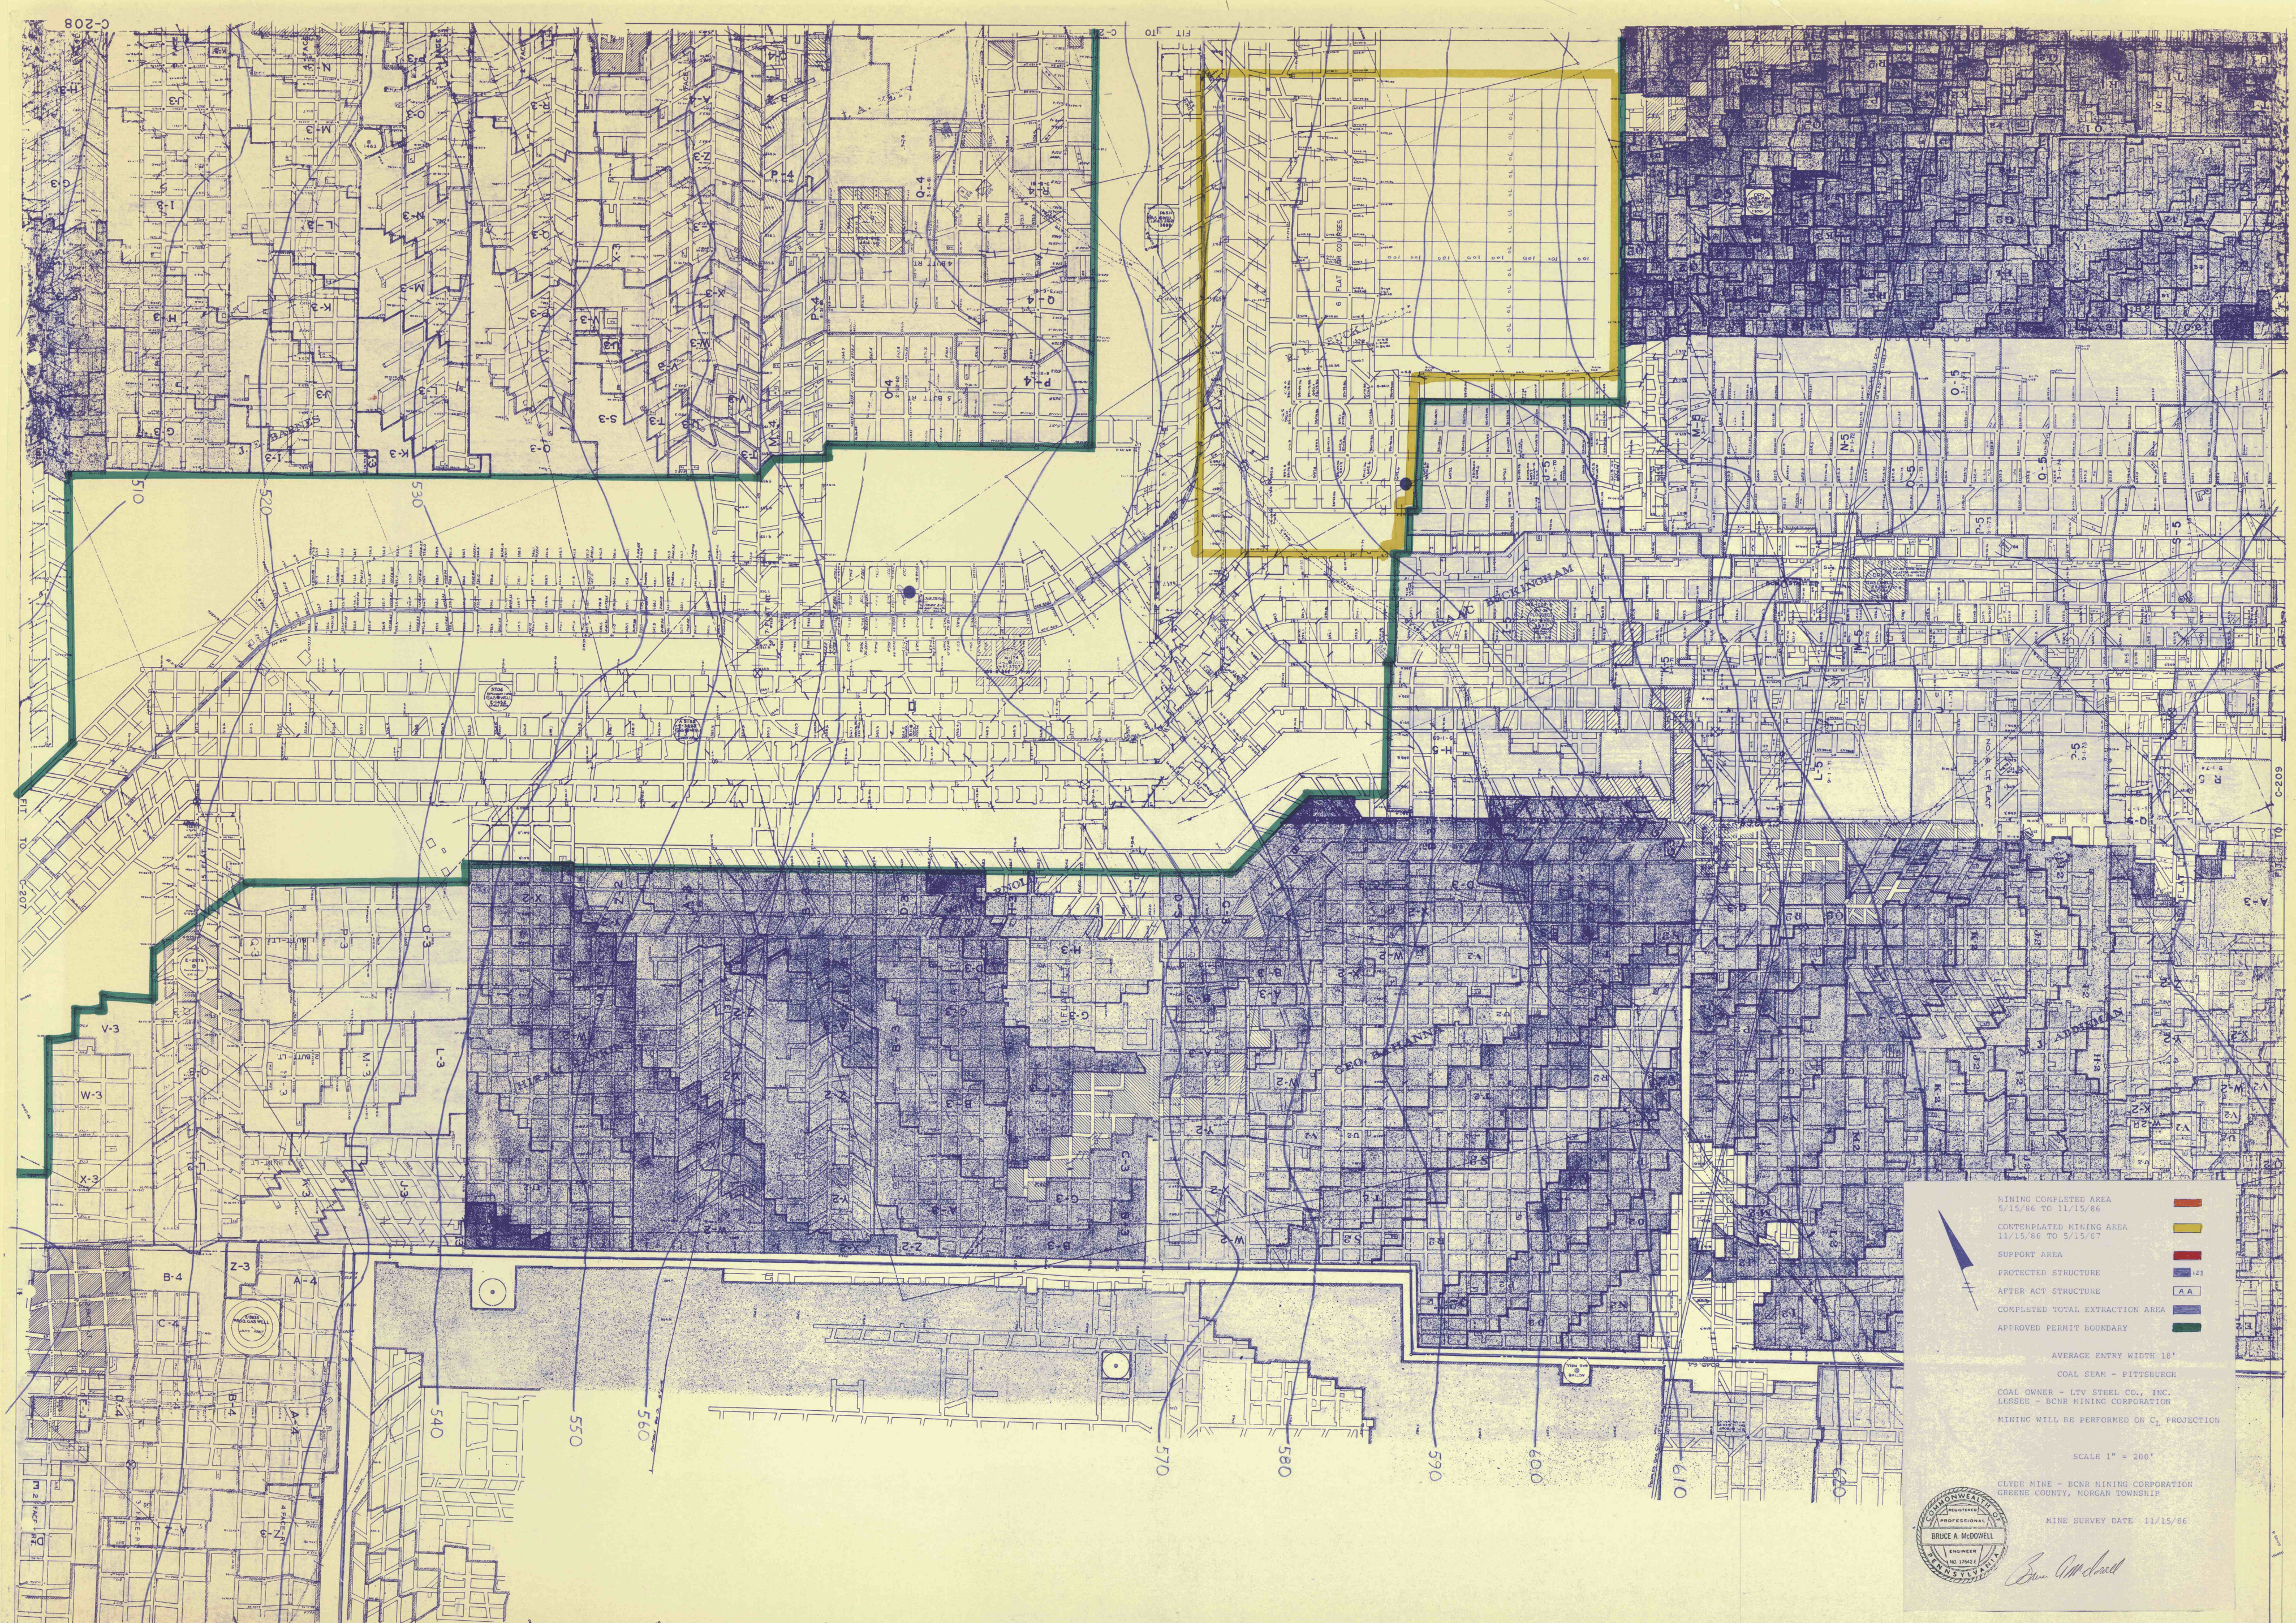

MINING COMPLETED AREA
5/15/86 TO 11/15/86

CONTINGENT MINING AREA
11/15/86 TO 5/15/87

SUPPORT AREA

PROTECTED STRUCTURE

AFTER ACT STRUCTURE

COMPLETED TOTAL EXTRACTION AREA

APPROVED PERMIT BOUNDARY

AVERAGE ENTRY WIDTH 18'

COAL SEAM - PITTSBURGH

COAL OWNER - LTV STEEL CO., INC.

LESSEE - BCR MINING CORPORATION

MINING WILL BE PERFORMED ON C₁ PROTECTION

SCALE 1" = 200'

CLYDE MINE - BCR MINING CORPORATION
GREENE COUNTY, MORGAN TOWNSHIP

MINING SURVEY DATE 11/15/86

BRUCE A. McODWELL
ENGINEER
NO. 17641
PENNSYLVANIA

Bruce A. McODWELL