


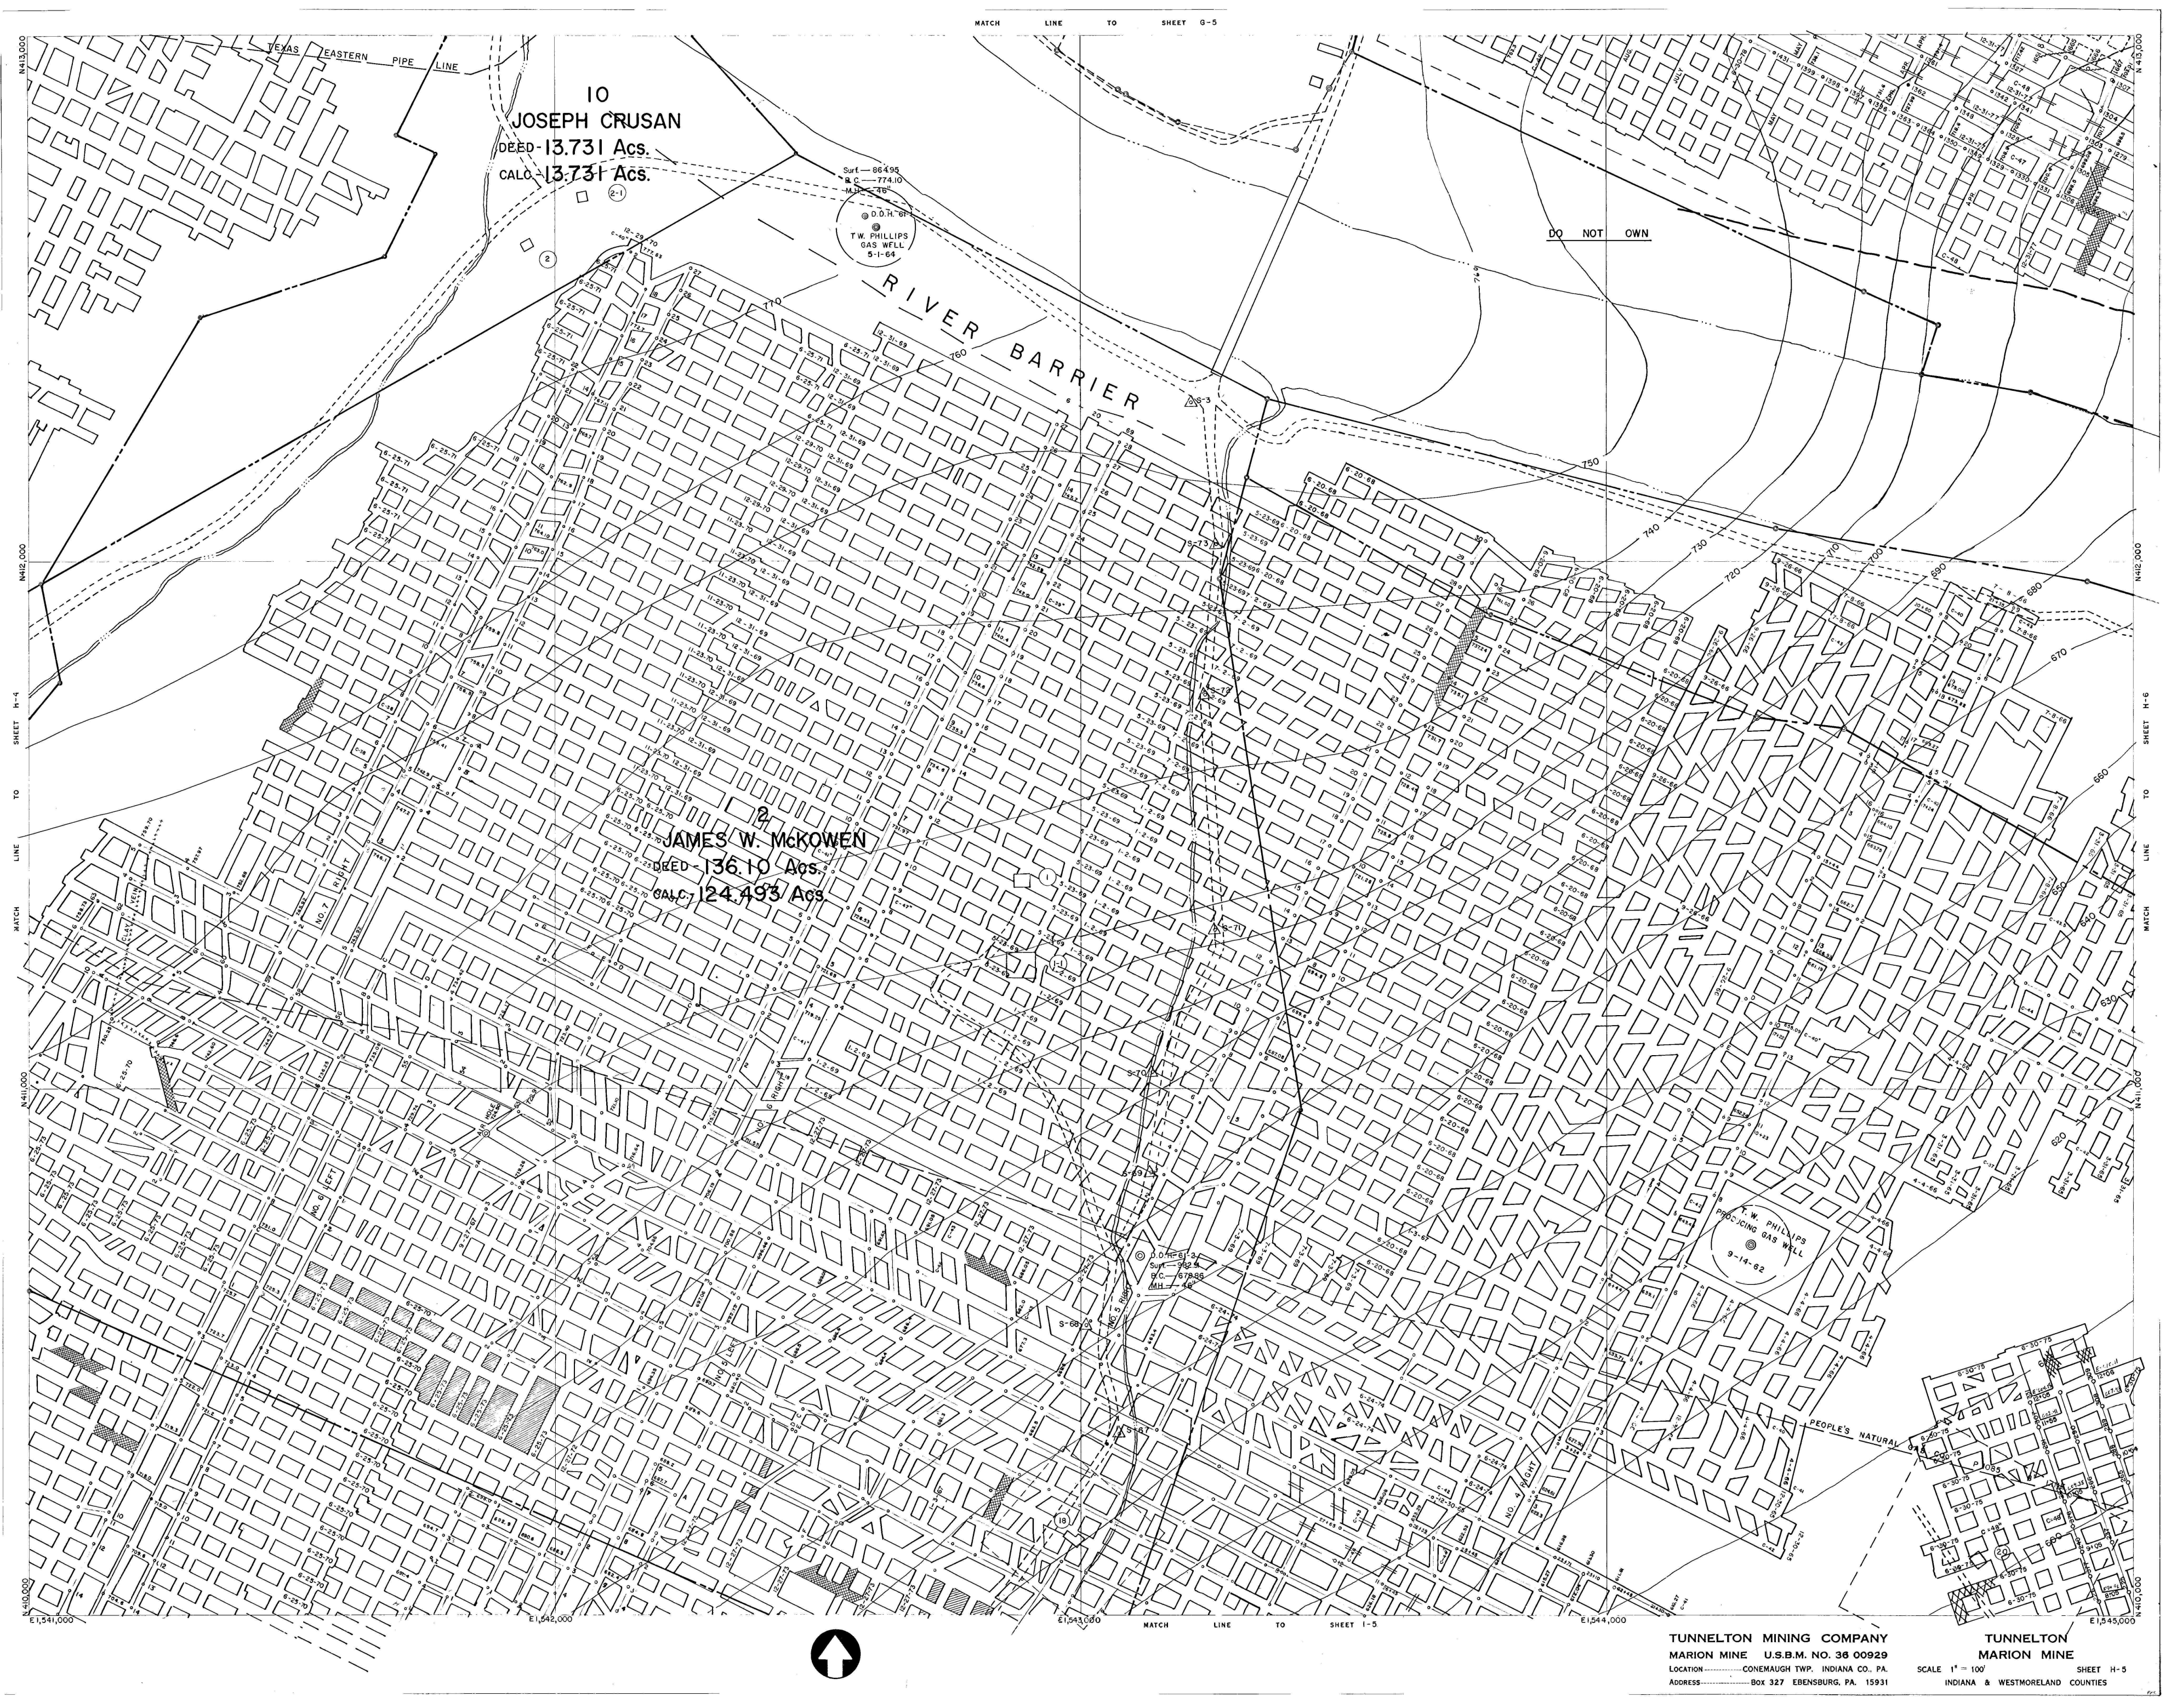

10
JOSEPH CRUSAN
DEED-13.731 Acs.
CALC-13.731 Acs.

Surf-86495
R.C-774.10
M.H-48"
D.D.H. 6P
T.W. PHILLIPS
GAS WELL
5-1-64

DO NOT OWN

2
JAMES W. MCKOWEN
DEED-136.10 Acs.
CALC-124.493 Acs.

T.W. PHILLIPS
PRODUCING GAS WELL
9-14-62

PEOPLE'S NATURAL



TUNNELTON MINING COMPANY
MARION MINE U.S.B.M. NO. 36 00929
LOCATION.....CONEMAUGH TWP., INDIANA CO., PA.
ADDRESS.....BOX 327 EBENSURG, PA. 15931

TUNNELTON
MARION MINE
SCALE 1" = 100'
INDIANA & WESTMORELAND COUNTIES
SHEET H-5