


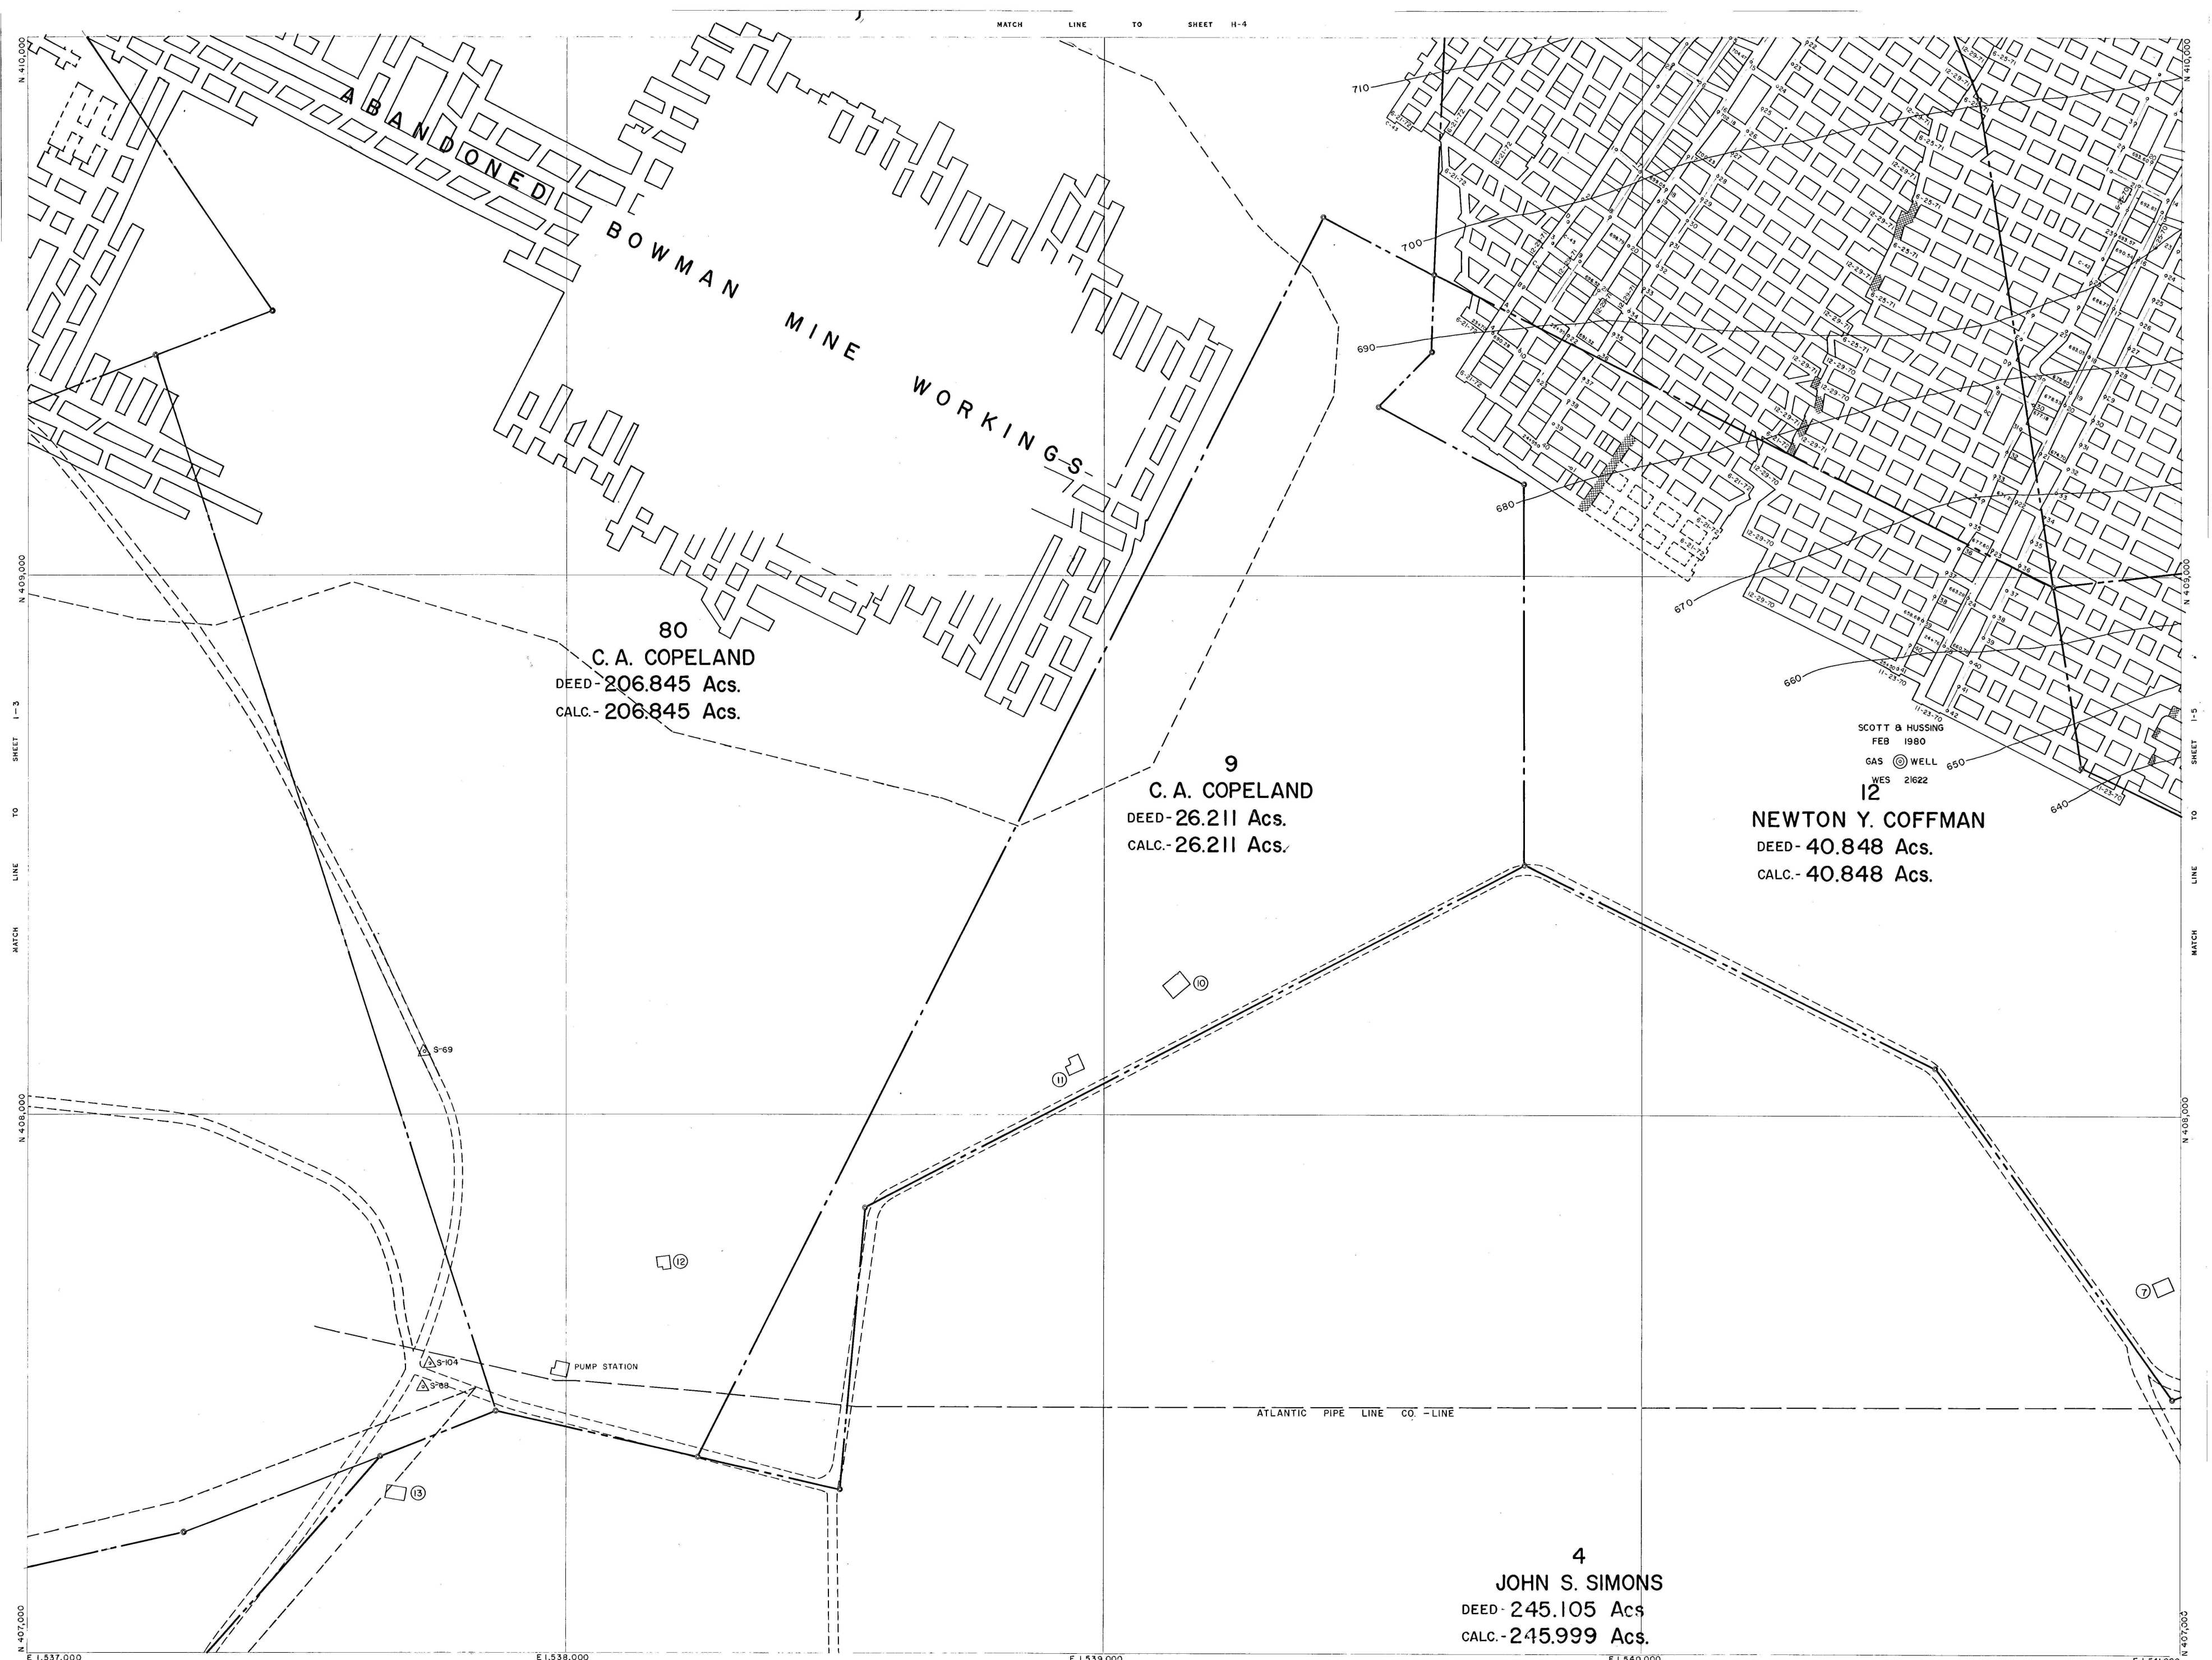

80
C. A. COPELAND
DEED- 206.845 Acs.
CALC.- 206.845 Acs.

9
C. A. COPELAND
DEED- 26.211 Acs.
CALC.- 26.211 Acs.

12
SCOTT & HUSSING
FEB 1980
GAS WELL 21622
NEWTON Y. COFFMAN
DEED- 40.848 Acs.
CALC.- 40.848 Acs.

4
JOHN S. SIMONS
DEED- 245.105 Acs.
CALC.- 245.999 Acs.