


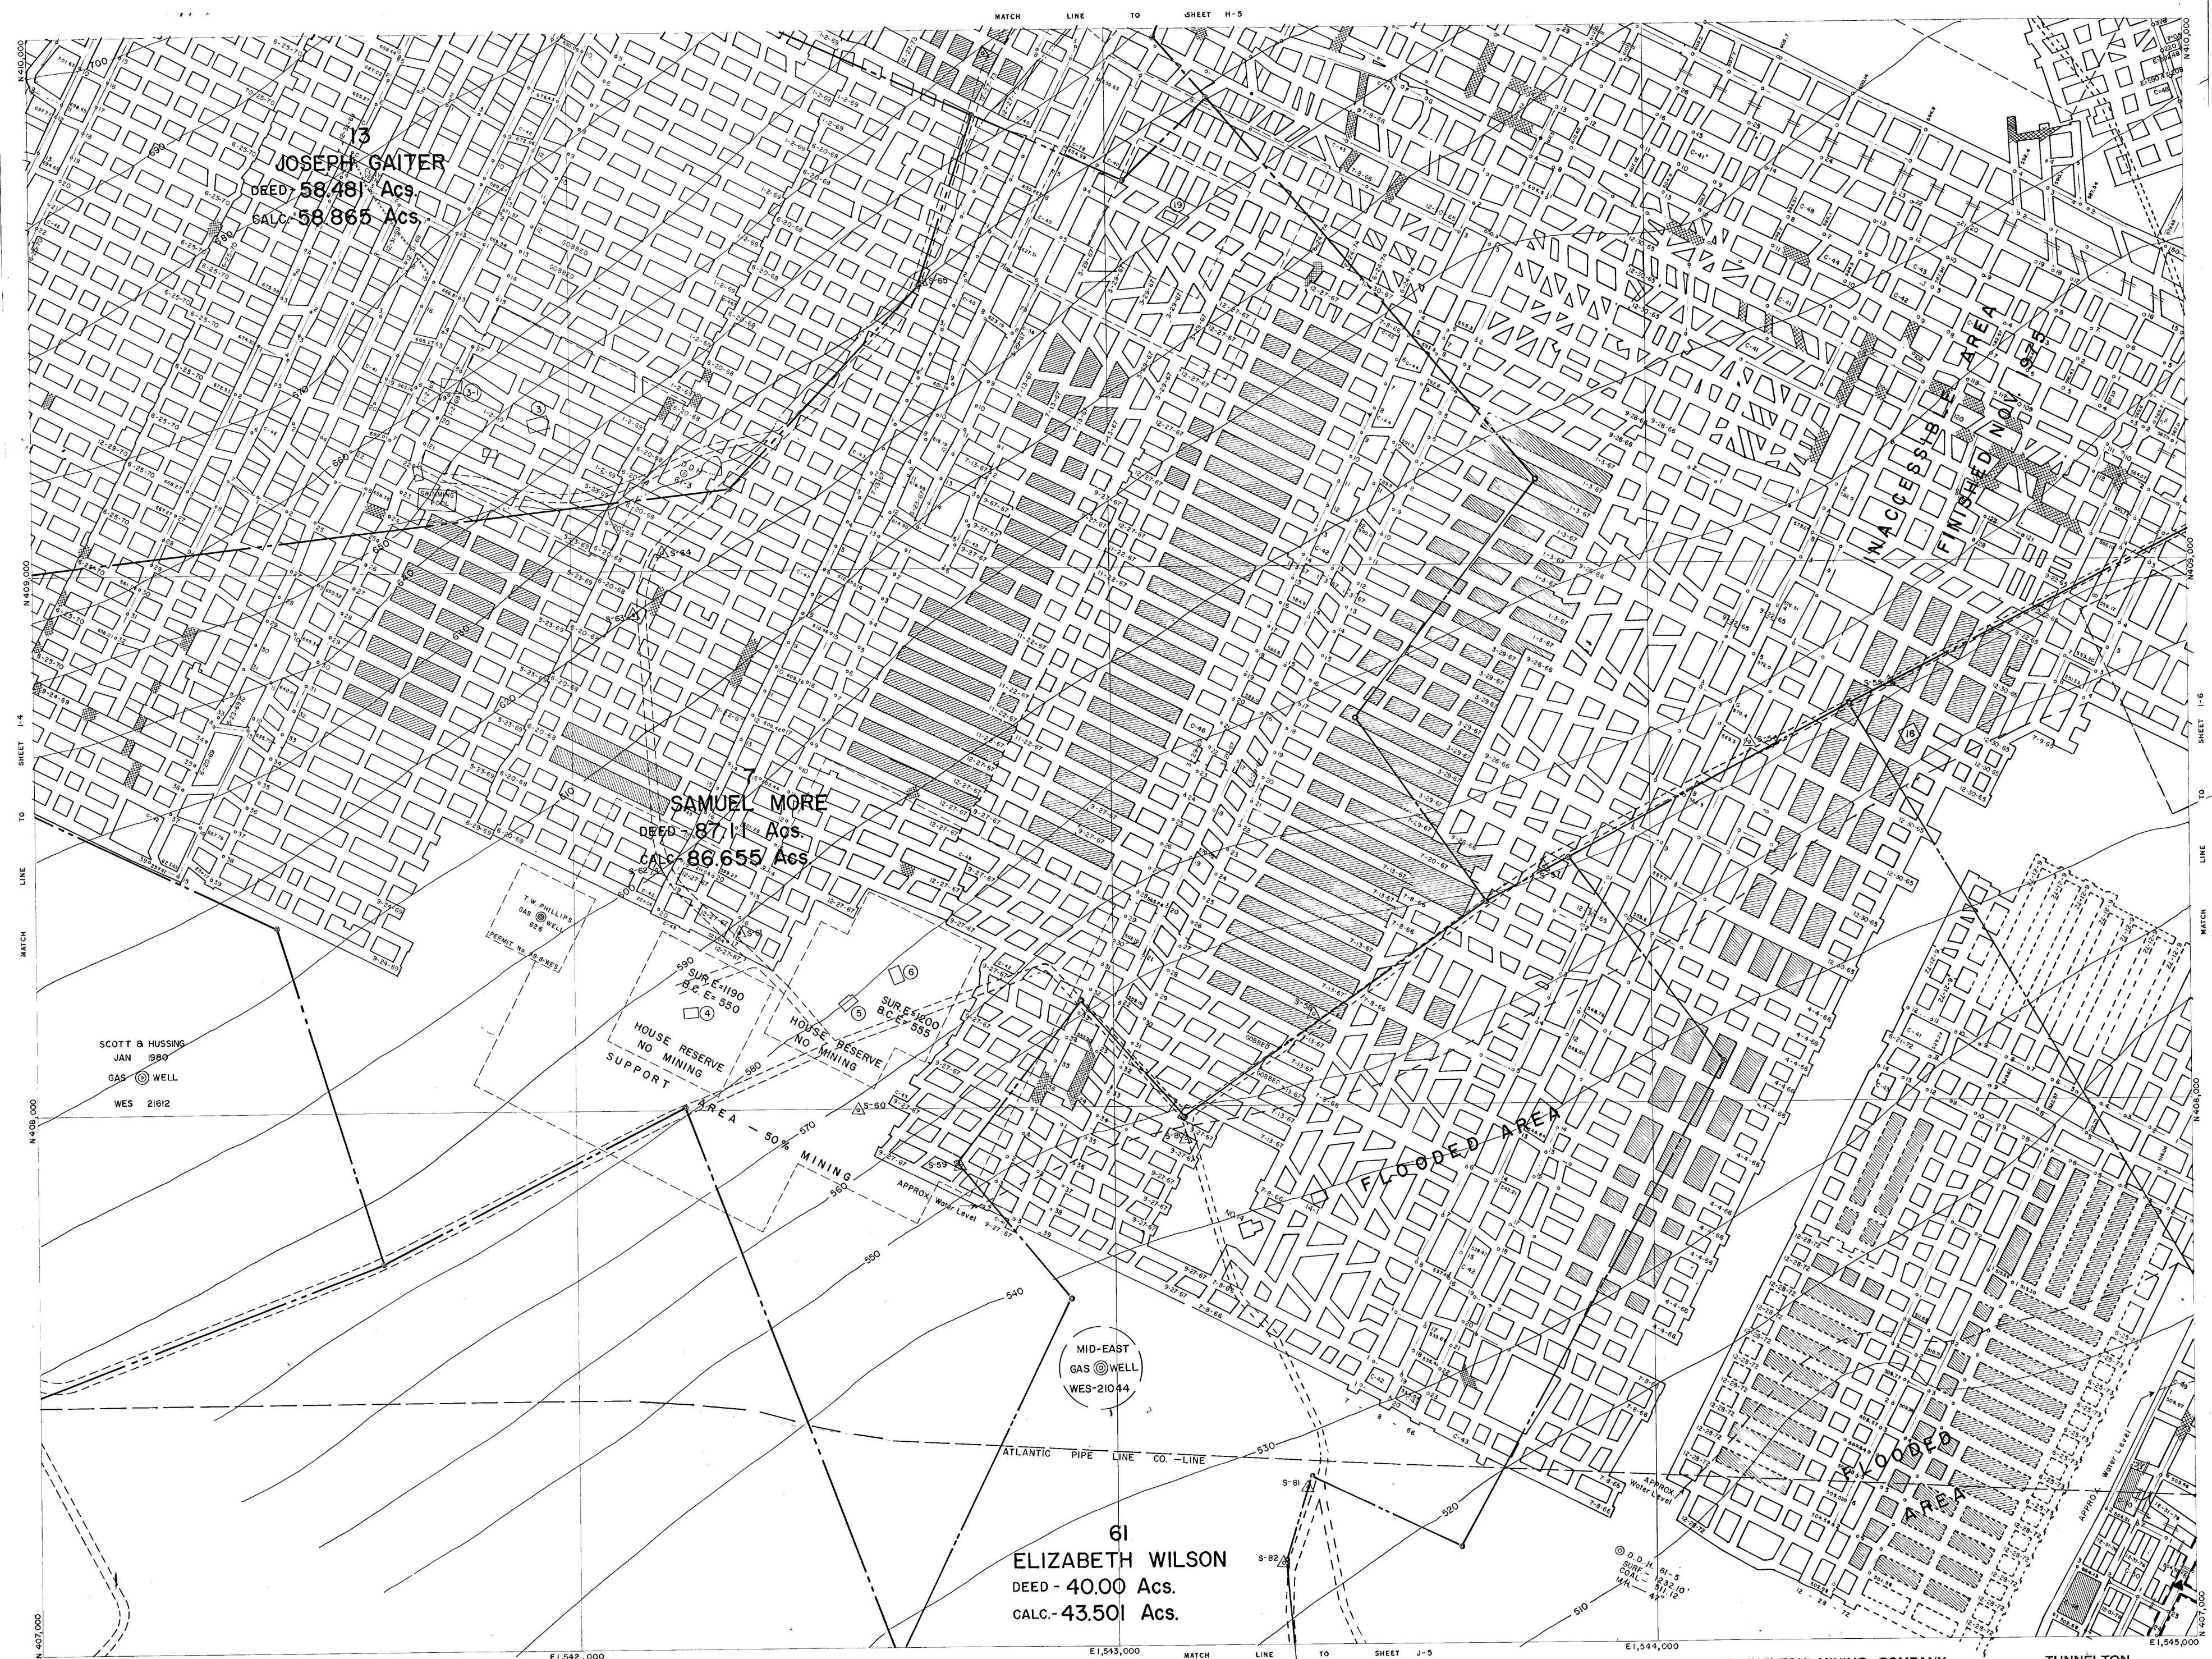

SCOTT & HUSSING
JAN 1980
GAS WELL
WES 21012

T.W. PHILLIPS
GAS WELL
PERMIT NO. 86-B-WES

HOUSE RESERVE
NO MINING
SUPPORT

HOUSE RESERVE
NO MINING

MID-EAST
GAS WELL
WES-21044

61
ELIZABETH WILSON
DEED - 40.00 Acs.
CALC. - 43.501 Acs.

TUNNELTON MINING COMPANY
MARION MINE U.S.B.M. NO. 36 00929
LOCATION.....CONEMAUGH TWP. INDIANA CO., PA.
ADDRESS.....BOX 327 EBENSBURG, PA. 15931

TUNNELTON
MARION MINE
SCALE 1" = 100'
INDIANA & WESTMORELAND COUNTIES
SHEET 1-5