


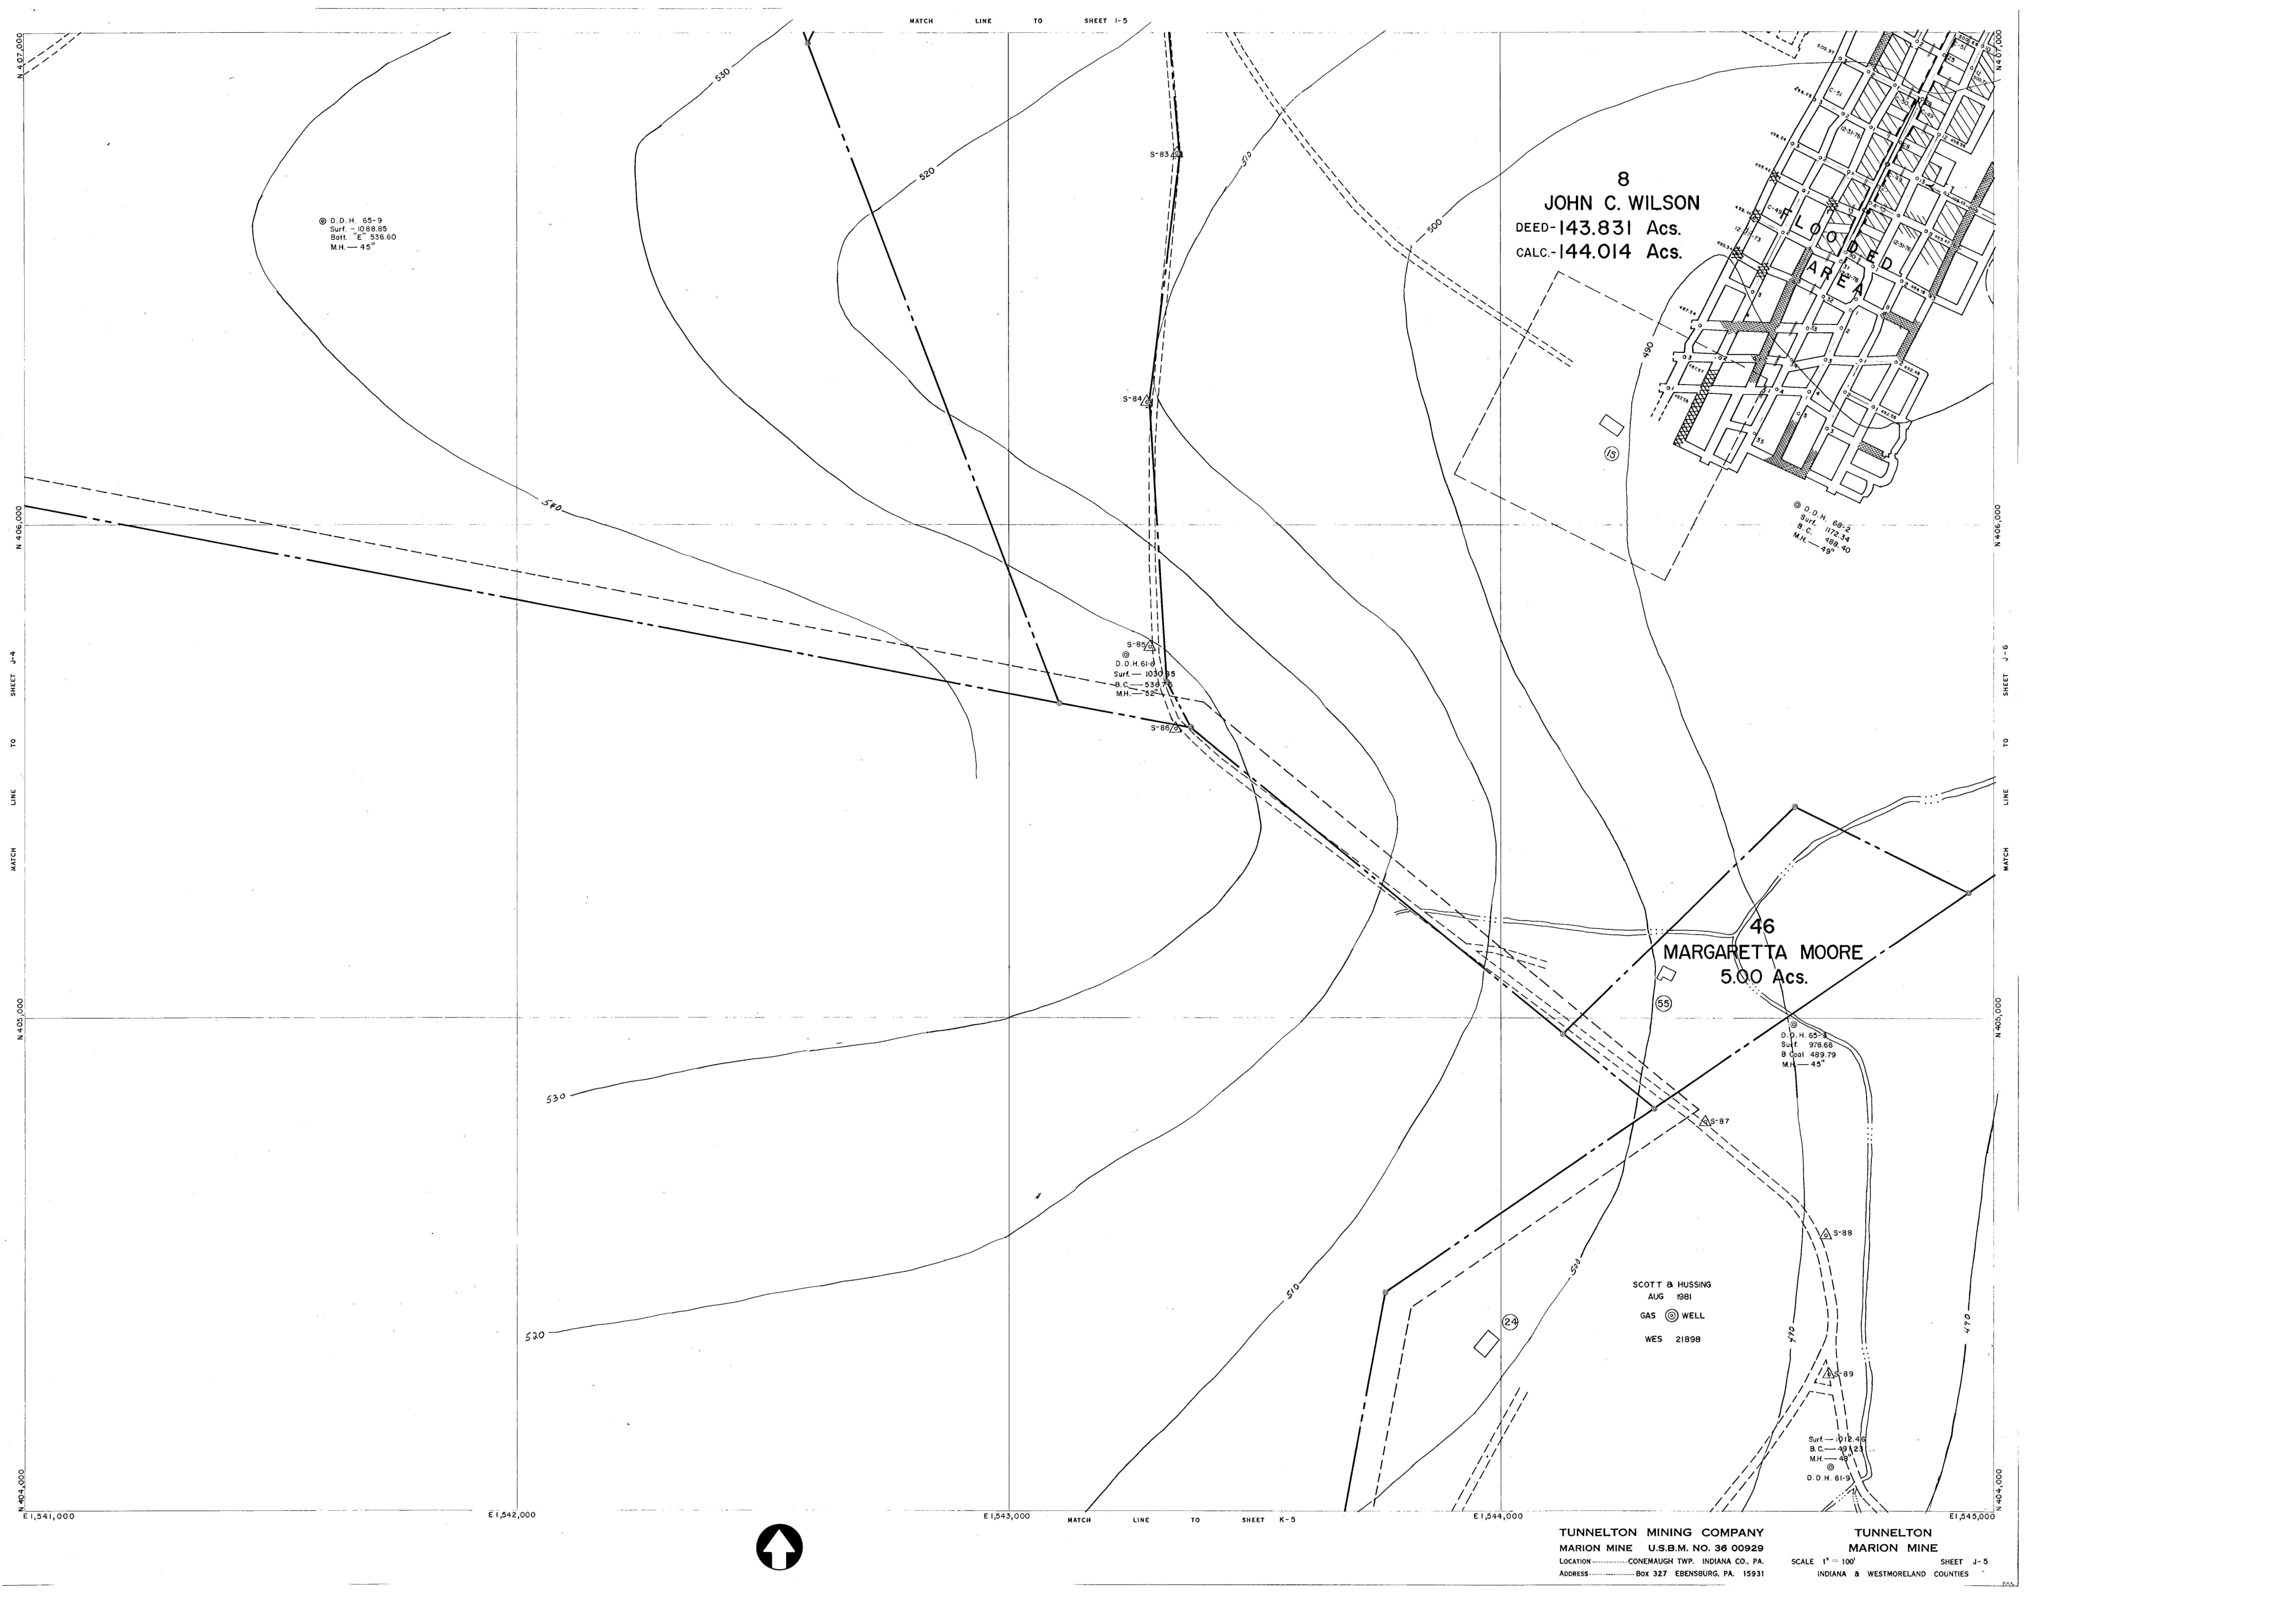

© D.D.H. 65-9
Surf. - 1088.85
Bolt. "E" 536.60
M.H. - 45"

8
JOHN C. WILSON
DEED-143.831 Acs.
CALC.-144.014 Acs.

© D.D.H. 68-2
Surf. - 1172.34
B.C. - 108.40
M.H. - 49"

S-85
D.D.H. 61-3
Surf. - 1030.85
B.C. - 530.75
M.H. - 52"

46
MARGARETTA MOORE
5.00 Acs.

D.D.H. 65-3
Surf. - 978.60
B Coal - 489.79
M.H. - 45"

SCOTT & HUSSING
AUG 1981
GAS WELL
WES 21898

Surf. - 1012.46
B.C. - 48.21
M.H. - 48"
D.D.H. 61-9

TUNNELTON MINING COMPANY
MARION MINE U.S.B.M. NO. 38 00929
LOCATION.....CONEMAUGH TWP. INDIANA CO., PA.
ADDRESS.....Box 327 EBENSBURG, PA. 15931

TUNNELTON
MARION MINE
SCALE 1" = 100'
SHEET J-5
INDIANA & WESTMORELAND COUNTIES