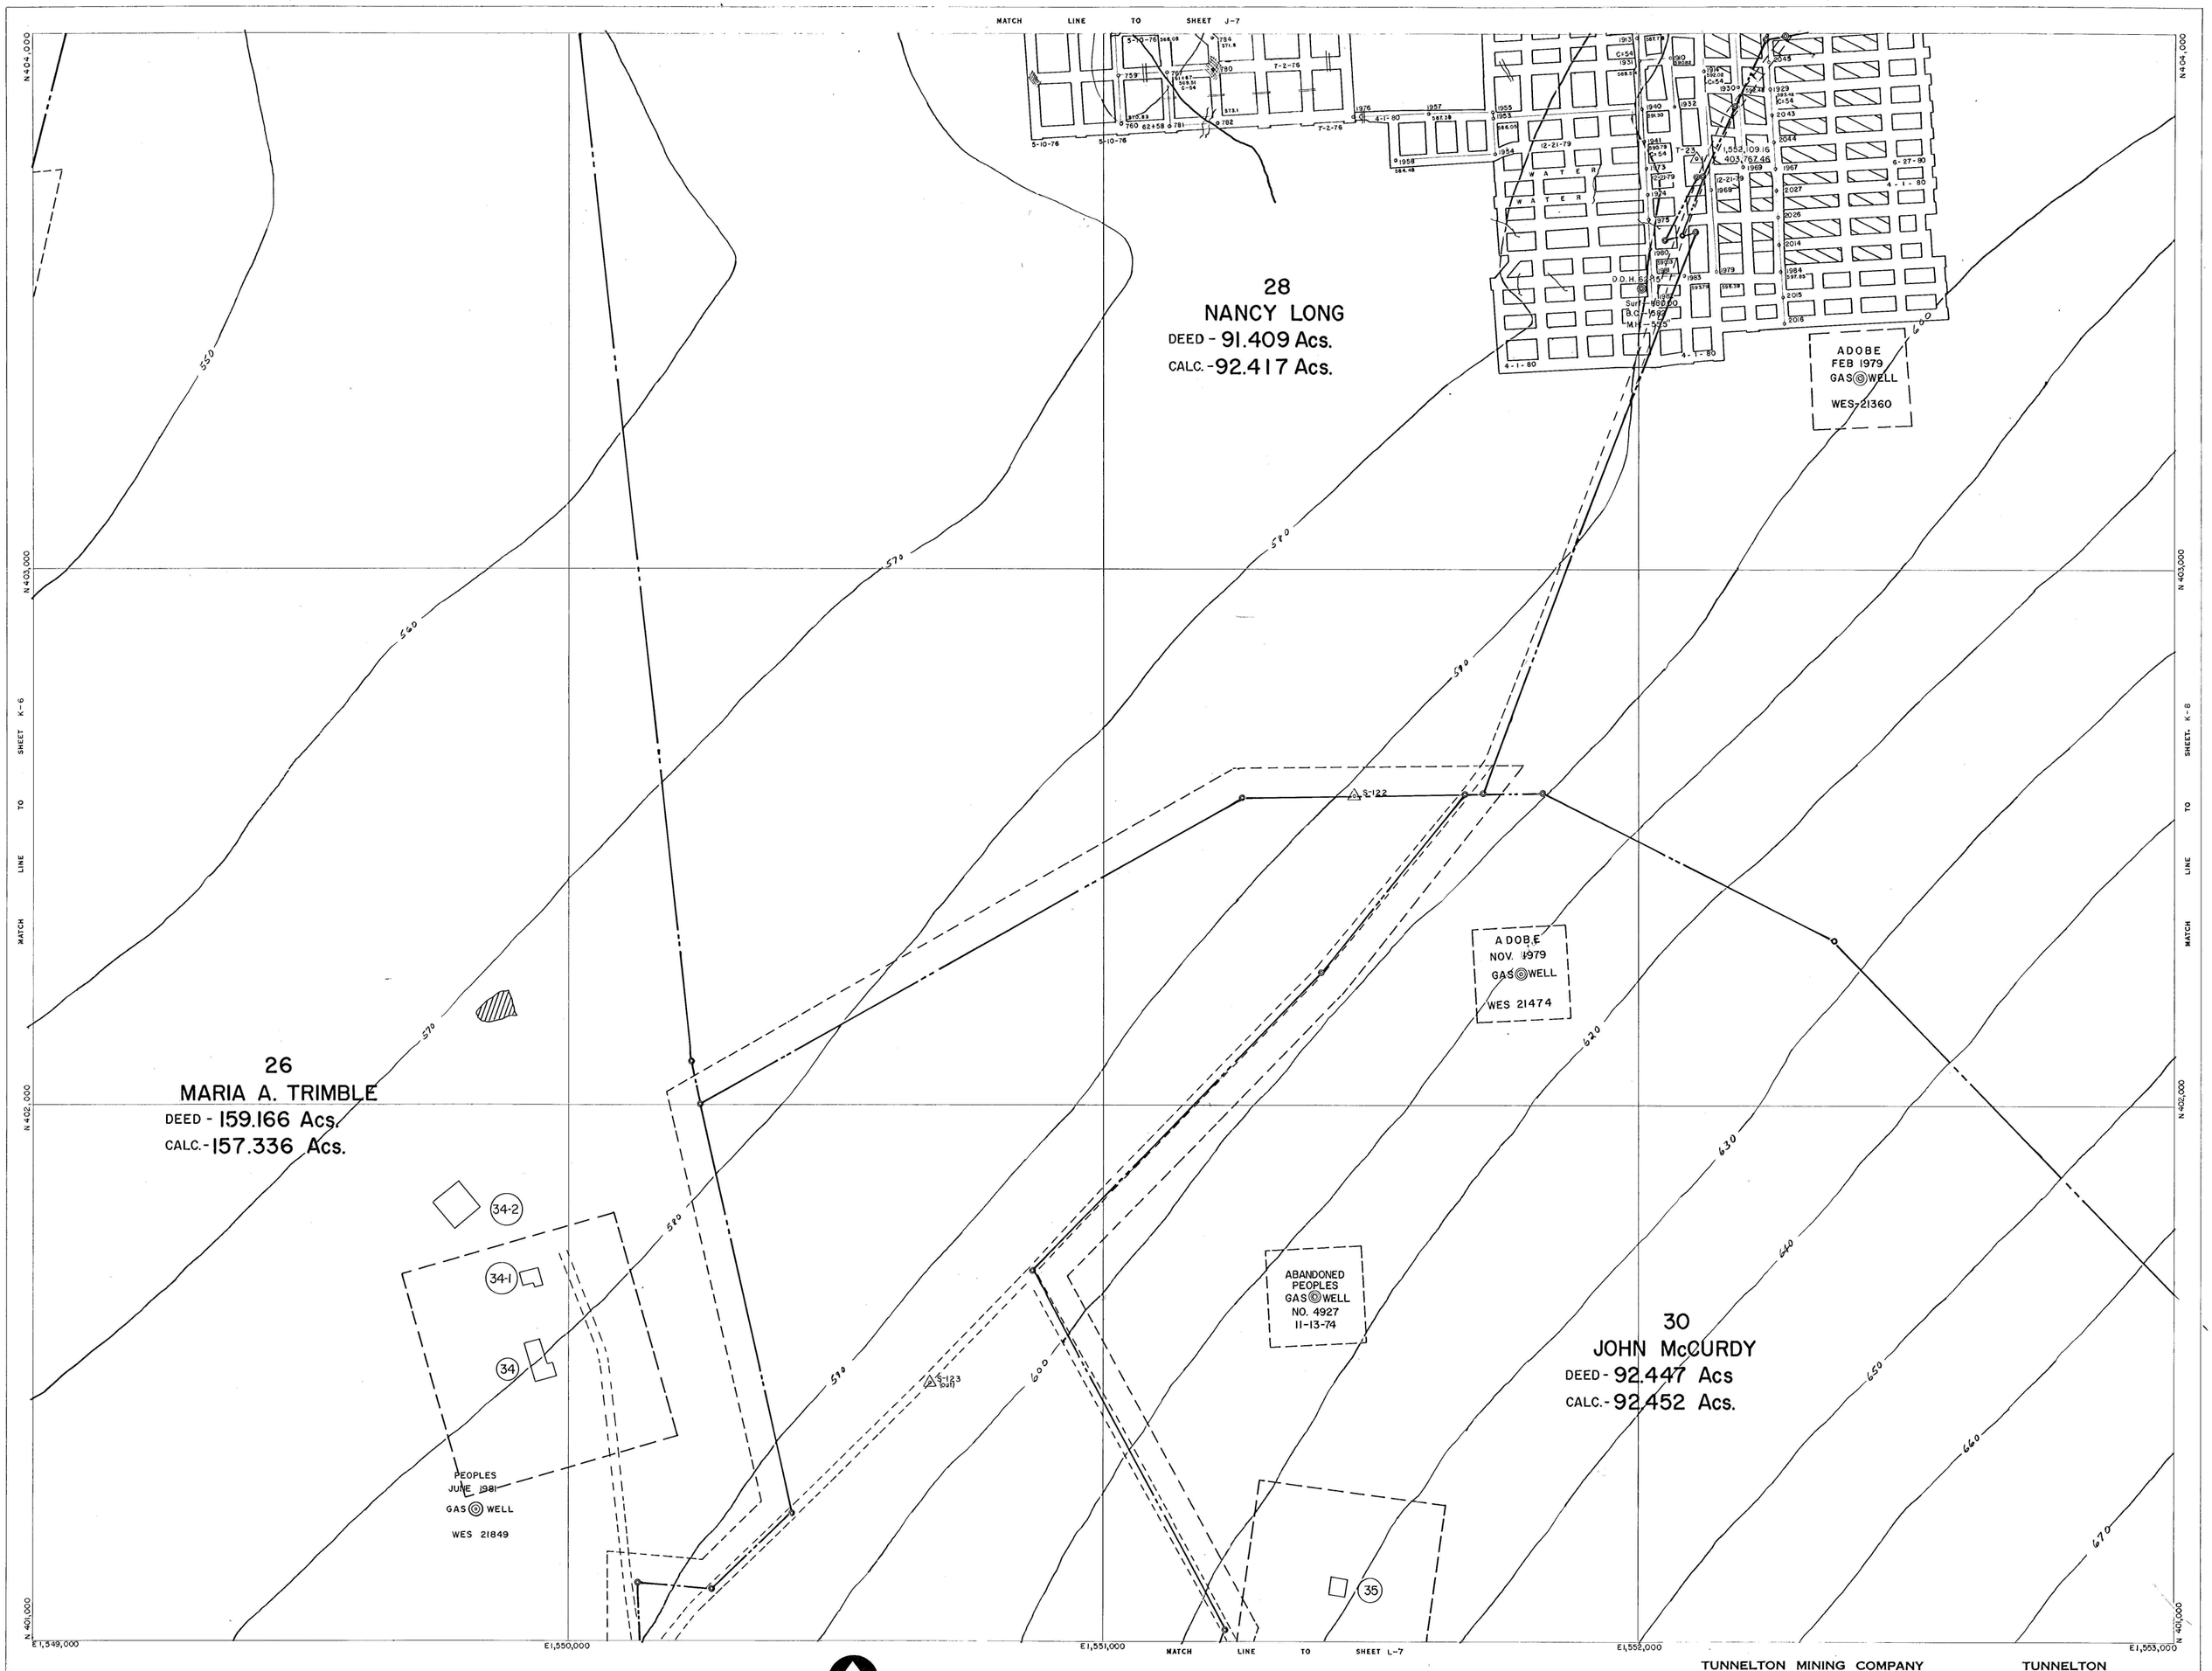

TUNNELTON MINING COMPANY
MARION MINE U.S.B.M. NO. 36 00929
LOCATION ---------- CONEMAUGH TWP. INDIANA CO., PA.
ADDRESS ---------- BOX 327 EBENSBURG, PA. 15931

TUNNELTON
MARION MINE
SCALE 1" = 100' SHEET K-7
INDIANA & WESTMORELAND COUNTIES