

INDIANA CO.

Vinton No 16

1" = 100'


Dias Sta.

BLACK LICK

CREEK

1546 - out crop B

1412 crop B

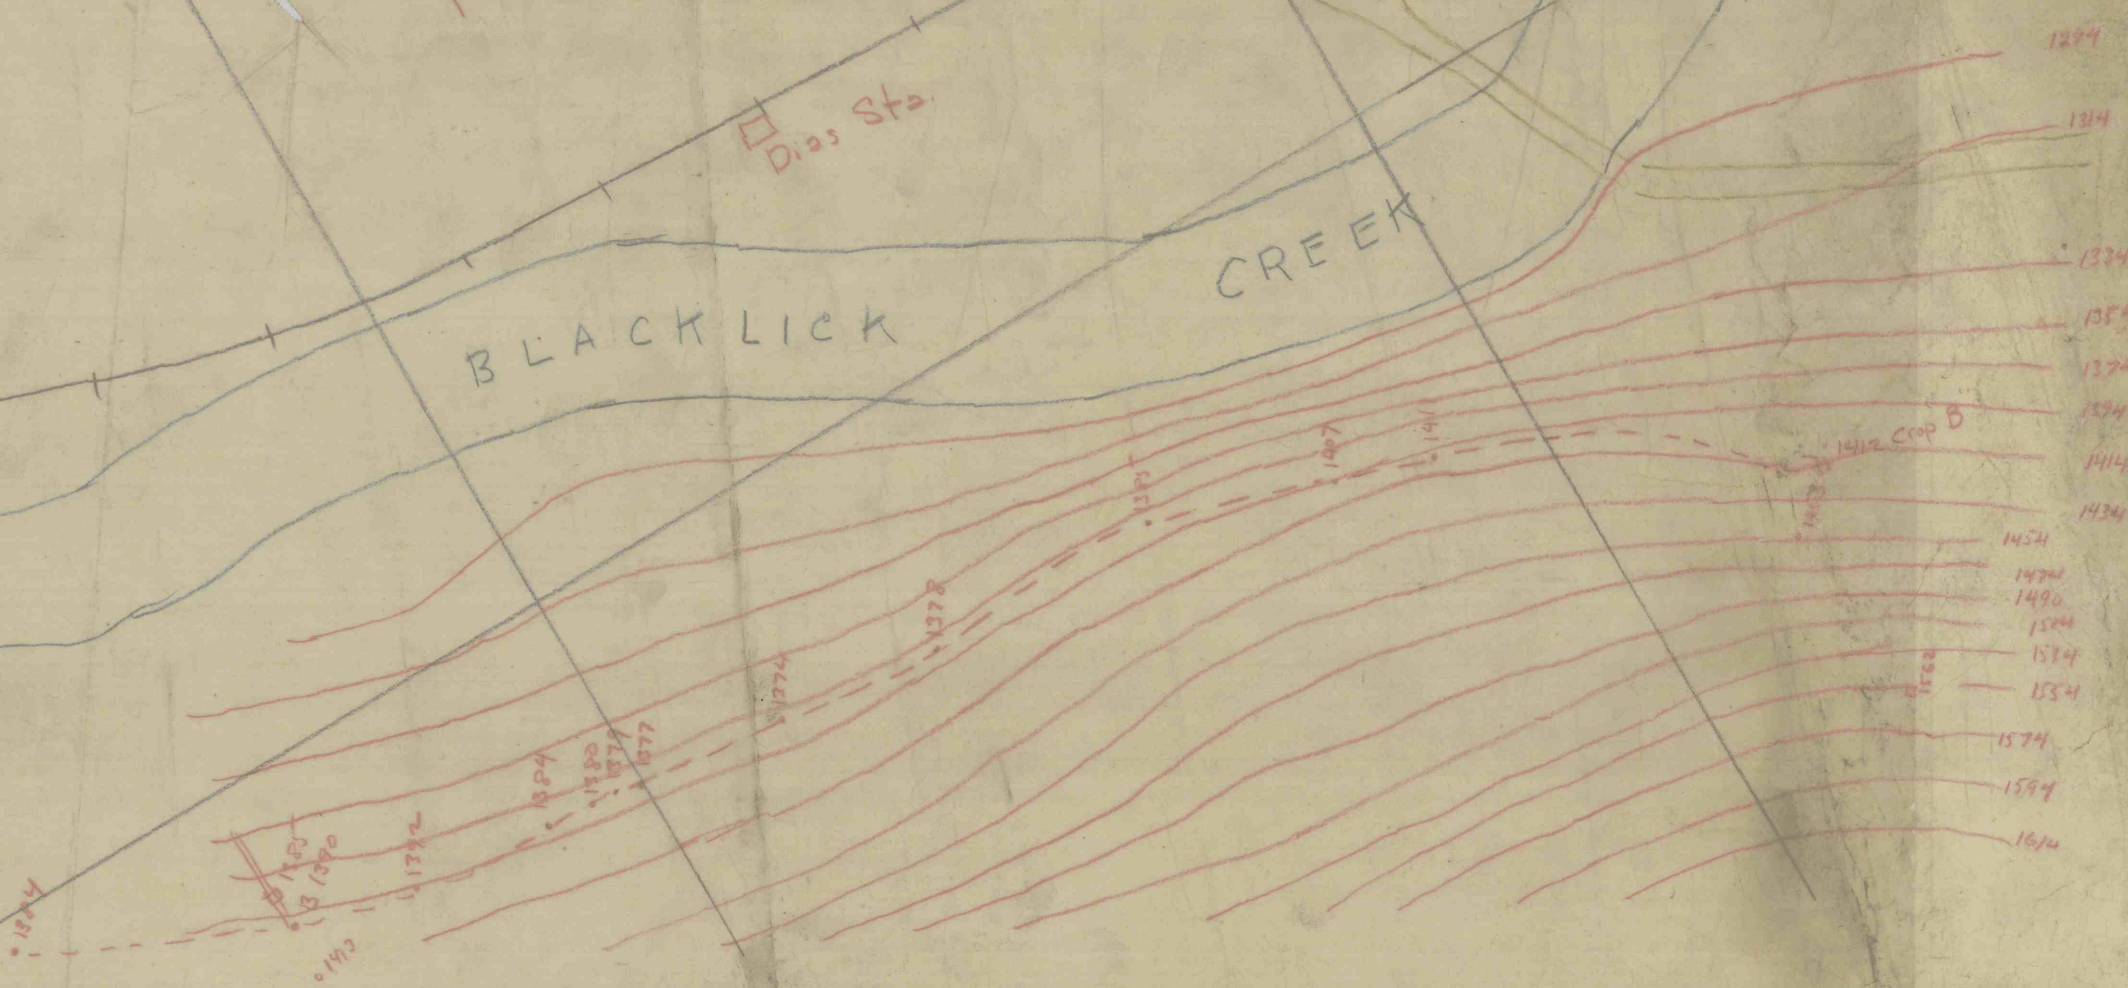

304134