


CARBON TOWNSHIP
HUNTINGDON COUNTY
PERMIT NUMBER - 206-1
A-PRIME-OR CLARION SEAM
(FULTON)

UNITED STATES
DEPARTMENT OF THE INTERIOR
GEOLOGICAL SURVEY


STATE OF PENNSYLVANIA
REPRESENTED BY THE
DEPARTMENT OF INTERNAL AFFAIRS
TOPOGRAPHIC AND GEOLOGIC SURVEY
(Huntingdon)

MILL CREEK 17.3 MI.
CASSVILLE 3.6 MI.
MAPLETON 11.5 MI.
BARNEYTOWN 5.3 MI.
PENNsylvania
BROAD TOP QUADRANGLE
1920 000 FEET
76° 00' 00" W
40° 00' 00" N

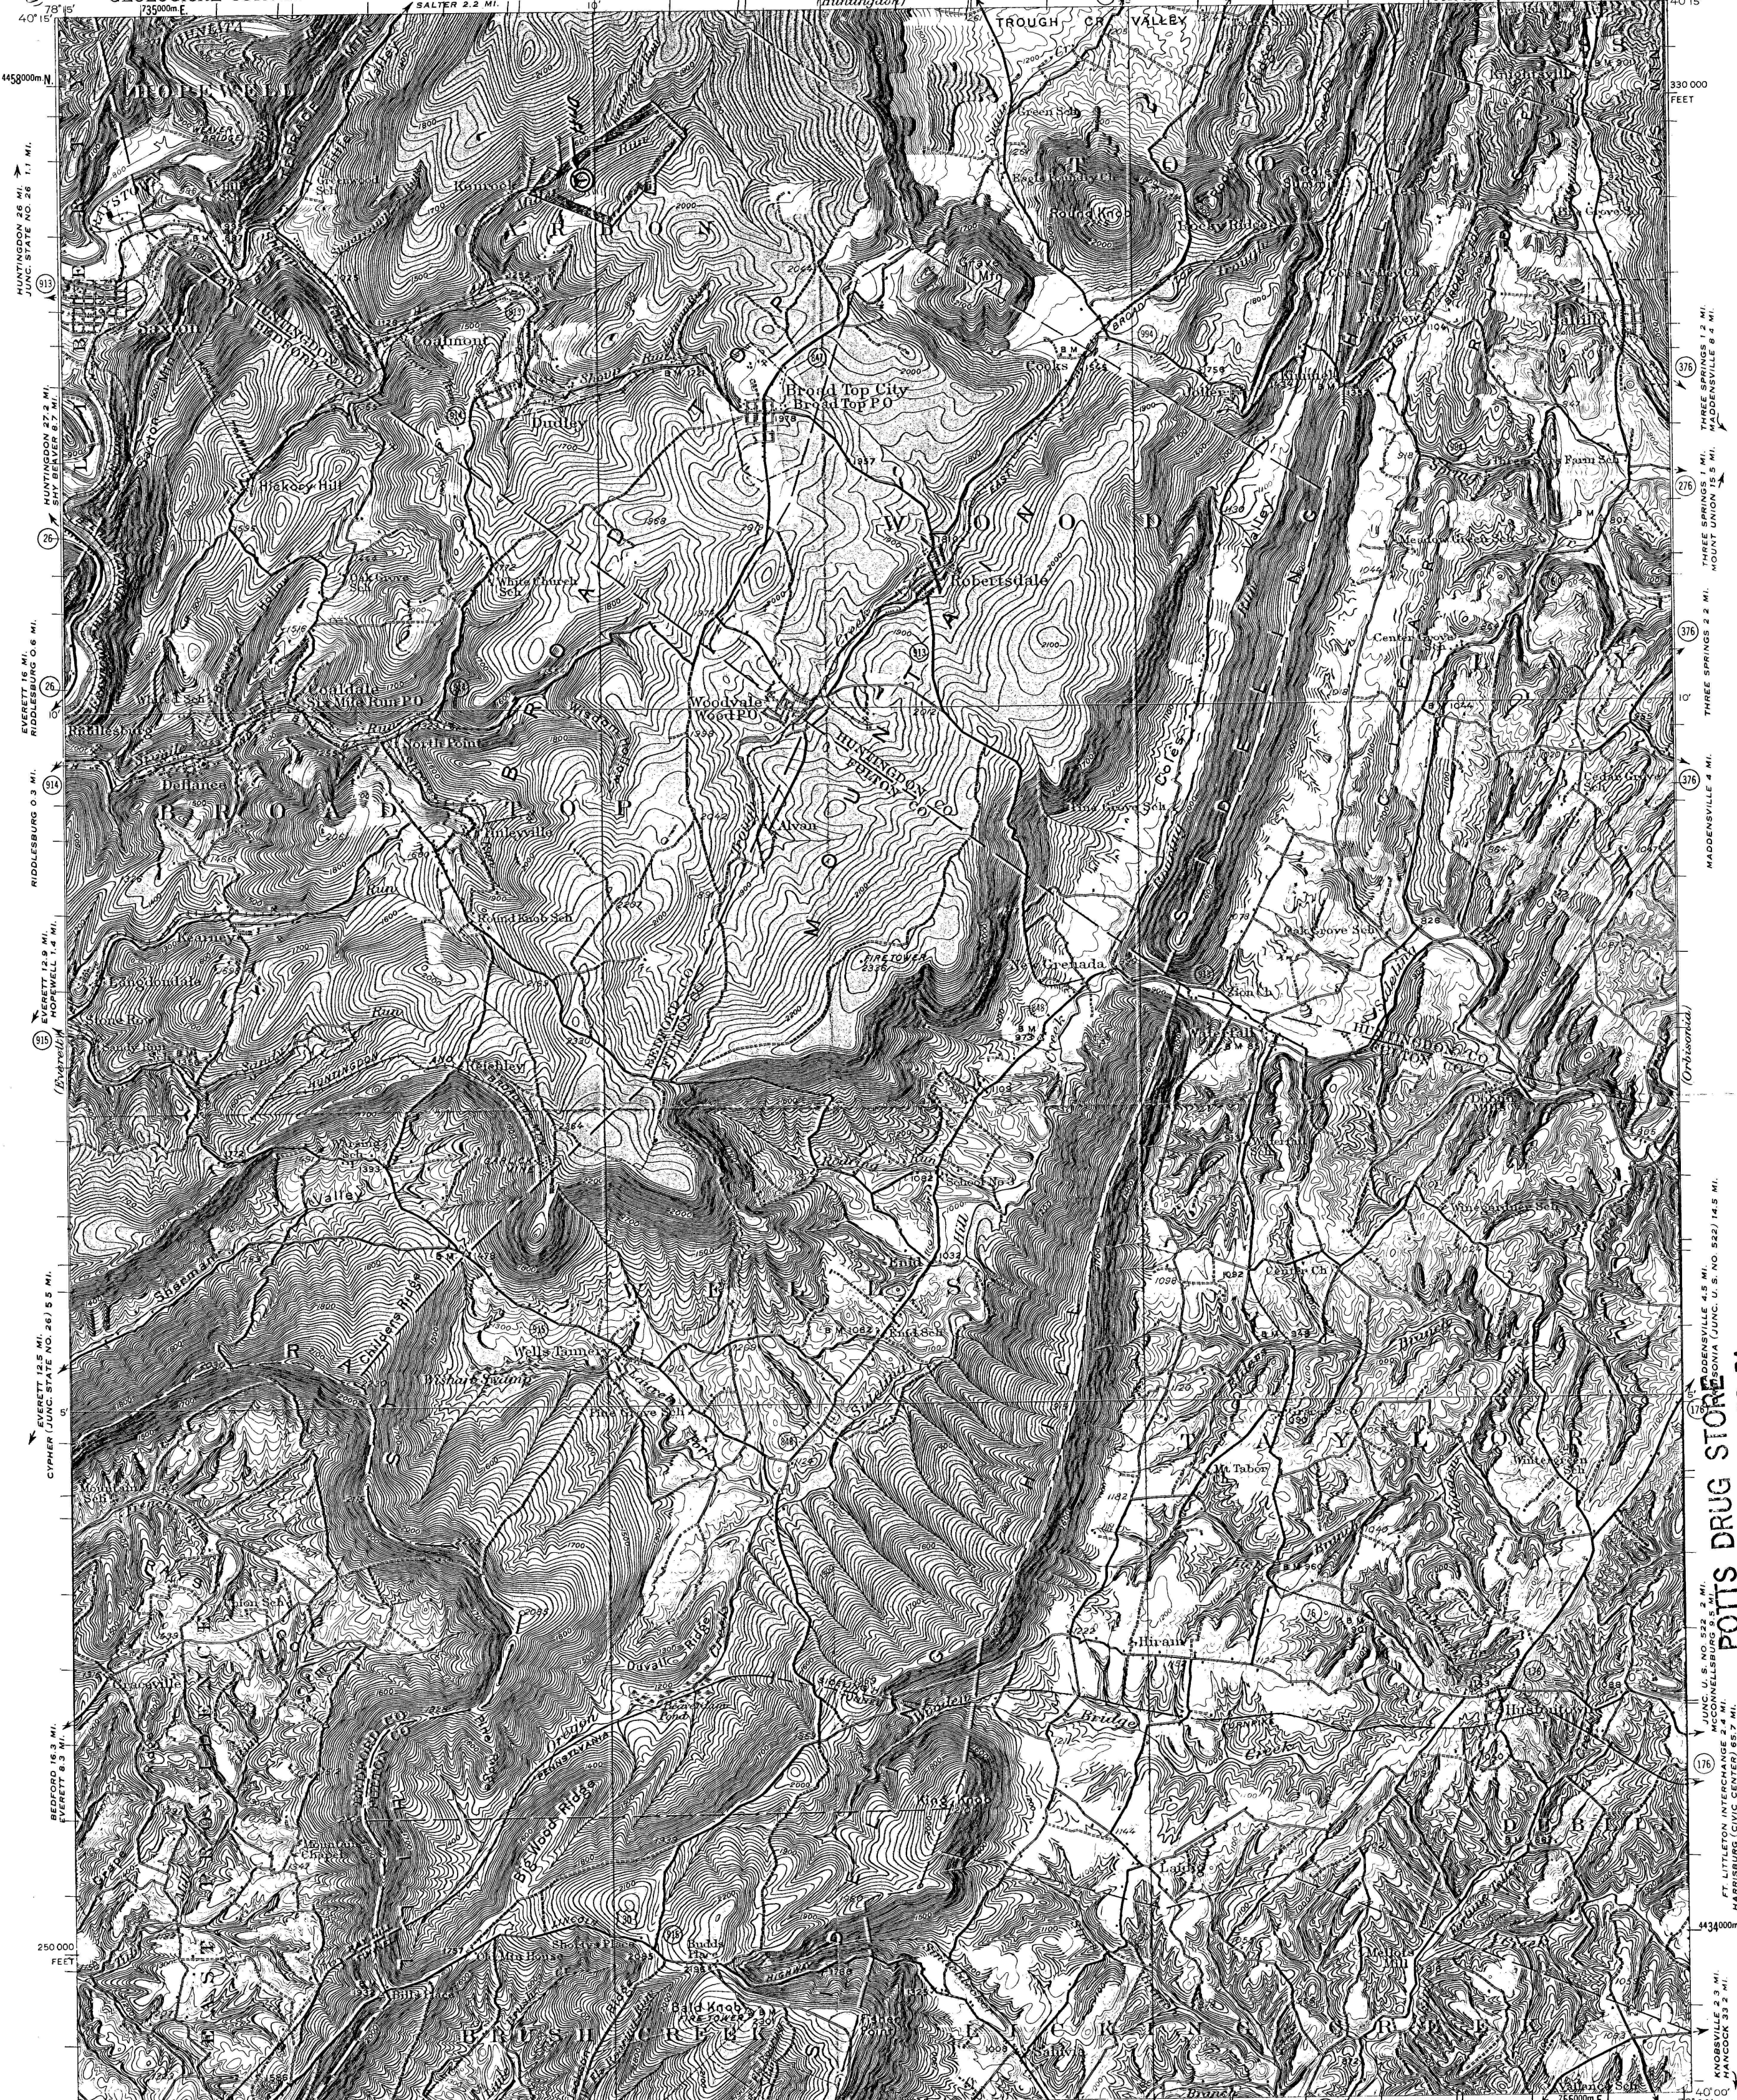

POTS DRUG STORE
1100 N. 3rd ST. HARRISBURG, PA.
AGENCY FOR U. S.
GEOLOGICAL SURVEY MAPS

Topography by C.W. Goodlove, J.K. Bailey,
R.F. Hamke, and W.A. Fisher.
Control by U.S. Geological Survey and
Pennsylvania State Highway Department
Surveyed in 1929-30
BREEZEWOOD INTERCHANGE 0.5 MI.
BEDFORD INTERCHANGE 17.5 MI.
EVERETT 9.2 MI.
APPROXIMATE MEAN
DECLINATION, 1930

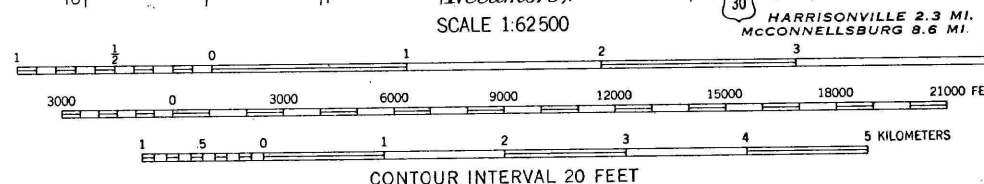

Needmore
SCALE 1:62,500
HARRISONVILLE 2.3 MI.
MC CONNELLSBURG 8.6 MI.
HARRISONVILLE 1 MI.
NEEDMORE 13.5 MI.
INTERIOR—GEOLOGICAL SURVEY,
WASHINGTON, D. C.—1965
Polyconic projection. 1927 North American datum
10,000-foot grid based on Pennsylvania (South)
rectangular coordinate system
1000-meter Universal Transverse Mercator grid ticks,
zone 17, shown in blue
JUNC. U.S. NO. 30 1.6 MI.
HARRISONVILLE 2.4 MI.
MC CONNELLSBURG 5.2 MI.
BROAD TOP, PA.
N 4000—W 7800/15
1930

FOR SALE BY U.S. GEOLOGICAL SURVEY, WASHINGTON 25, D. C.
A FOLDER DESCRIBING TOPOGRAPHIC MAPS AND SYMBOLS IS AVAILABLE ON REQUEST

ROUTES USUALLY TRAVELED
HARD IMPROVED SURFACES
OTHER SURFACE IMPROVEMENTS
U. S. ROUTE 1945
STATE ROUTE
Ace Coal Co. Chamberland No 3 -
Carbon Twp. Huntingdon County Penna.
Oct. 1966. E. Corrie