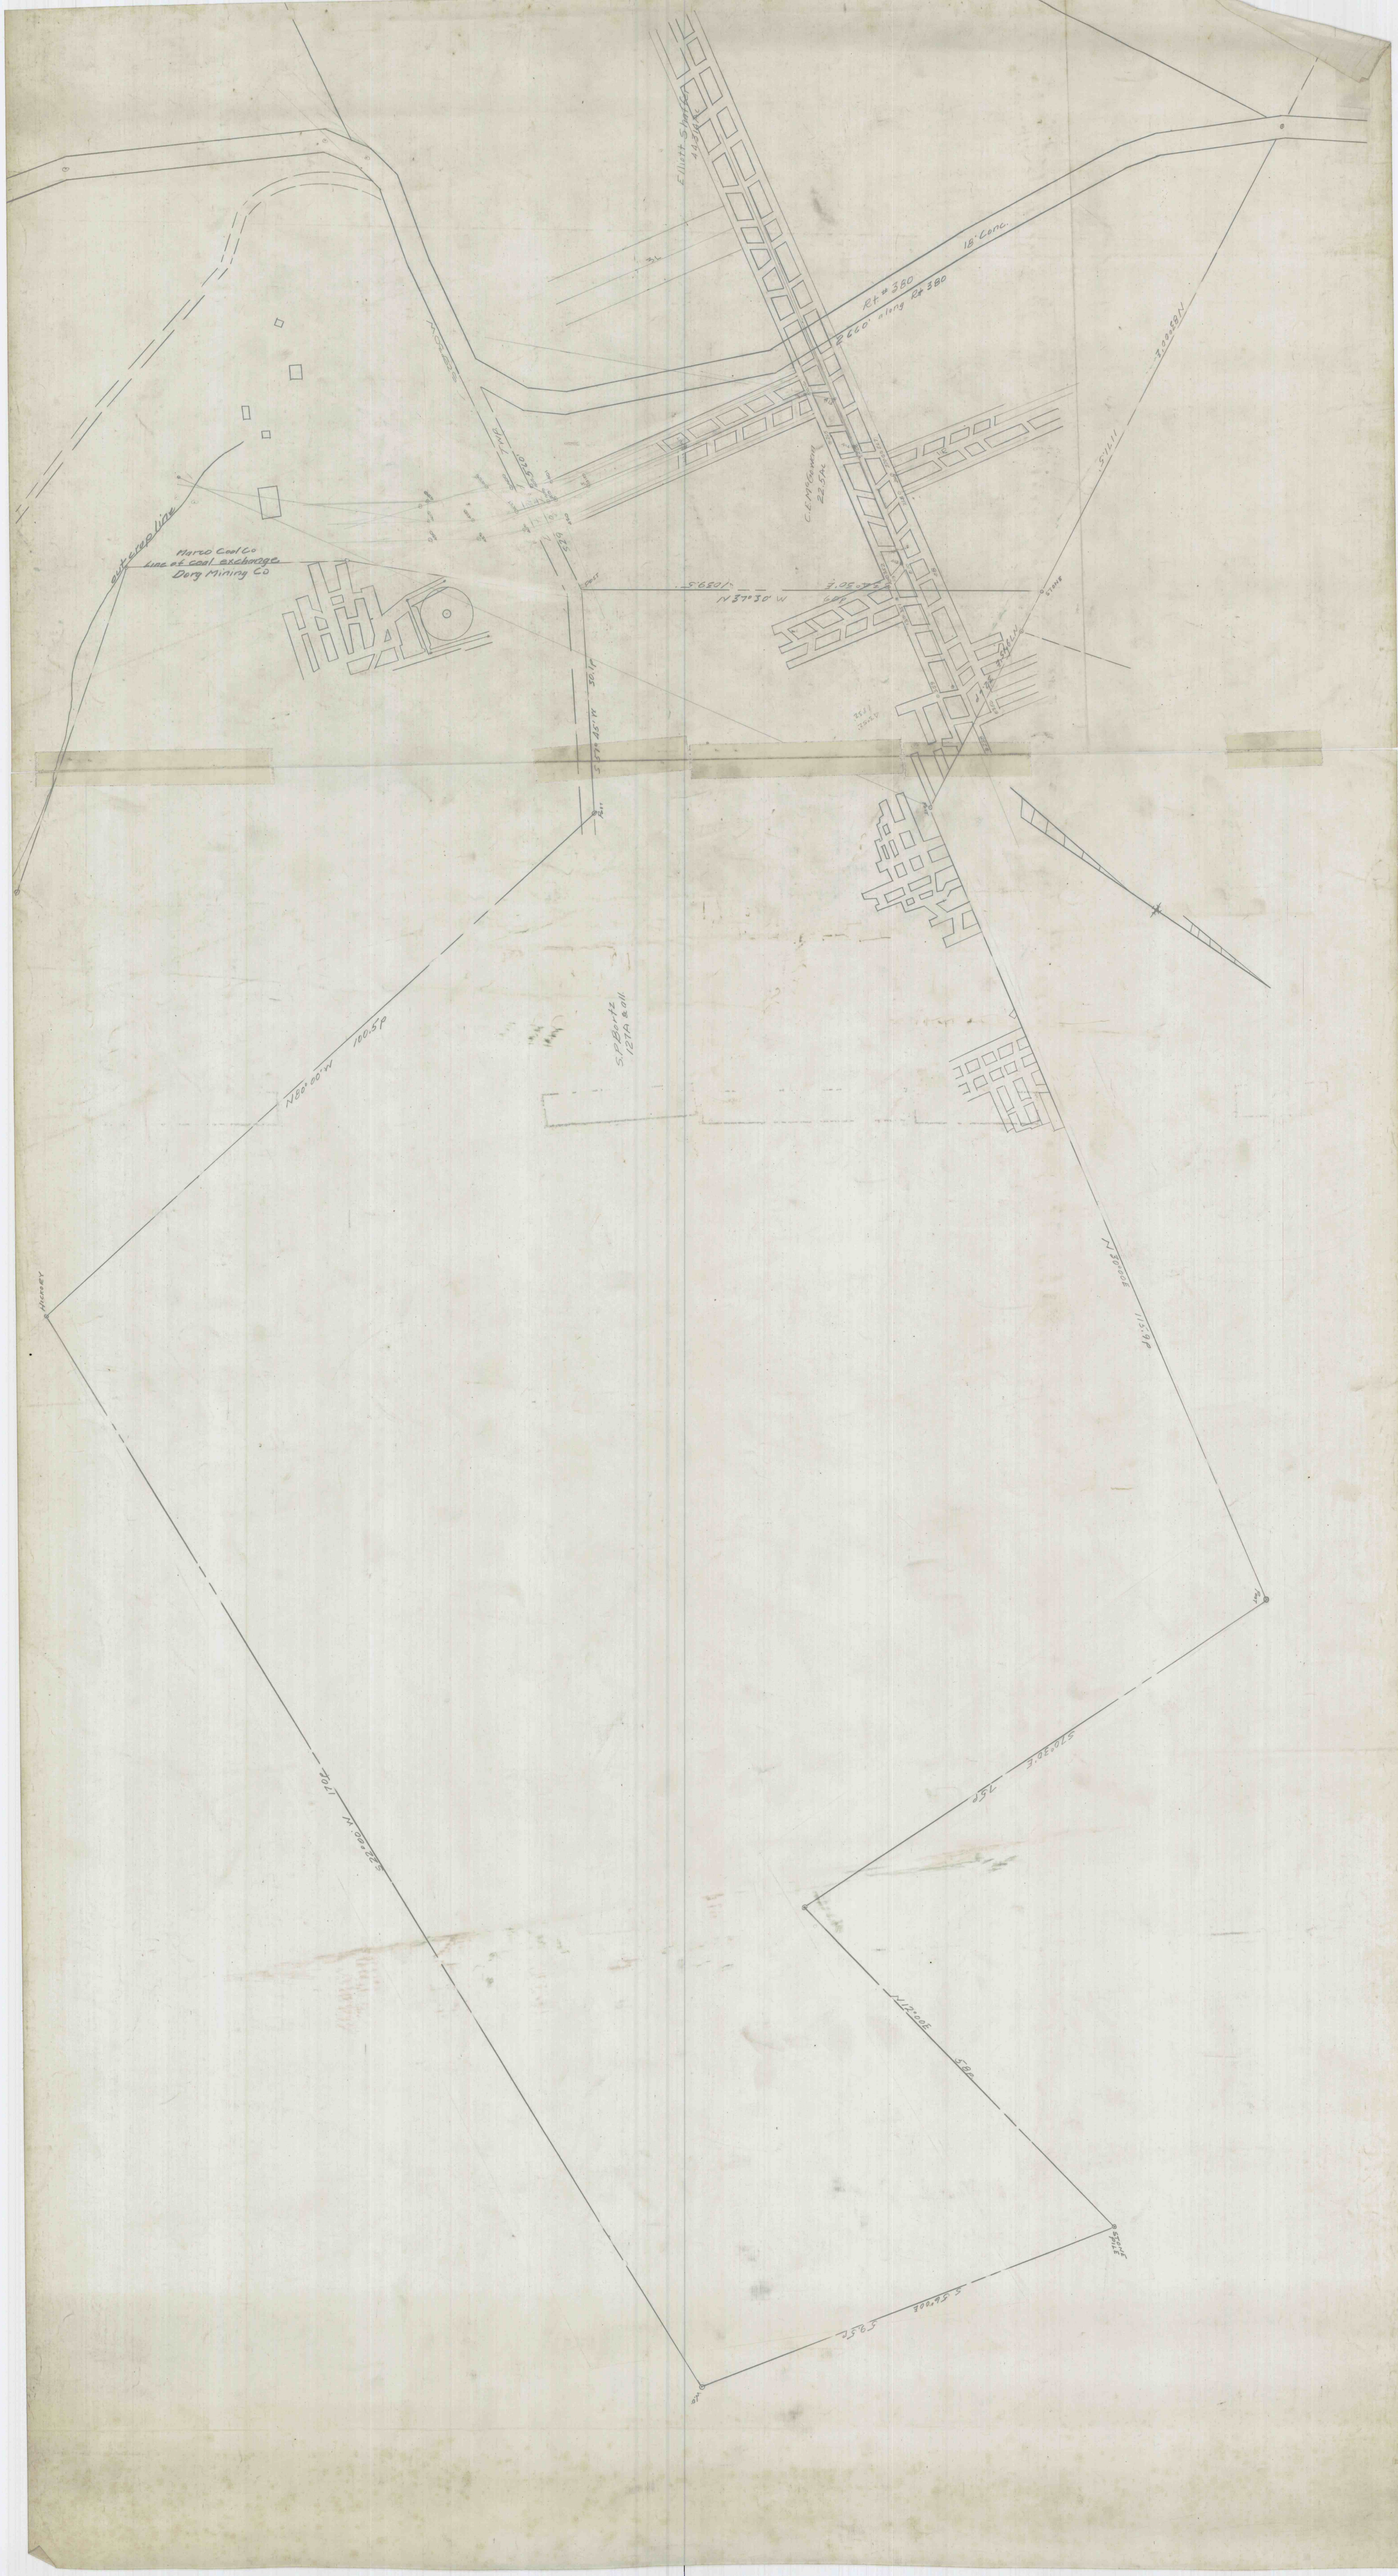
Elliott Shaft
18' Conc.
Rt. # 380
Rt. # 380
Hanna Coal Co
use of coal exchange
Dorg Mining Co
N 37°30' W
N 38°45' W
N 60°00' W
160.5P
S 72°30' E
S 62°00' E
S 62°00' W
170'
Hanney
Stake