


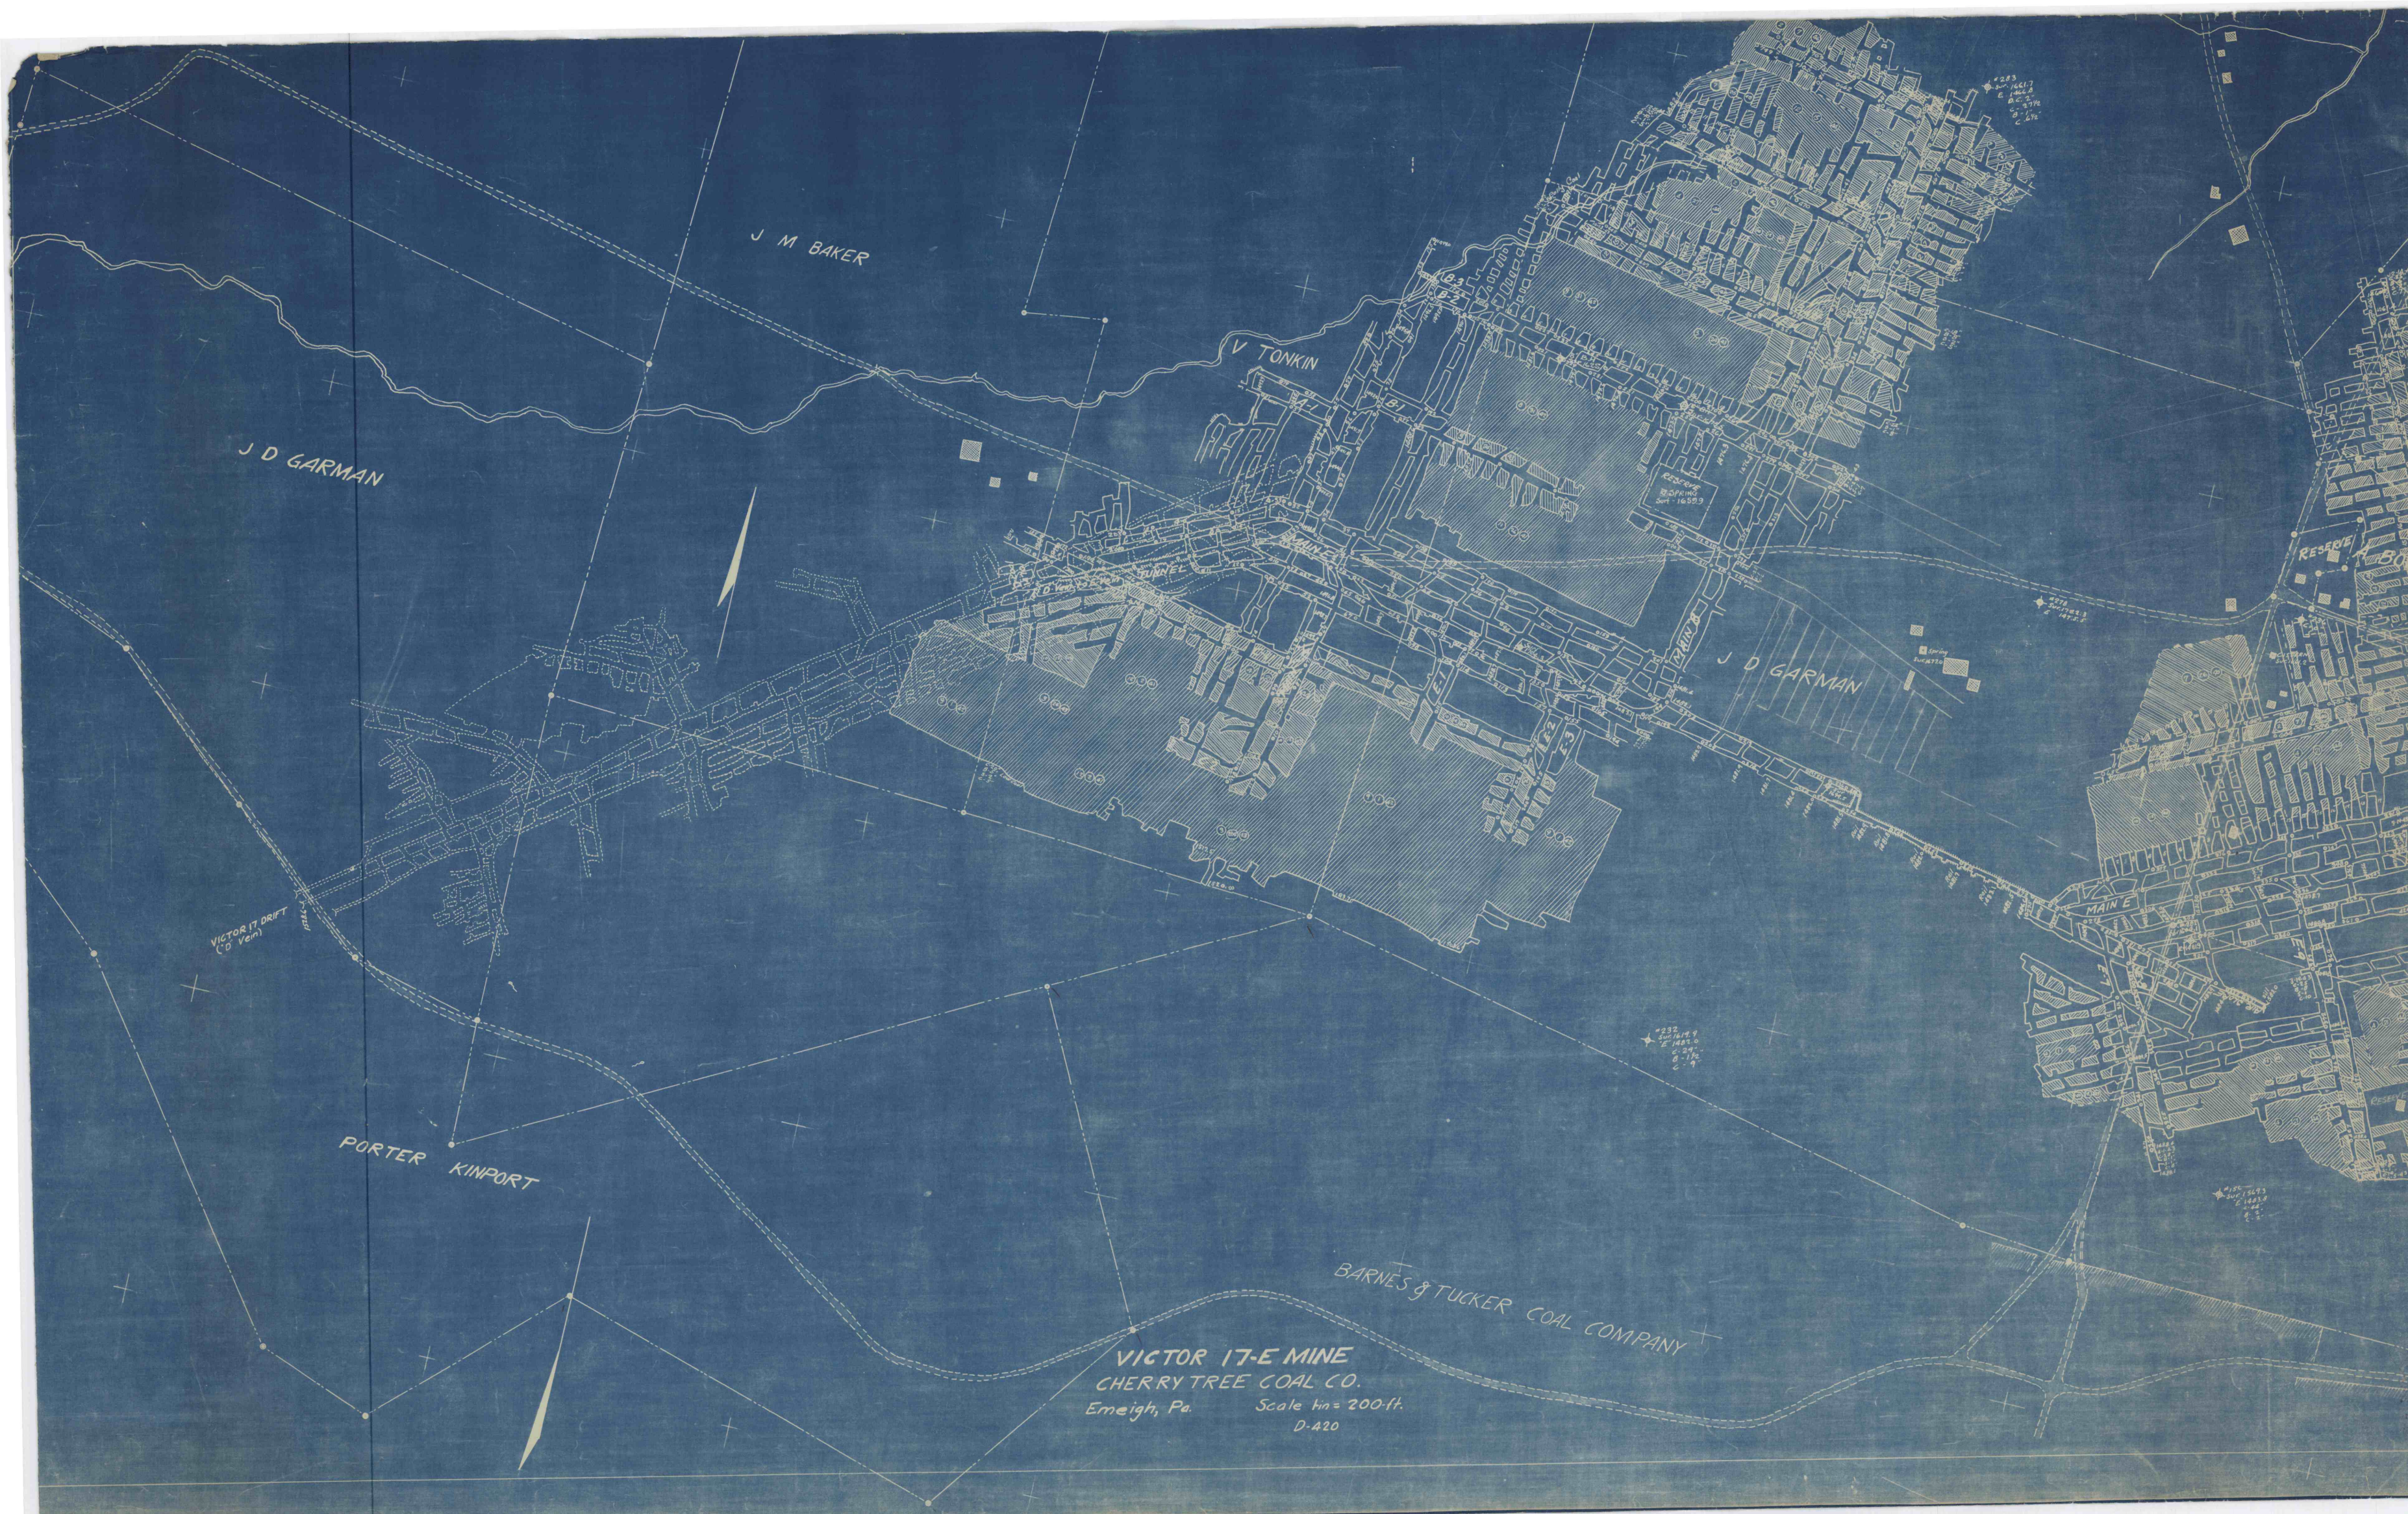

J M BAKER

J D GARMAN

V TONKIN

J D GARMAN

VICTOR 17 DRIFT
(D Vein)

PORTER KINPORT

BARNES & TUCKER COAL COMPANY

VICTOR 17-E MINE
CHERRY TREE COAL CO.
Emeigh, Pa. Scale 1 in = 200 ft.
D-420