
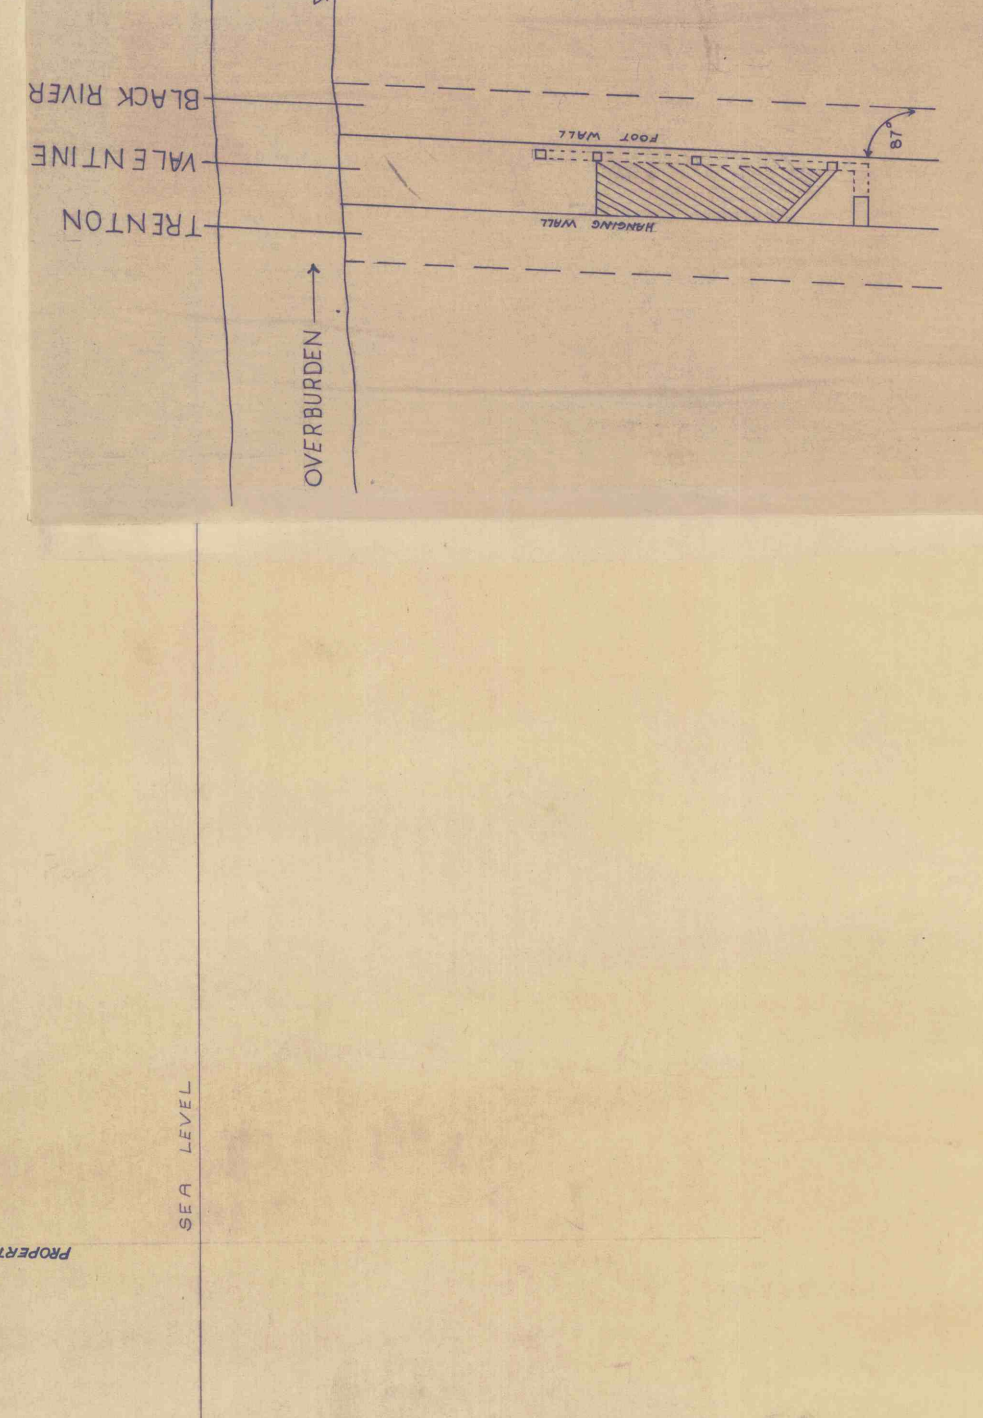


 

DOMTAR
BELLEFONTE MINE
LONGITUDINAL SECTION
SCALE: 1 INCH = 100 FEET

● FAN
— ESCALWAY
— SECONDARY ESCALWAY
← AIR FLOW

ALL MINING AS OF APRIL 1950
REVISIONS

Approved: *[Signature]* 4/10/50
Checked: *[Signature]* 4/10/50
By: *[Signature]* 4/10/50
CHART 30-100