


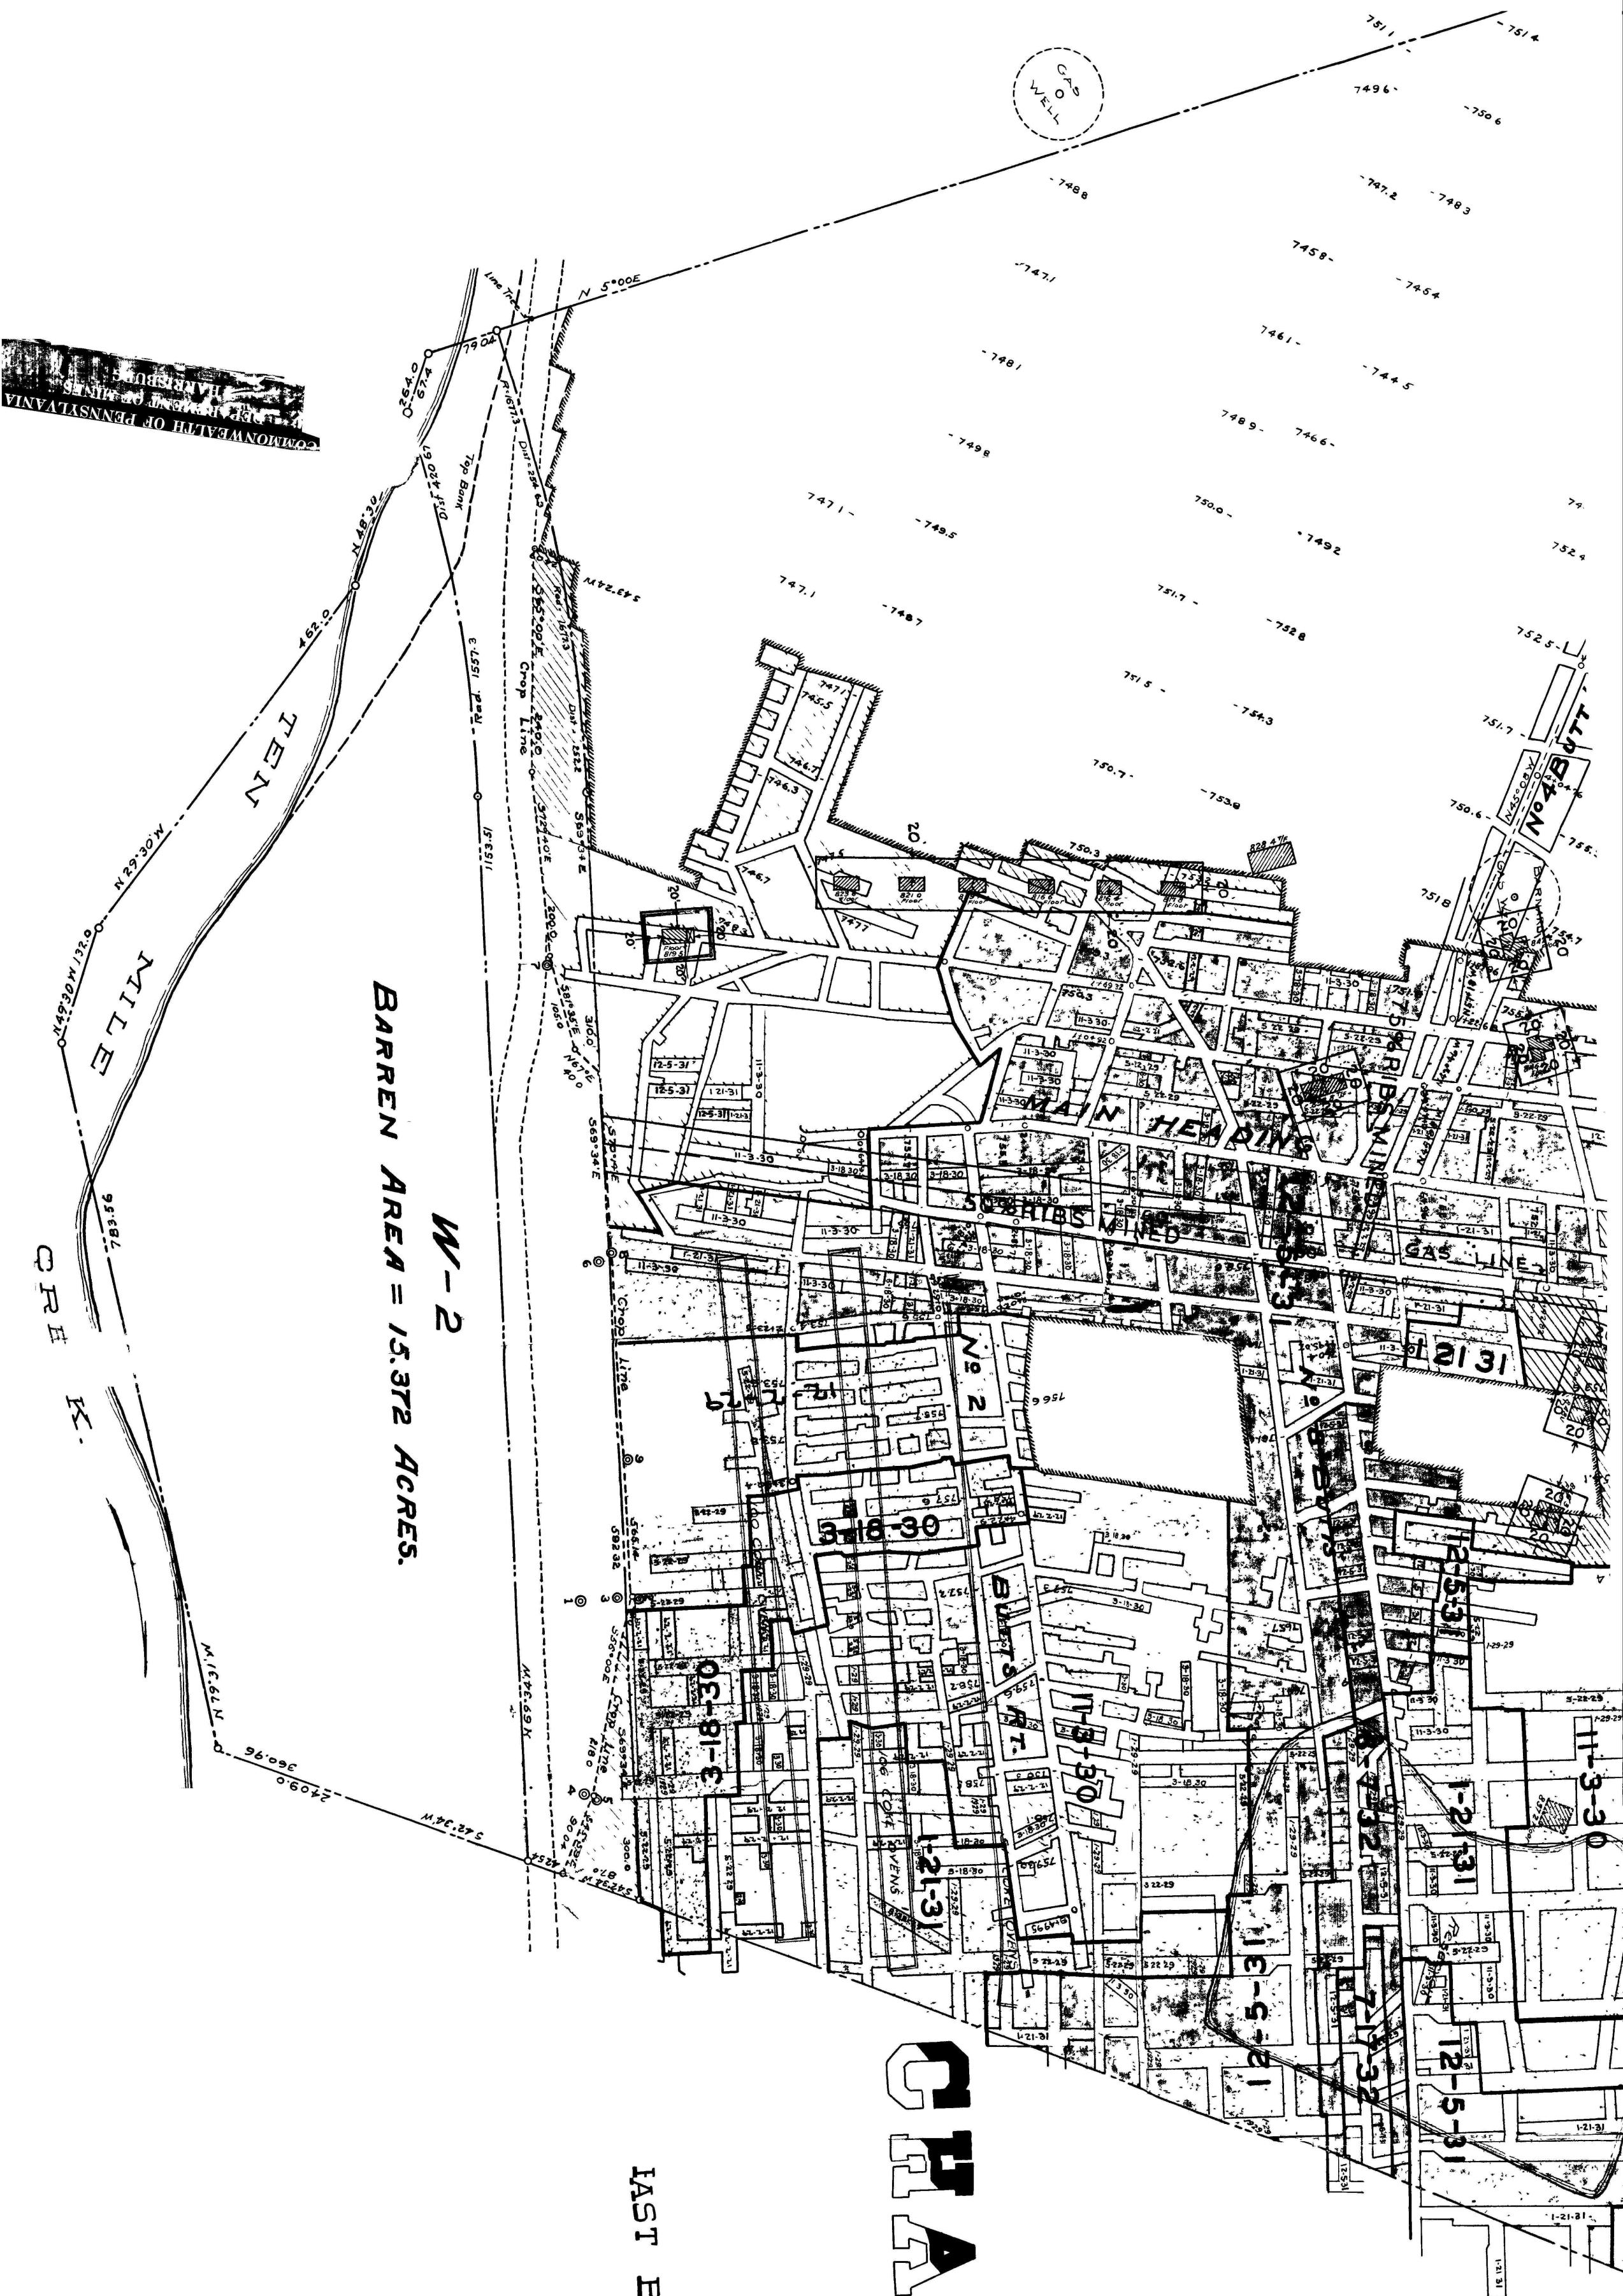

CHAMPION MINE

EAST BETHLEHEM TWP., WASHINGTON COUNTY, PA.

SCALE - 1 IN. = 100 FT. FEBRUARY 1914

TRACED FROM BLUEPRINT BY JOHN M. RAYBURN.

EXTENSIONS

- MAY 14, 1925.
- DEC. 1, 1927.
- JAN. 26, 1929.
- MAY. 22, 1929.
- DEC. 2, 1929.
- MAR. 18, 1930.
- NOV. 3, 1930.
- JAN. 21, 1931.
- DEC. 5, 1931.
- JUNE 7, 1932.
- JULY 17, 1932.

COLUMNAR SECTION OF BORE HOLES

