


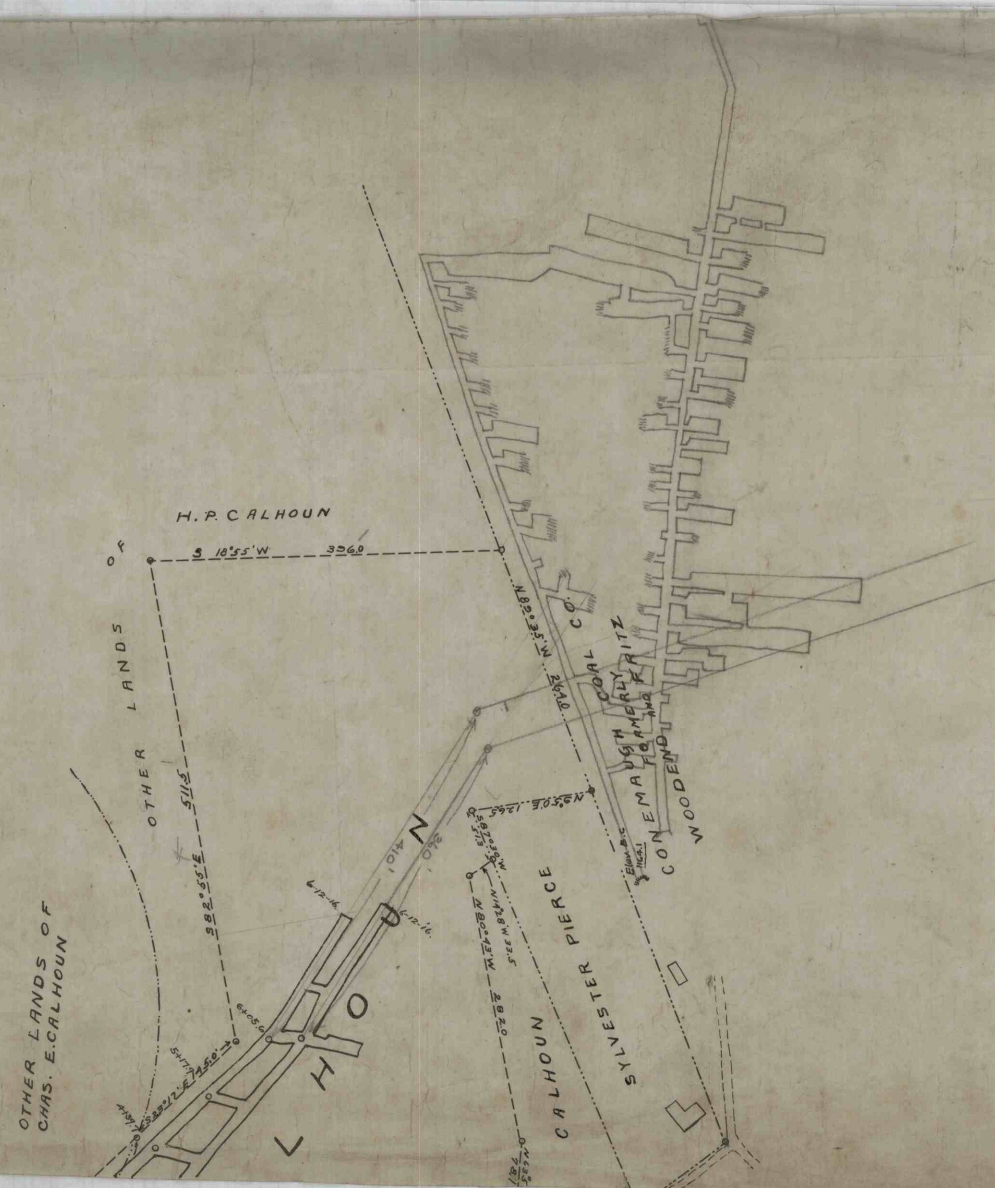

Con 3620