


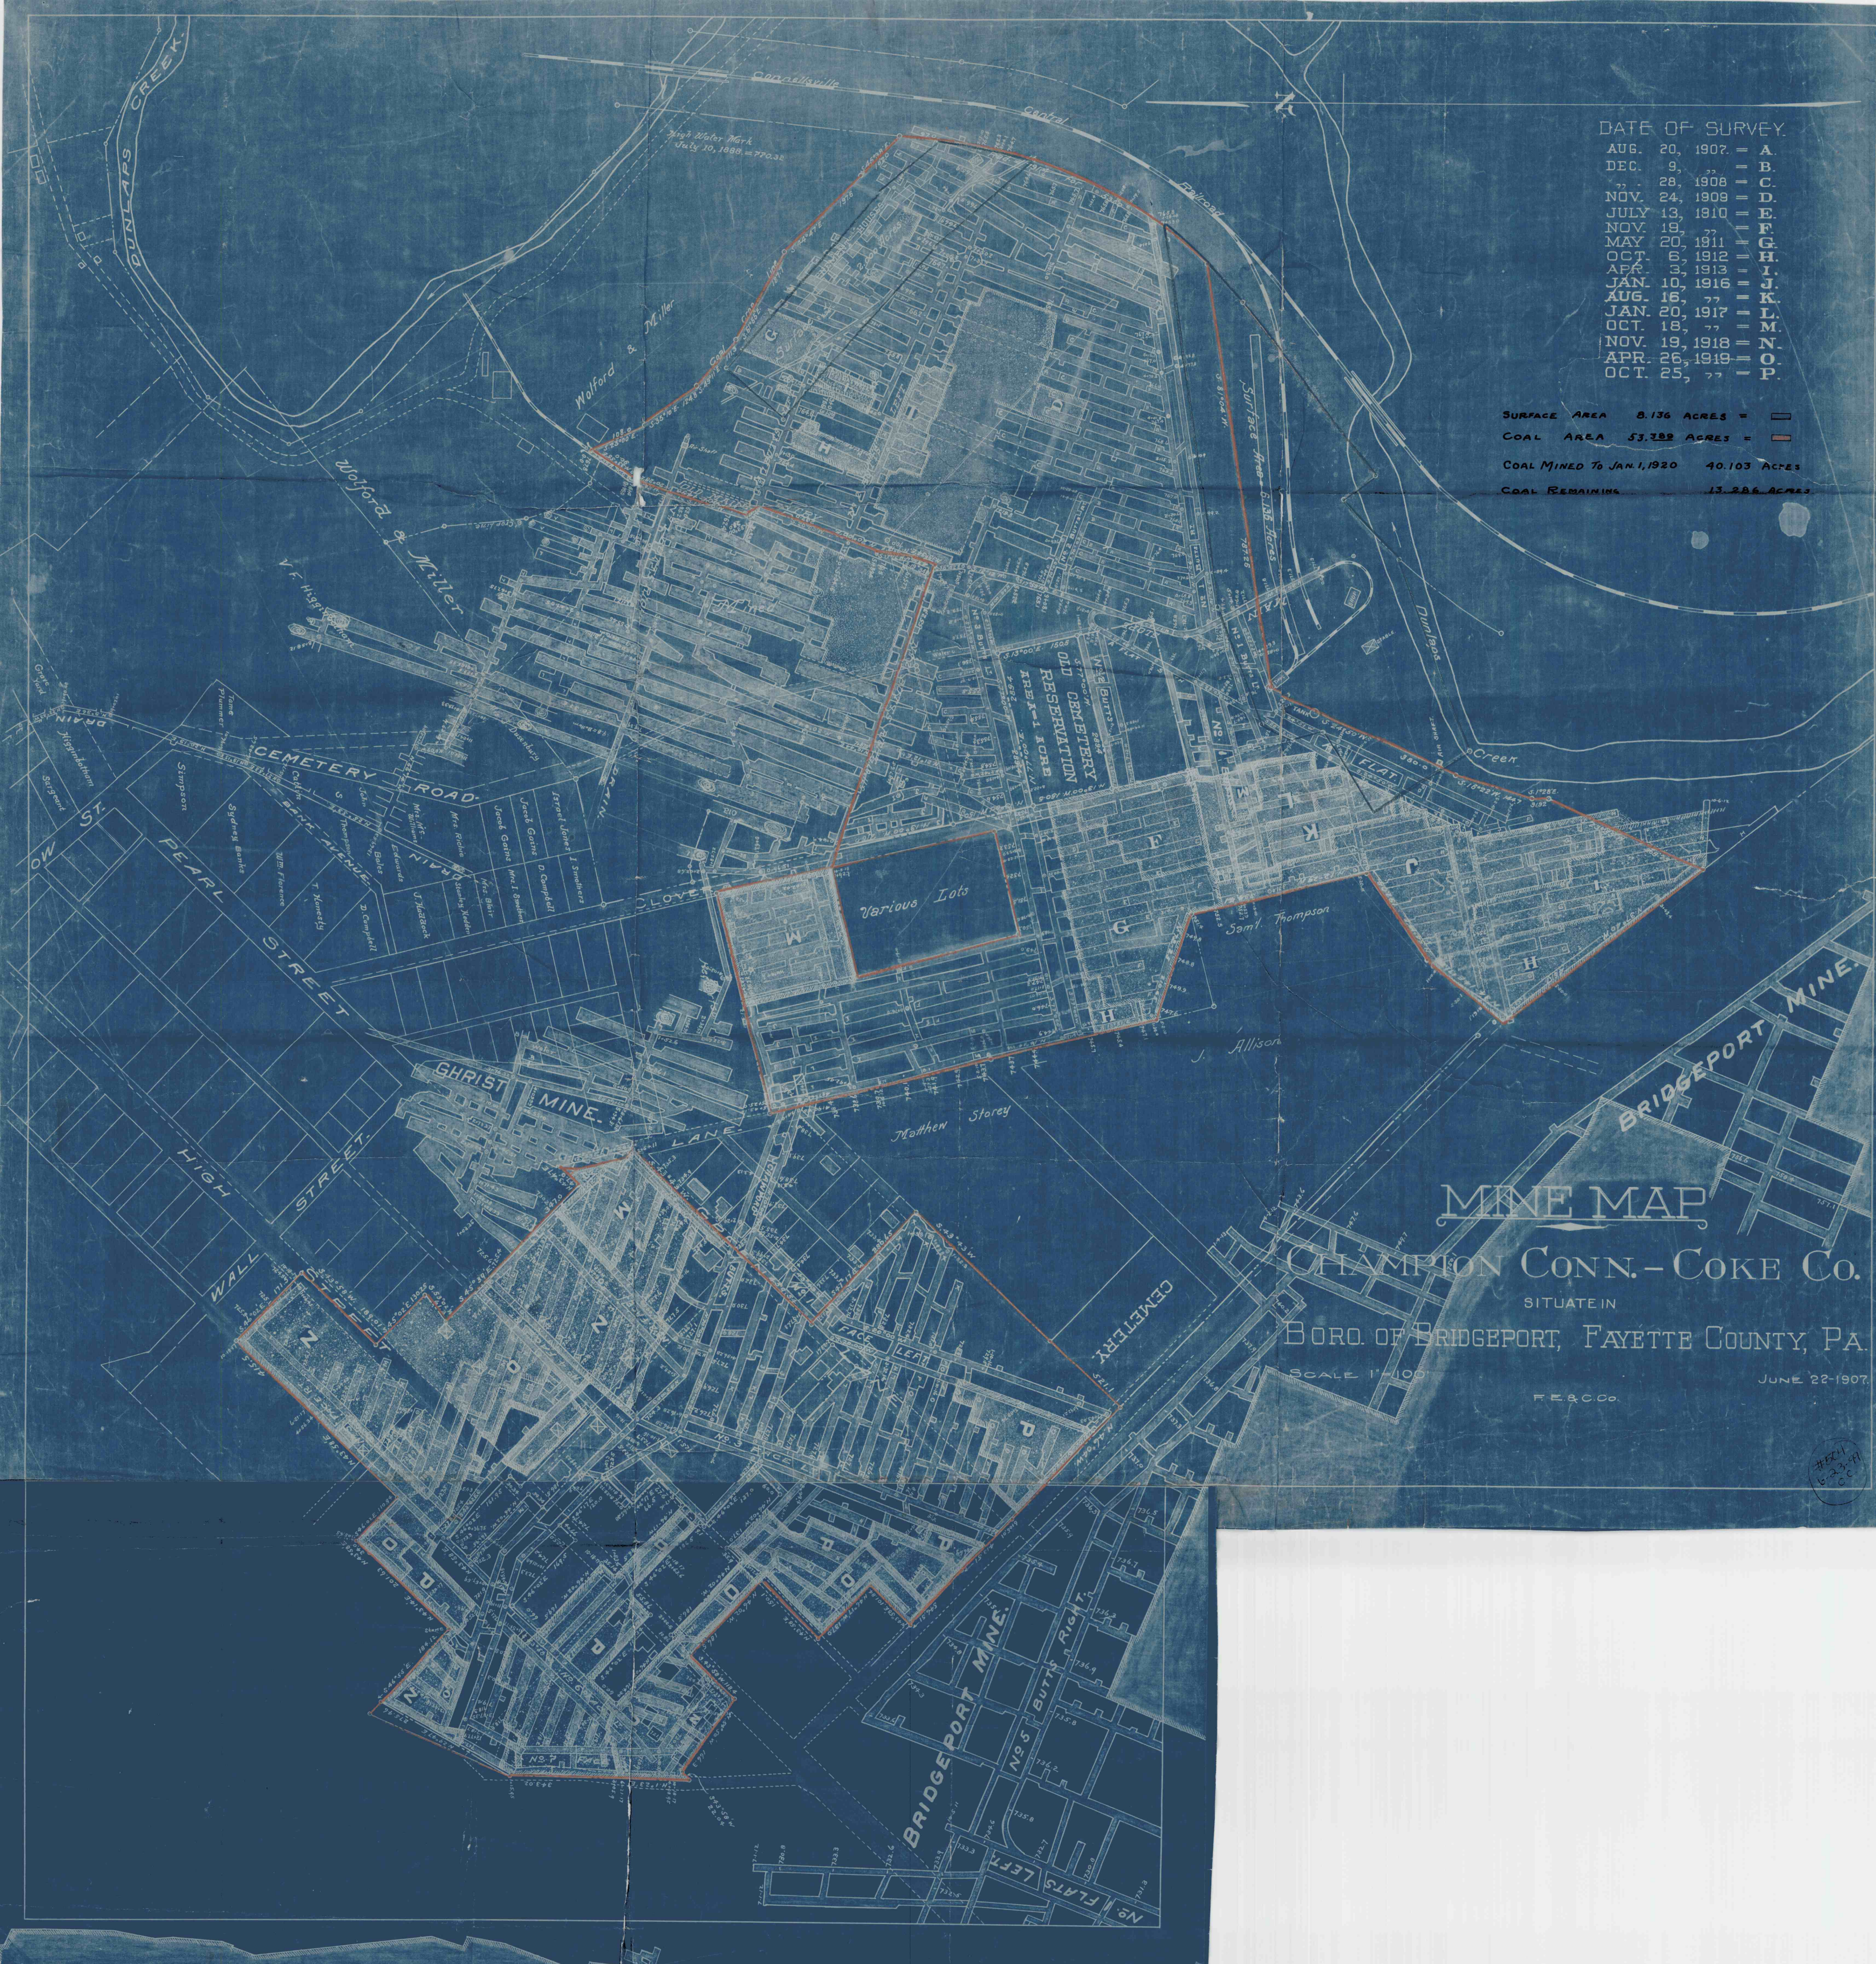

DATE OF SURVEY.

AUG.	20,	1902	=	A.
DEC.	9,	"	=	B.
"	28,	1908	=	C.
NOV.	24,	1909	=	D.
JULY	13,	1910	=	E.
NOV.	19,	"	=	F.
MAY	20,	1911	=	G.
OCT.	6,	1912	=	H.
APR.	8,	1913	=	I.
JAN.	10,	1916	=	J.
AUG.	16,	"	=	K.
JAN.	20,	1917	=	L.
OCT.	18,	"	=	M.
NOV.	19,	1918	=	N.
APR.	26,	1919	=	O.
OCT.	25,	"	=	P.

SURFACE AREA 8.136 ACRES =
COAL AREA 53.322 ACRES =
COAL MINED TO JAN. 1, 1920 40.103 ACRES
COAL REMAINING 13.226 ACRES

MINE MAP
CHAMPTON CONN.-COKE CO.
SITUATE IN
BORO OF BRIDGEPORT, FAYETTE COUNTY, PA.
SCALE 1"=100'
FEB 20 1900
JUNE 22-1907.

#23-11
6-23-11
C.C.