


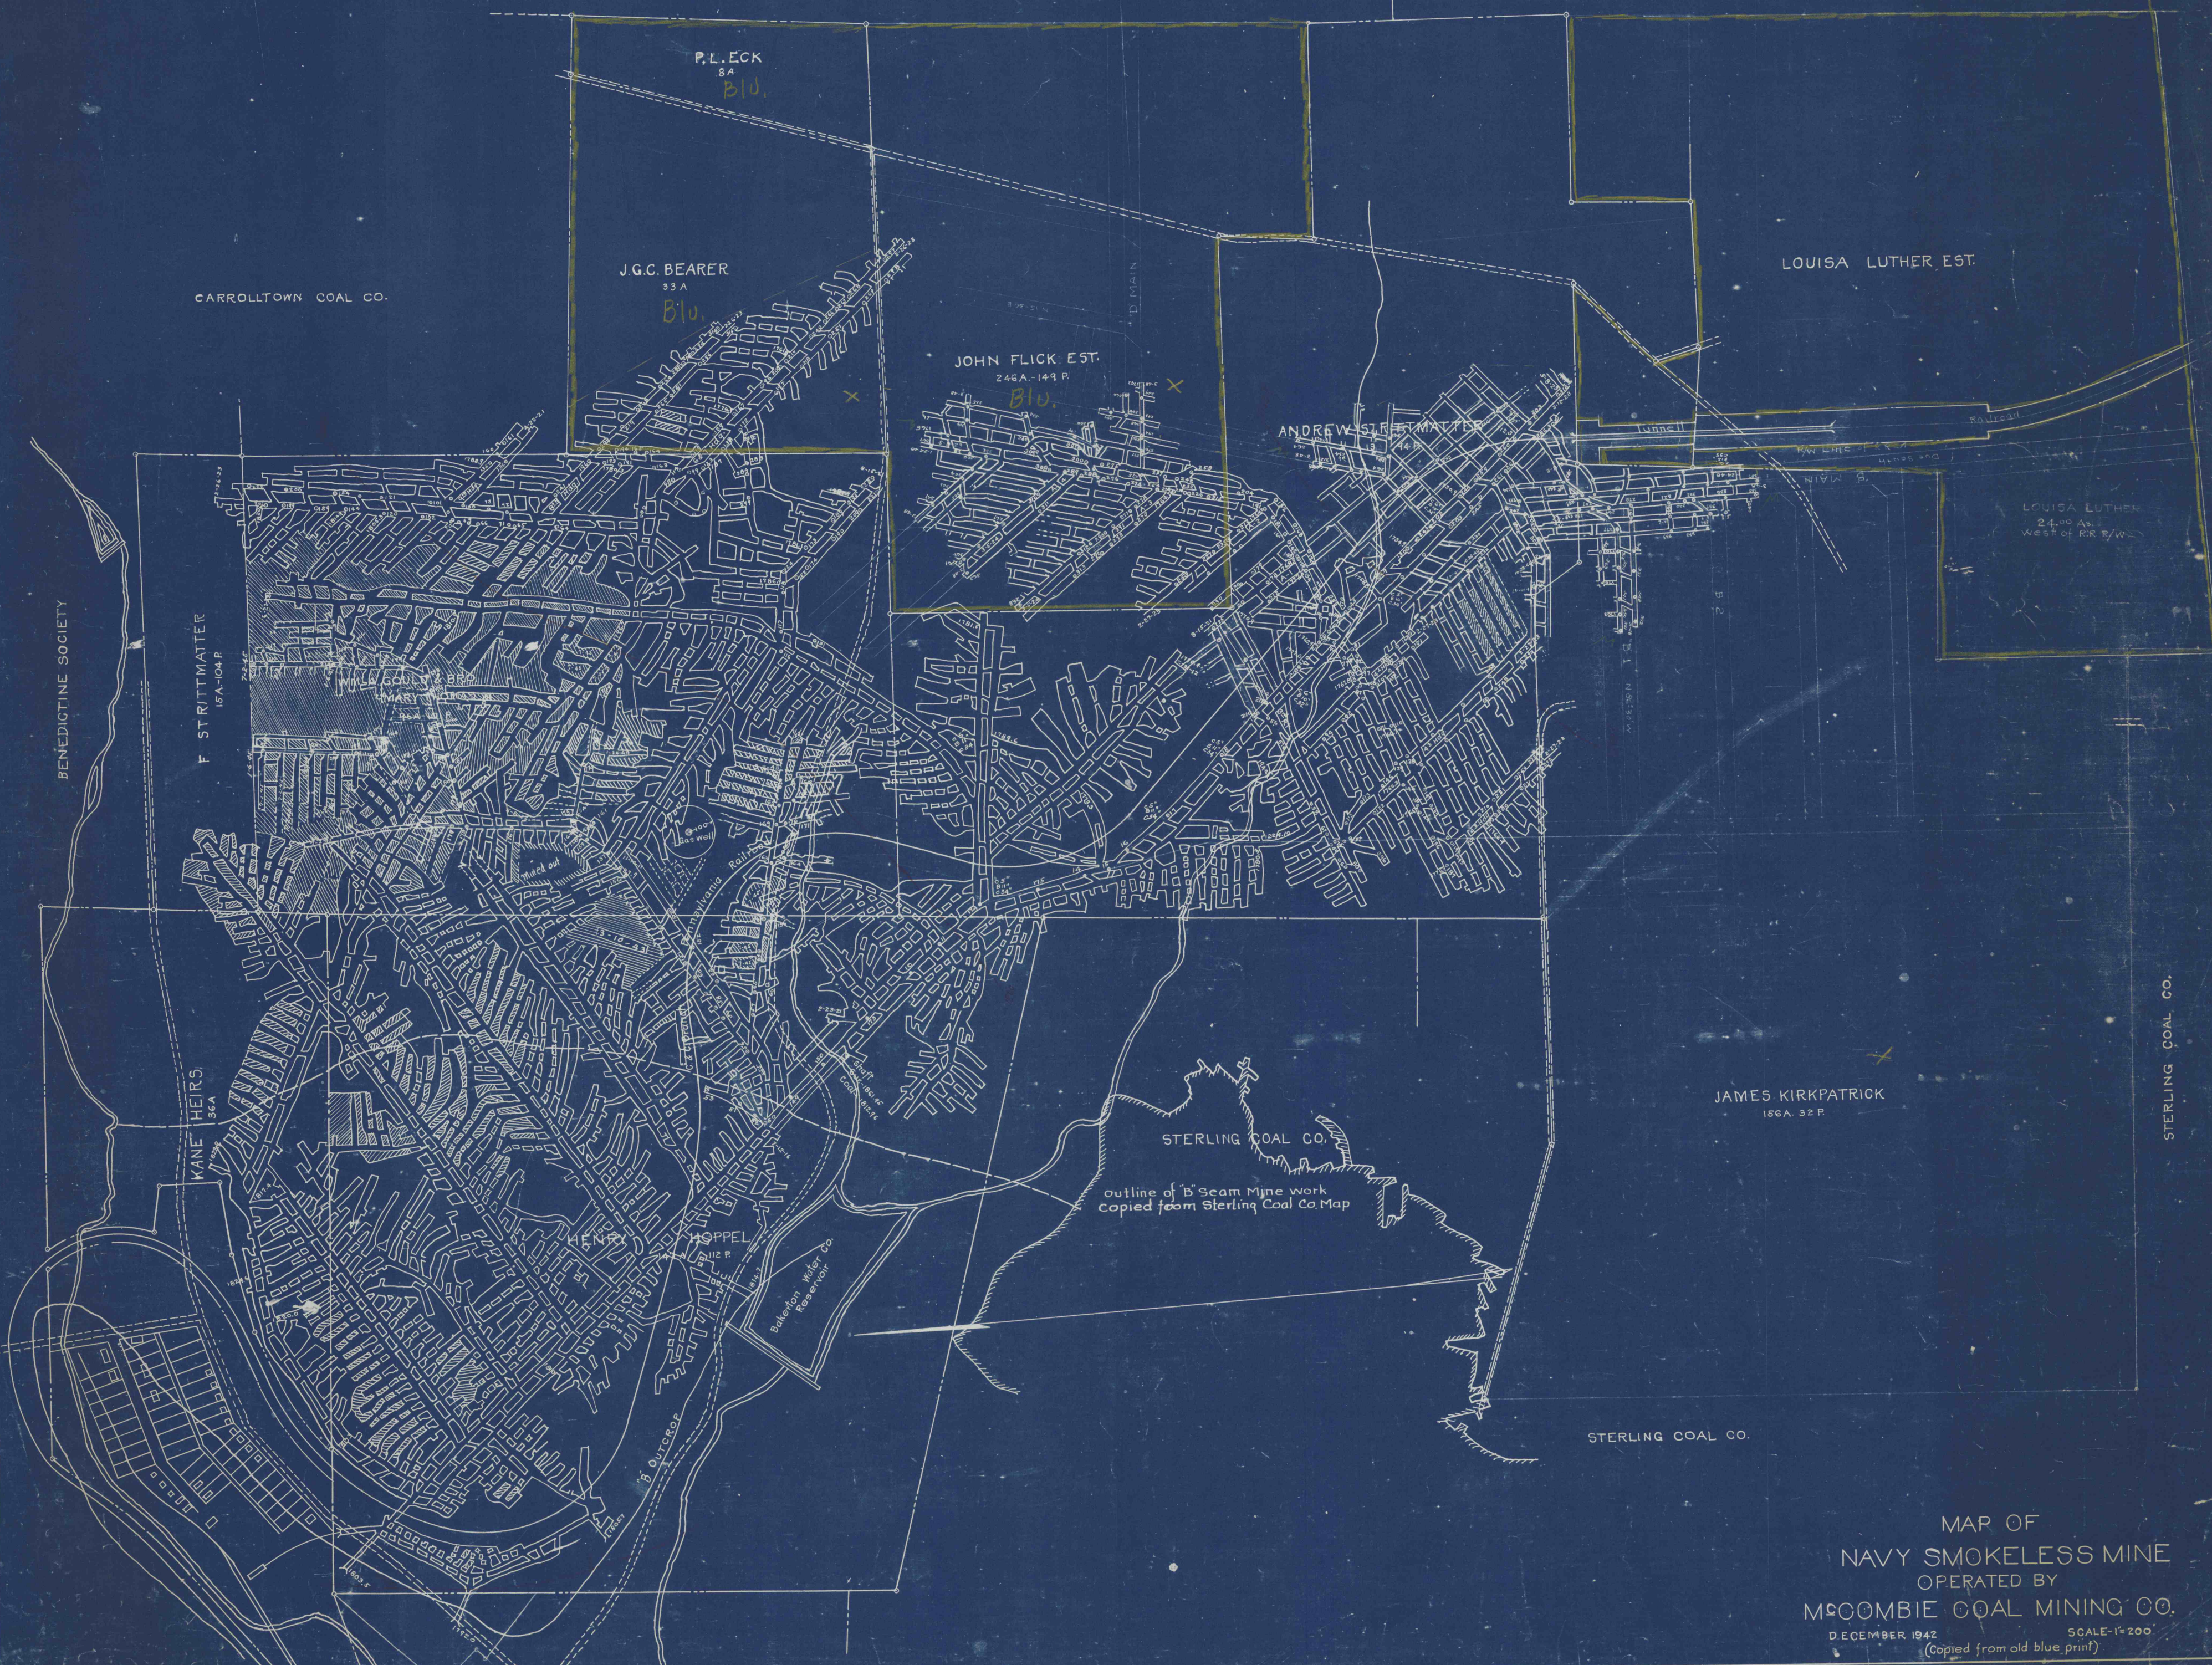

MAP OF
NAVY SMOKELESS MINE
OPERATED BY
MCCOMBIE COAL MINING CO.
DECEMBER 1942
SCALE 1"=200'
(Copied from old blue print)