


American Premier Underwriters, Inc. and United Railroad Corp. disclaim any representation or duty to any person as to the accuracy or completeness of this map or its fitness for any particular mining, safety or real estate related purpose. Any person who uses this map for any reason undertakes an independent duty to verify its accuracy and completeness, and assumes all risks of its use, and agrees to hold American Premier Underwriters, Inc., United Railroad Corp. and their respective affiliates, shareholders, directors, officers and employees harmless from damage or liability arising from its use.

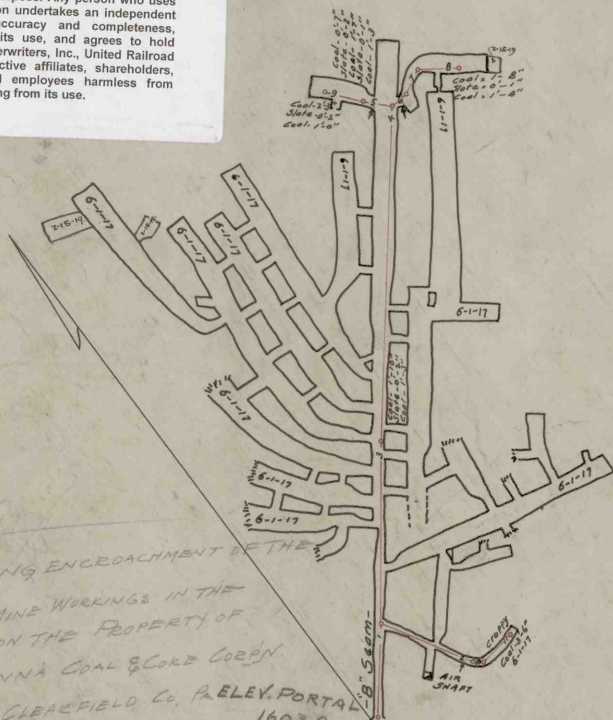

MAP SHOWING ENCROACHMENT OF THE
P.B. MONS' MINE WORKINGS IN THE
B" SEAM ON THE PROPERTY OF
THE PENNA COAL & COKE CORP.
COOPER TWP. CLEARFIELD CO. PA. ELEV. PORTAL
INCL. DEPT. P.C. & C. CORP. PATTON PA. 16038
SCALE 1"=100' JUNE 2, 1917.

MAP
OF
P.B. MONS' COUNTRY MINE
KYLERTOWN, PENN'A
Scale 1"=100 June 1, 1917.
ENGR. DEPT., P.C. & C. CORP., PATTON, PA.