
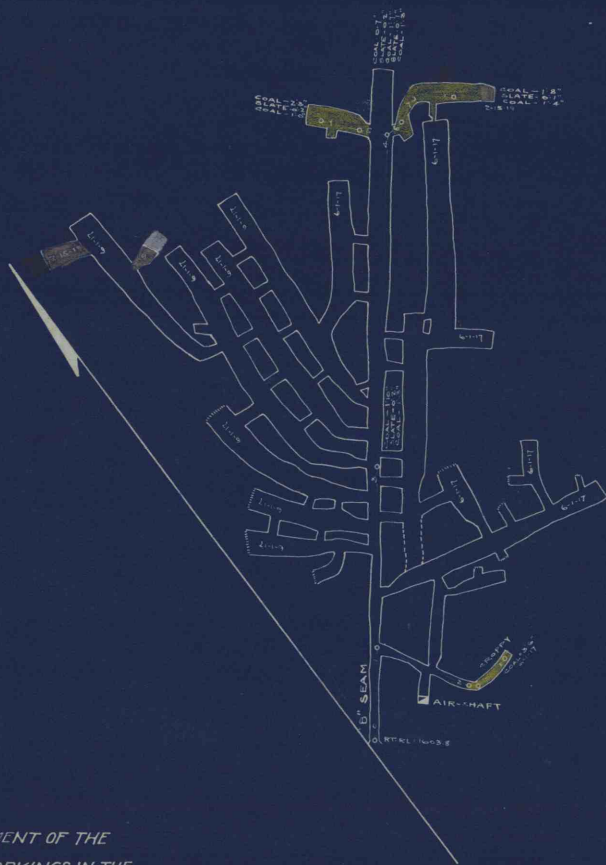


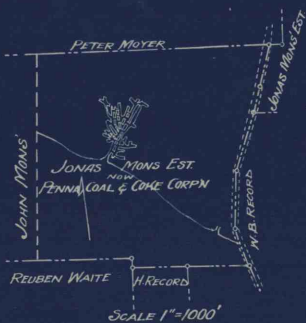

MAP

SHOWING ENCROACHMENT OF THE
P.B. MONS' MINE WORKINGS IN THE
"B" SEAM ON THE PROPERTY OF THE
PENNA COAL & COKE CORPN.
COOPER TOWNSHIP, CLEARFIELD CO. PA.

ENGR. DEPT. P.C. & C. CORPN. PITTON, PA.
SCALE 1"=100' JUNE 2, 1917

	FIRST ENCROACHMENT = 521 GR. TONS.
	SECOND " = 137 " "
	THIRD " = 36 " "
TOTAL TO 4-1-20 = 694 GR. TONS	