


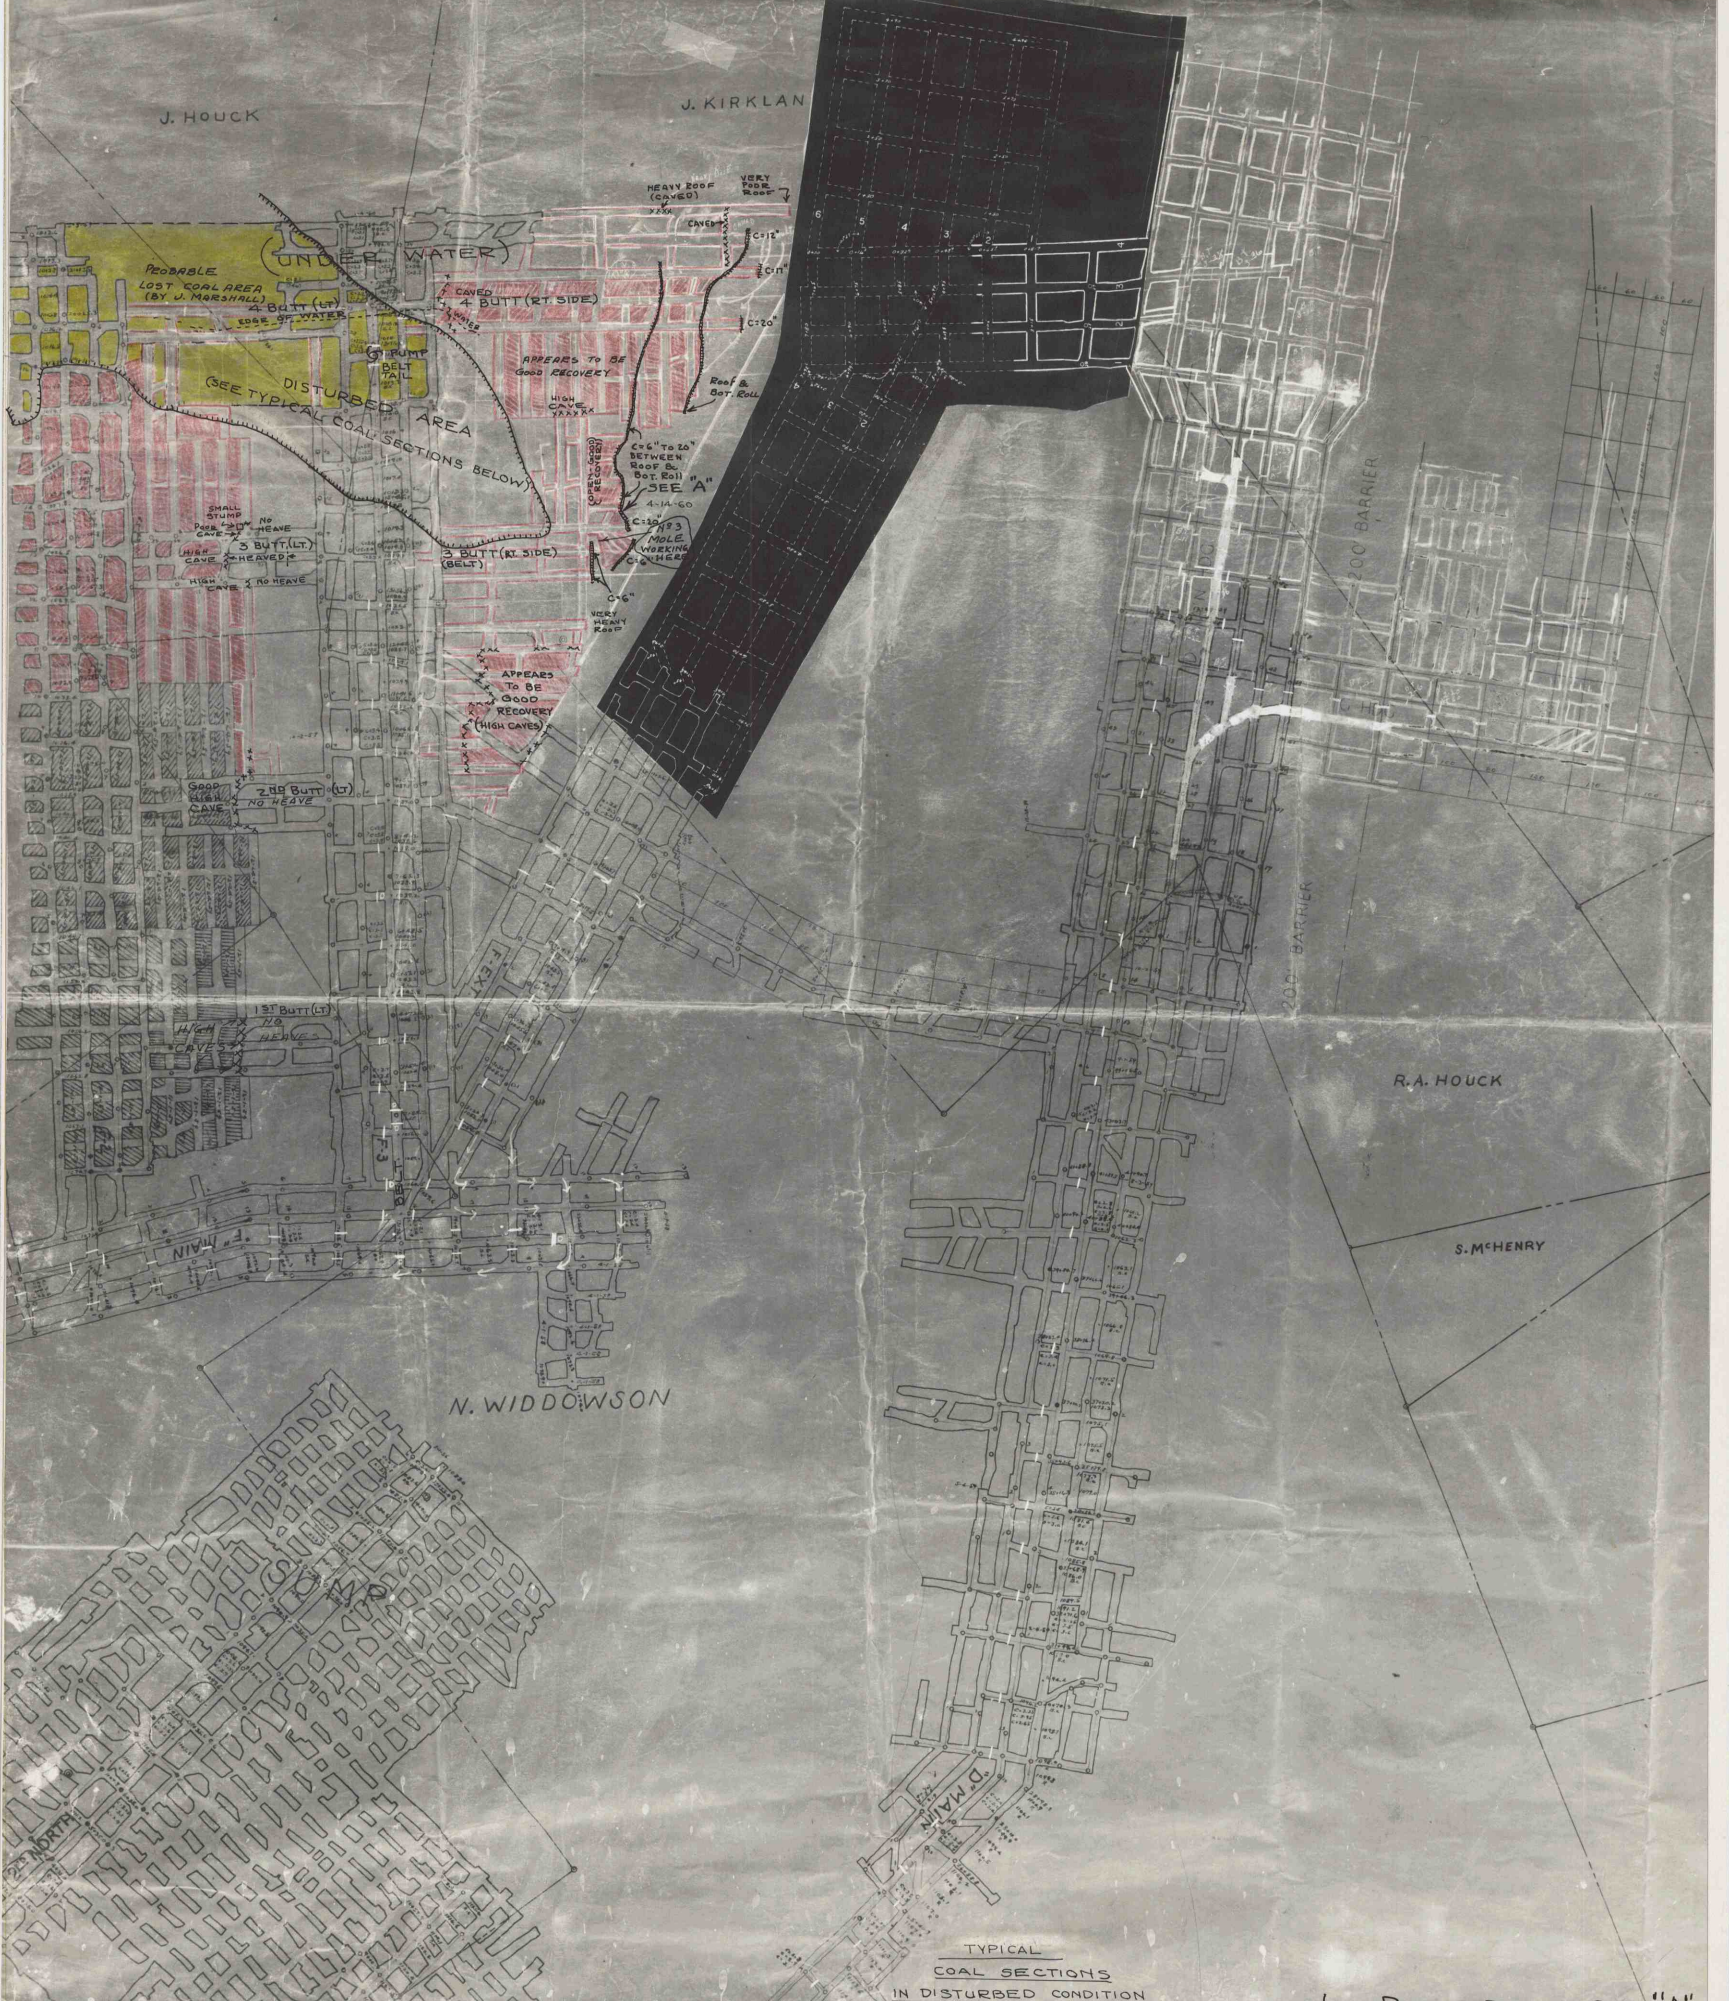

LEGEND

- MINED OUT
- PROBABLE LOST COAL (BY J. MARSHALL)
- DISTURBED CONDITION (CONTINUOUS BOT. ROLLS)
- ROOF & BOTTOM ROLL TOGETHER (SEE "A")

TYPICAL
COAL SECTIONS
IN DISTURBED CONDITION

CUTTING 35" 5" TO 7"	DARK SHALE ROOF (VERY HARD) 2" BONY 30" COAL (SUL. STR.) 1" TO 2" SUL. WITH COAL SPARS DR. SHALE & F.C. VERY HARD.	DARK SHALE ROOF VERY HARD 2" TO 6" - BONY 28" TO 30" COAL SUL. STREAKED 5" DIRTY COAL - SUL. STR. 1" TO 2" SUL. (WITH COAL SPARS) BOT. = DARK SHALE & F. CLAY.
------------------------------------	---	--

Roof & Bottom Roll "A"

