


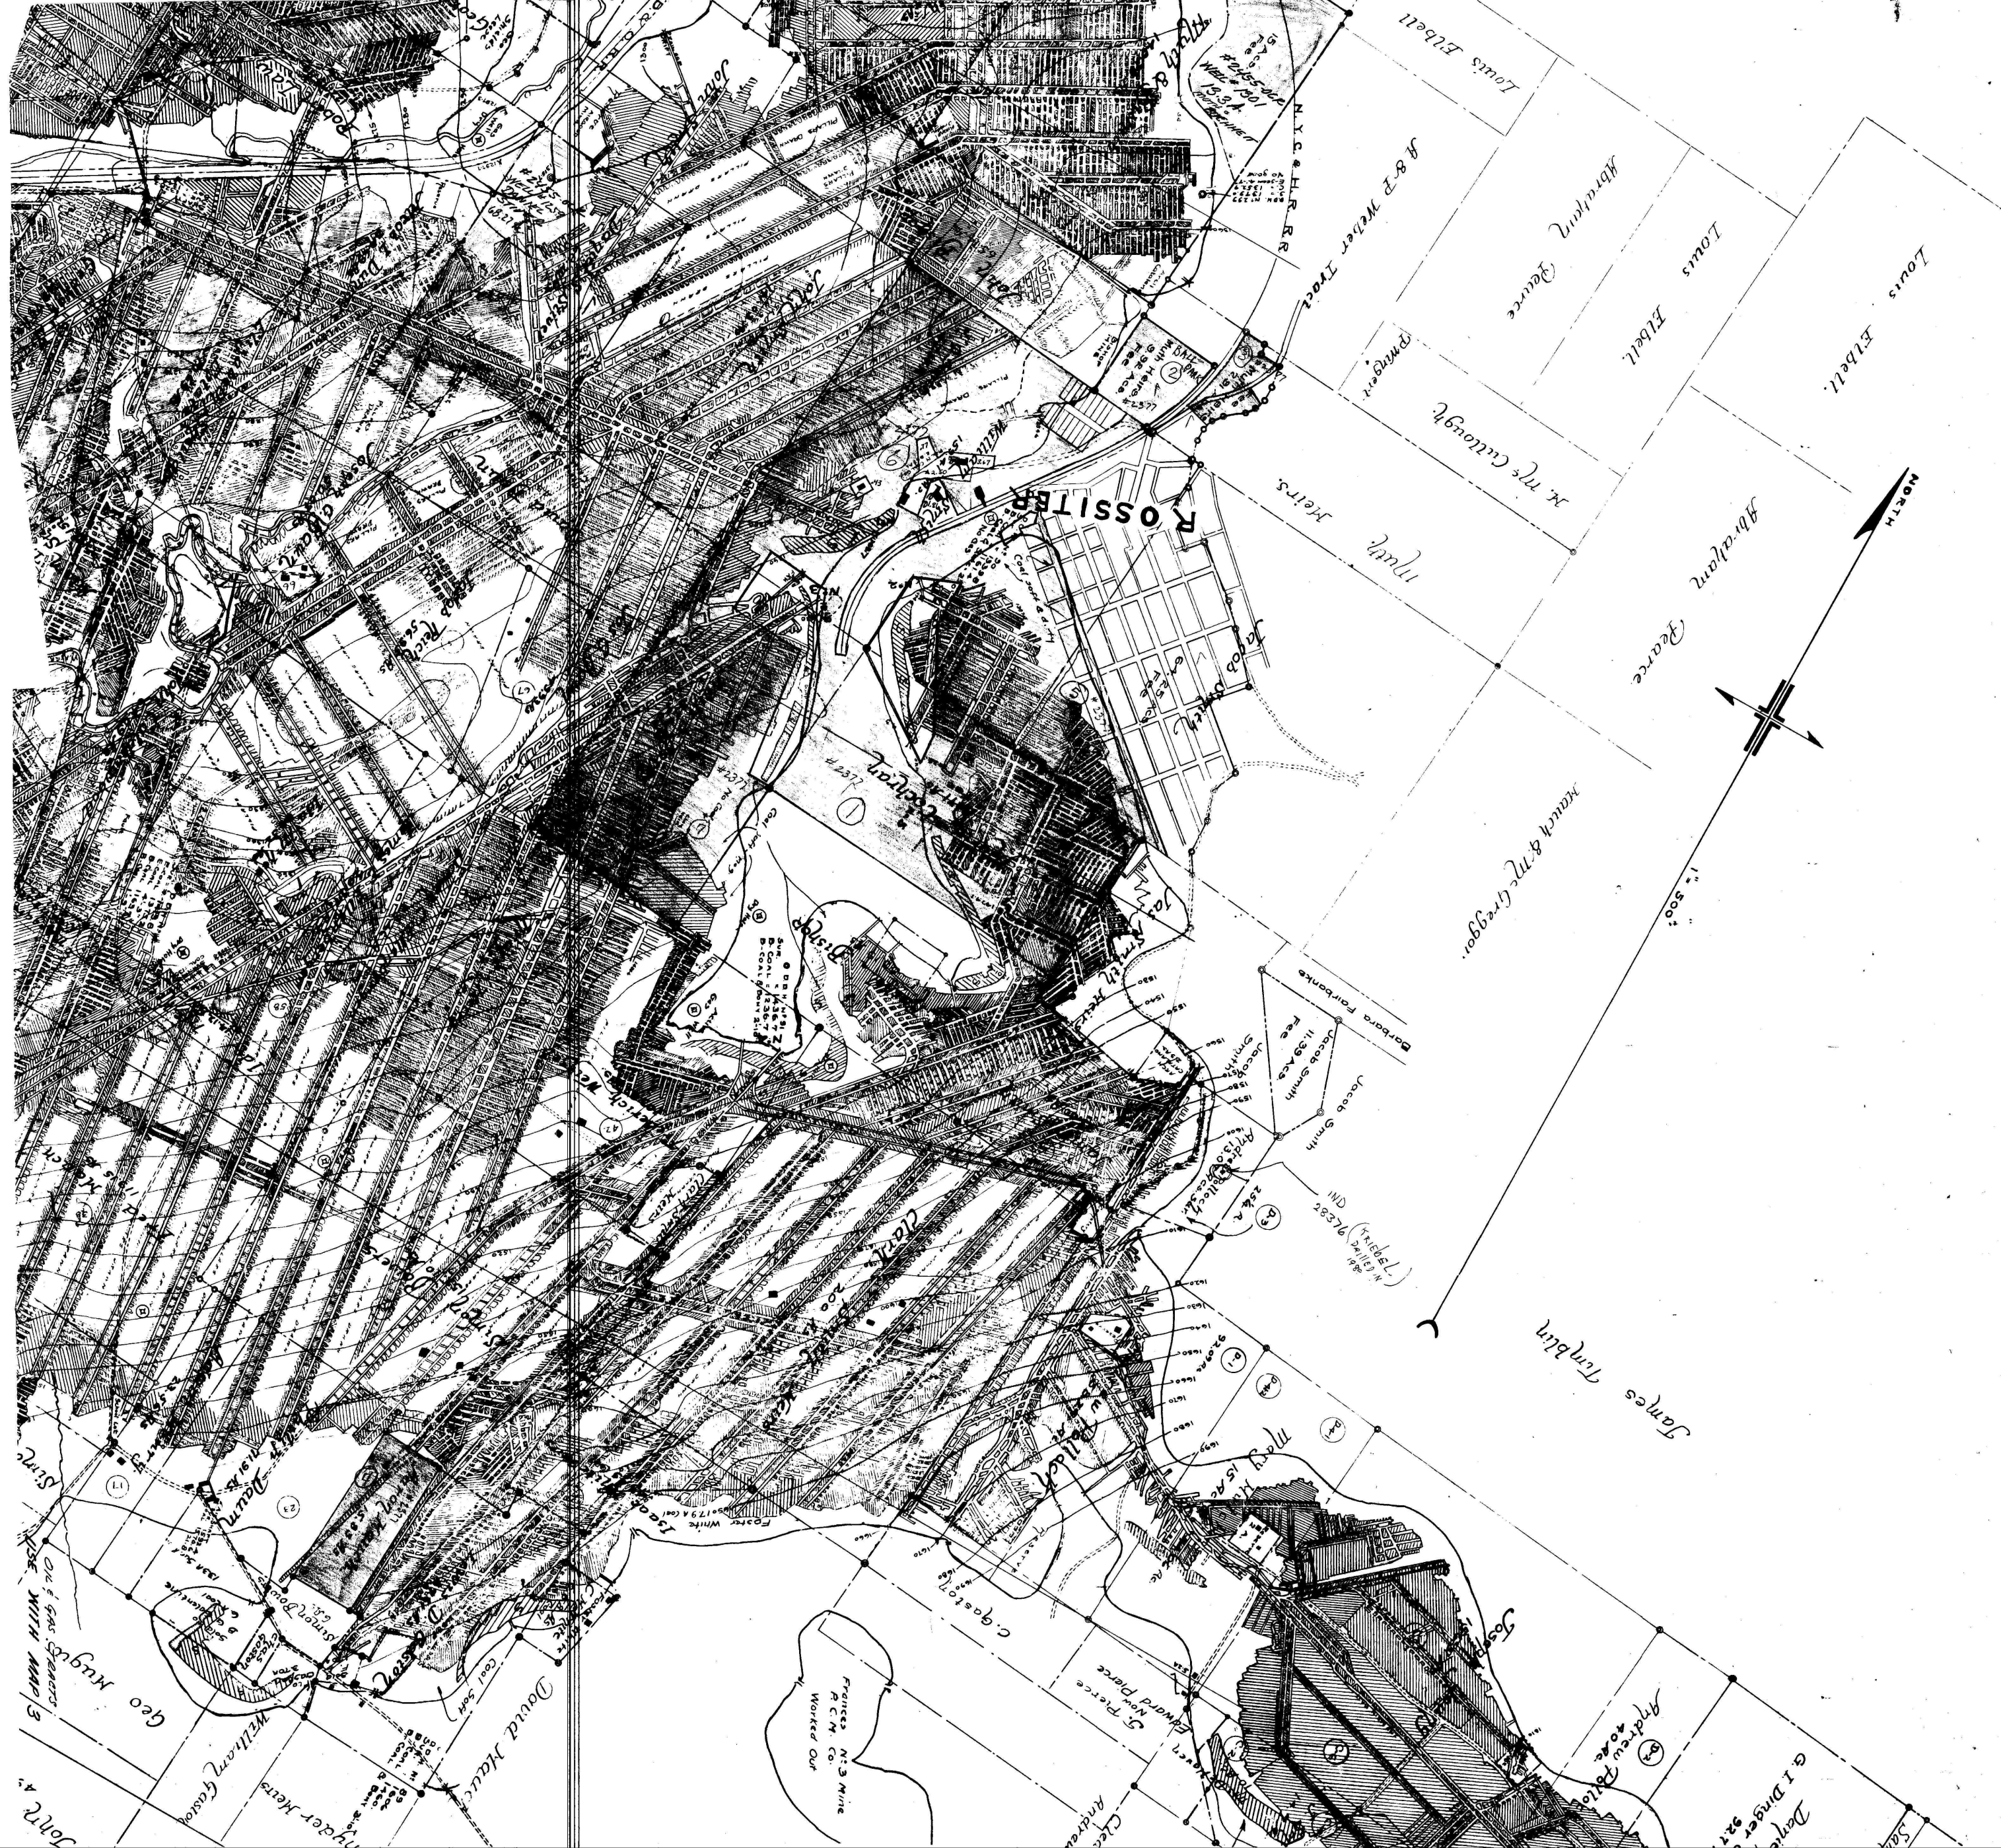

THIS MAP WAS TAKEN FROM FILE 2377-000
OLD GAS LEASE MAP FOR 1/4 L. ENDEAVORING - FILE 2377-000
CHIEF TWP. INDIANA CO. IN.
USE WITH MAP 3