



LEASE NO 3041929
B&T. SUBLEASED
TO
U.S. STEEL 288,984.
"D"-SEAM

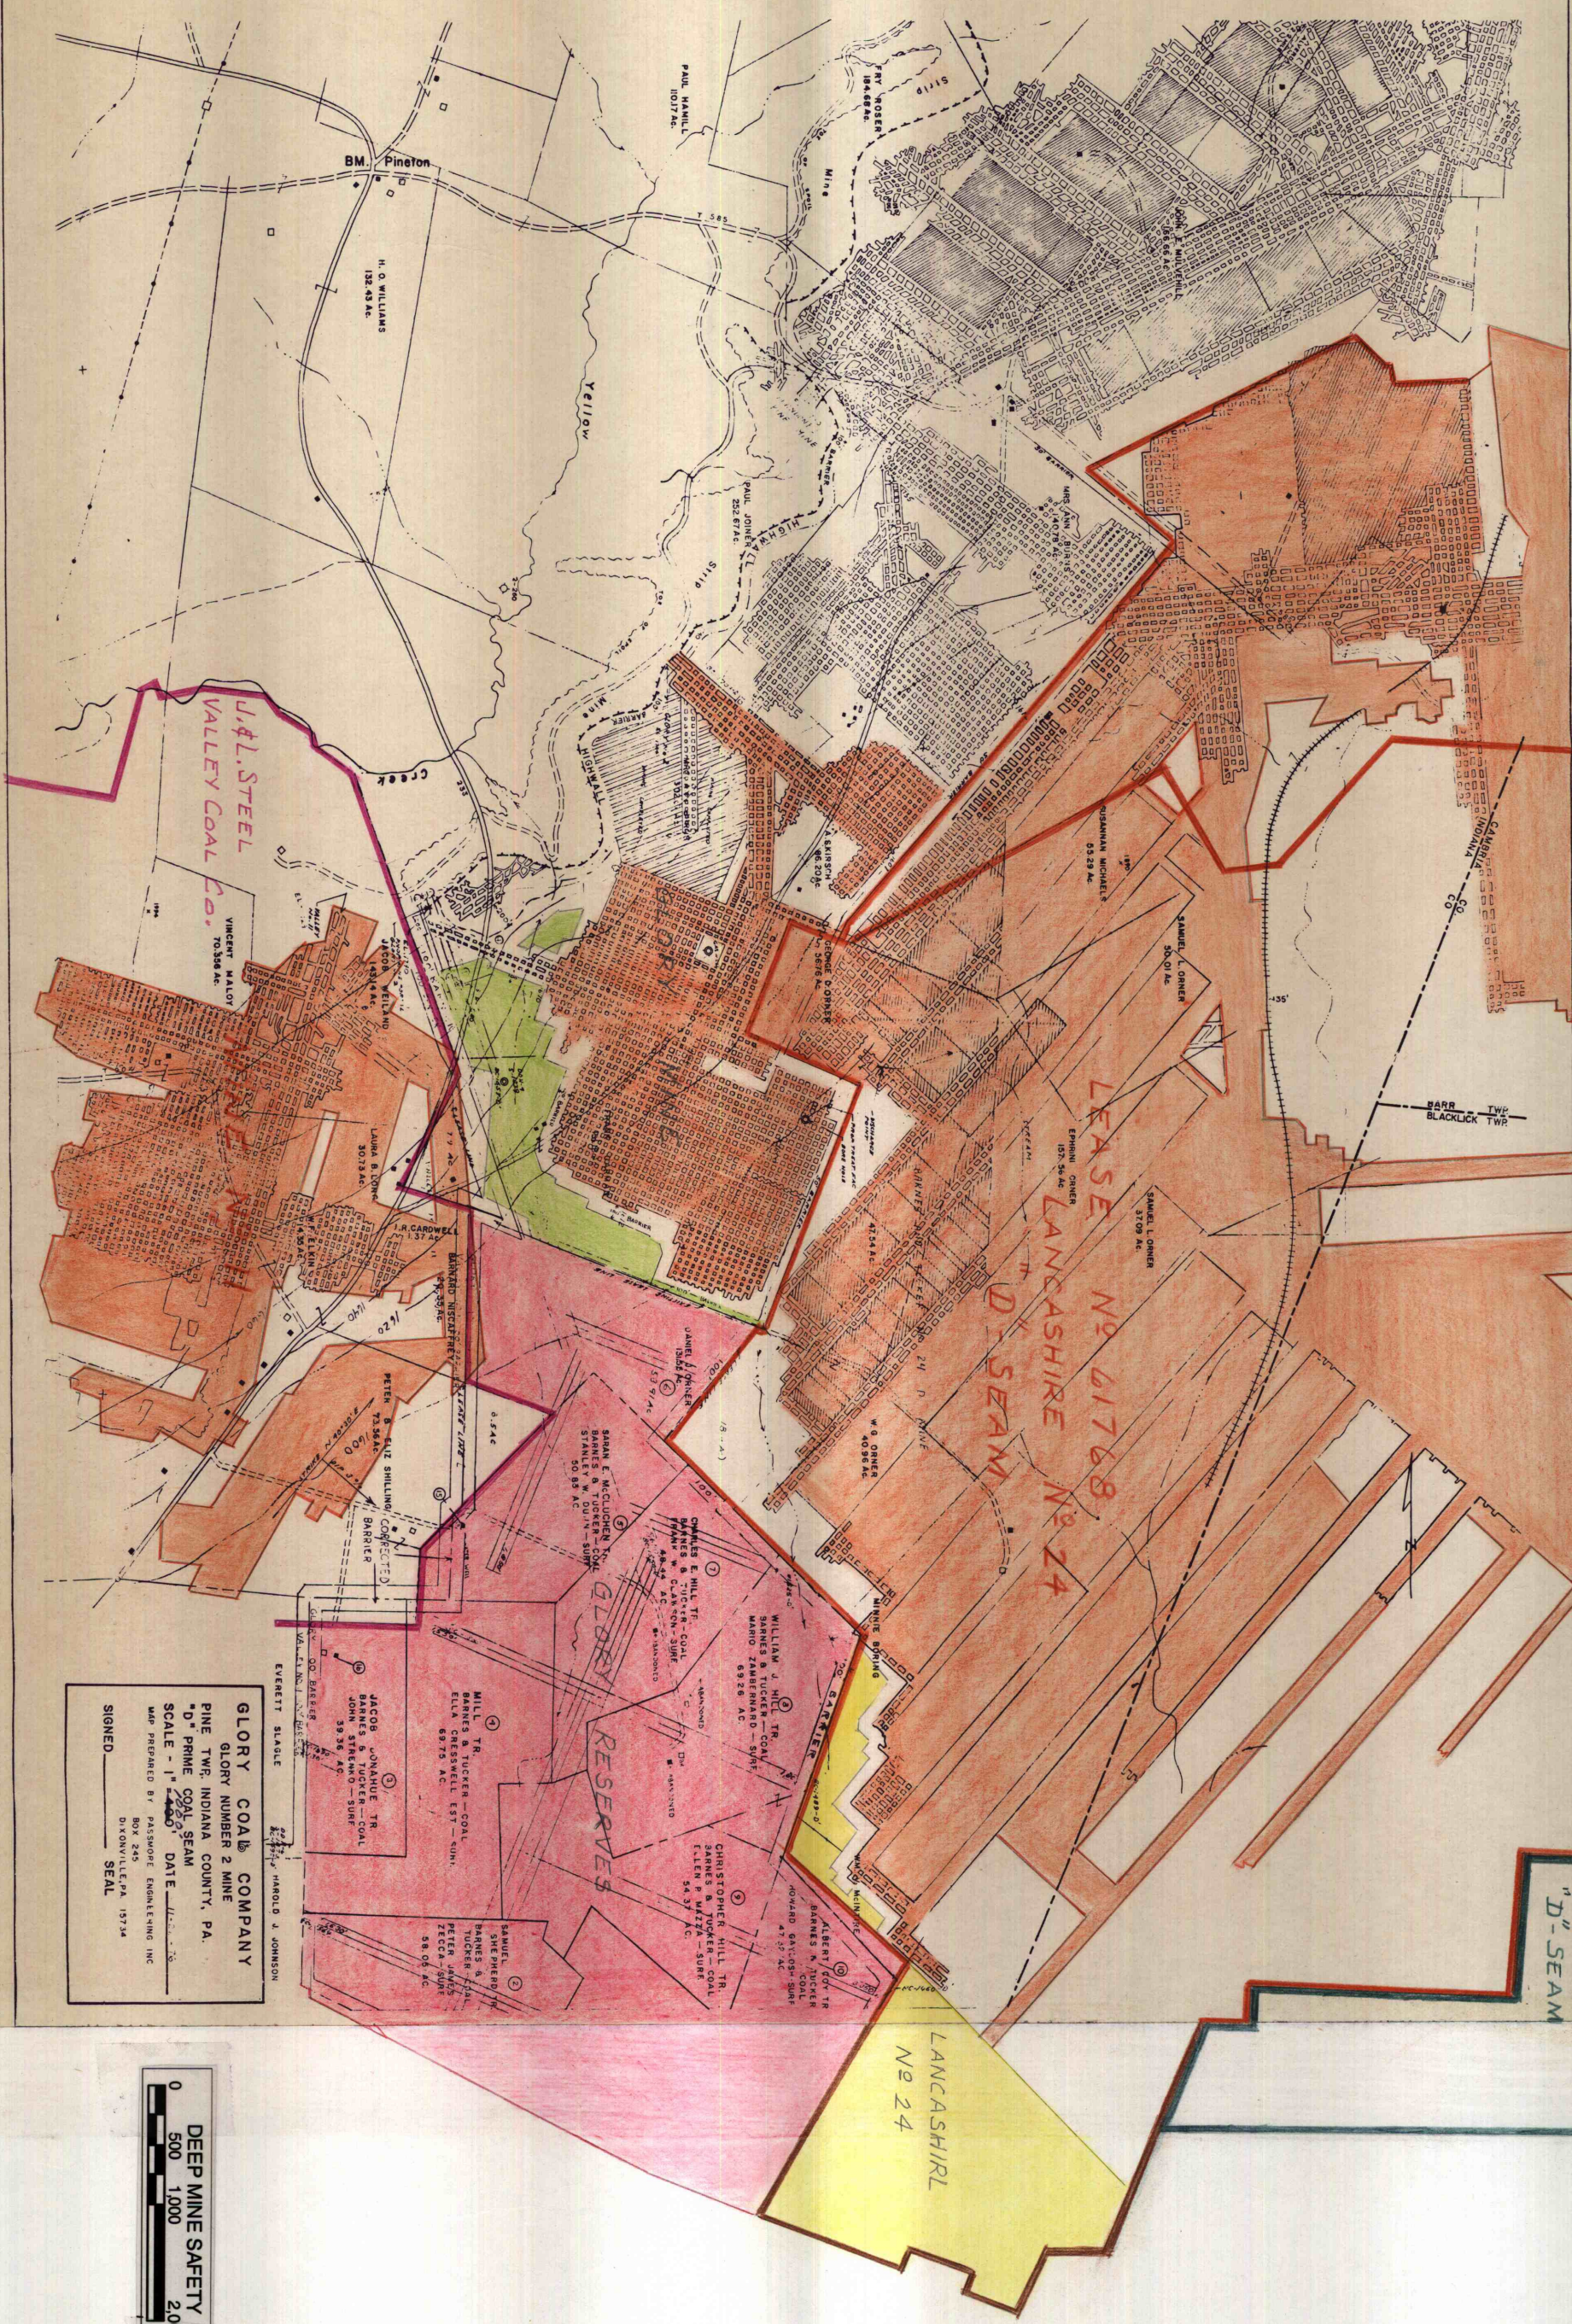

GLORY COAL COMPANY
GLORY NUMBER 2 MINE
PINE TWP, INDIANA COUNTY, PA.
"D"-PRIME COAL SEAM
SCALE - 1" = 400' DATE 11-2-75
SIGNED _____ SEAL

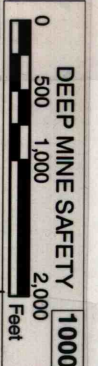

0-4-3