


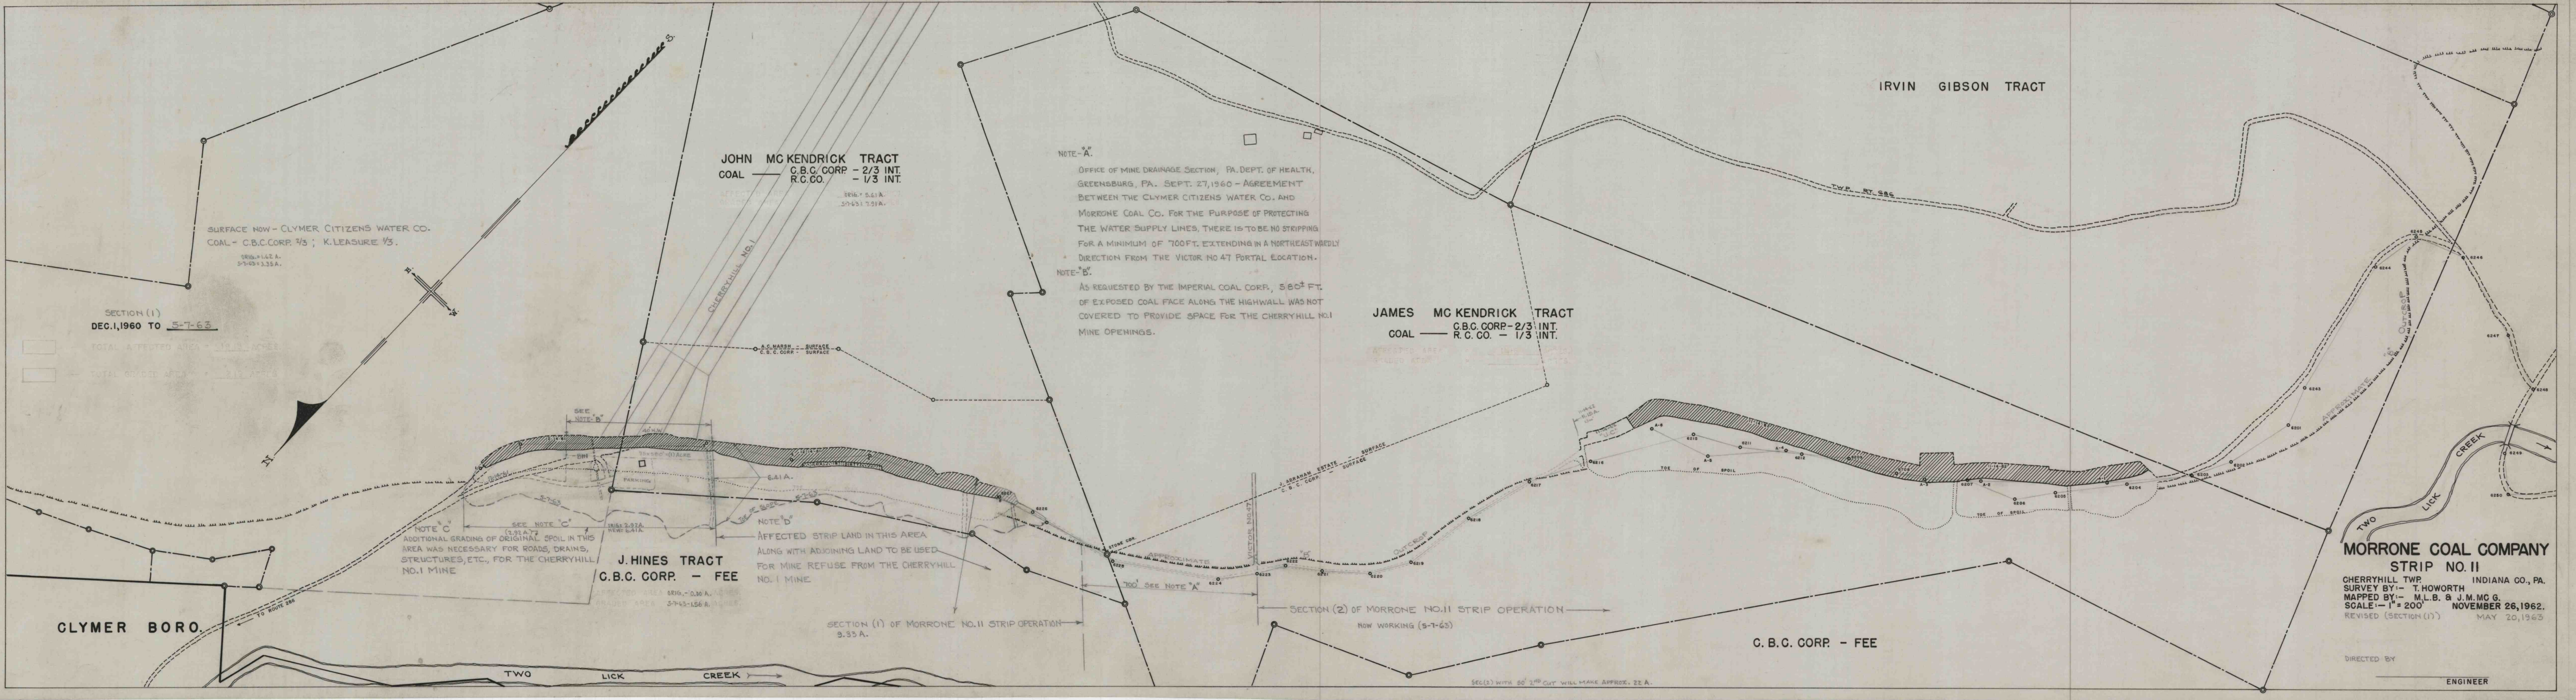

SURFACE NOW - CLYMER CITIZENS WATER CO.
COAL - C.B.C. CORP. 2/3 ; K. LEASURE 1/3.

JOHN MC KENDRICK TRACT
COAL — C.B.C. CORP. - 2/3 INT.
R.C. CO. - 1/3 INT.

NOTE "A"
OFFICE OF MINE DRAINAGE SECTION, PA. DEPT. OF HEALTH,
GREENSBURG, PA. SEPT. 27, 1960 - AGREEMENT
BETWEEN THE CLYMER CITIZENS WATER CO. AND
MORRONE COAL CO. FOR THE PURPOSE OF PROTECTING
THE WATER SUPPLY LINES, THERE IS TO BE NO STRIPPING
FOR A MINIMUM OF 700 FT. EXTENDING IN A NORTHEASTWARDLY
DIRECTION FROM THE VICTOR NO. 47 PORTAL LOCATION.

NOTE "B"
AS REQUESTED BY THE IMPERIAL COAL CORP., 580± FT.
OF EXPOSED COAL FACE ALONG THE HIGHWALL WAS NOT
COVERED TO PROVIDE SPACE FOR THE CHERRYHILL NO. 1
MINE OPENINGS.

JAMES MC KENDRICK TRACT
COAL — C.B.C. CORP. - 2/3 INT.
R.C. CO. - 1/3 INT.

NOTE "C"
ADDITIONAL GRADING OF ORIGINAL SPOIL IN THIS
AREA WAS NECESSARY FOR ROADS, DRAINS,
STRUCTURES, ETC., FOR THE CHERRYHILL
NO. 1 MINE

J. HINES TRACT
C.B.C. CORP. - FEE

NOTE "D"
AFFECTED STRIP LAND IN THIS AREA
ALONG WITH ADJOINING LAND TO BE USED
FOR MINE REFUSE FROM THE CHERRYHILL
NO. 1 MINE

SECTION (1) OF MORRONE NO. 11 STRIP OPERATION
9.33 A.

SECTION (2) OF MORRONE NO. 11 STRIP OPERATION
NOW WORKING (5-7-63)

C.B.C. CORP. - FEE

MORRONE COAL COMPANY
STRIP NO. II
CHERRYHILL TWP. INDIANA CO., PA.
SURVEY BY: T. HOWORTH
MAPPED BY: M.L.B. & J.M. MC G.
SCALE: 1" = 200' NOVEMBER 26, 1962.
REVISED (SECTION (1)) MAY 20, 1963

DIRECTED BY
ENGINEER