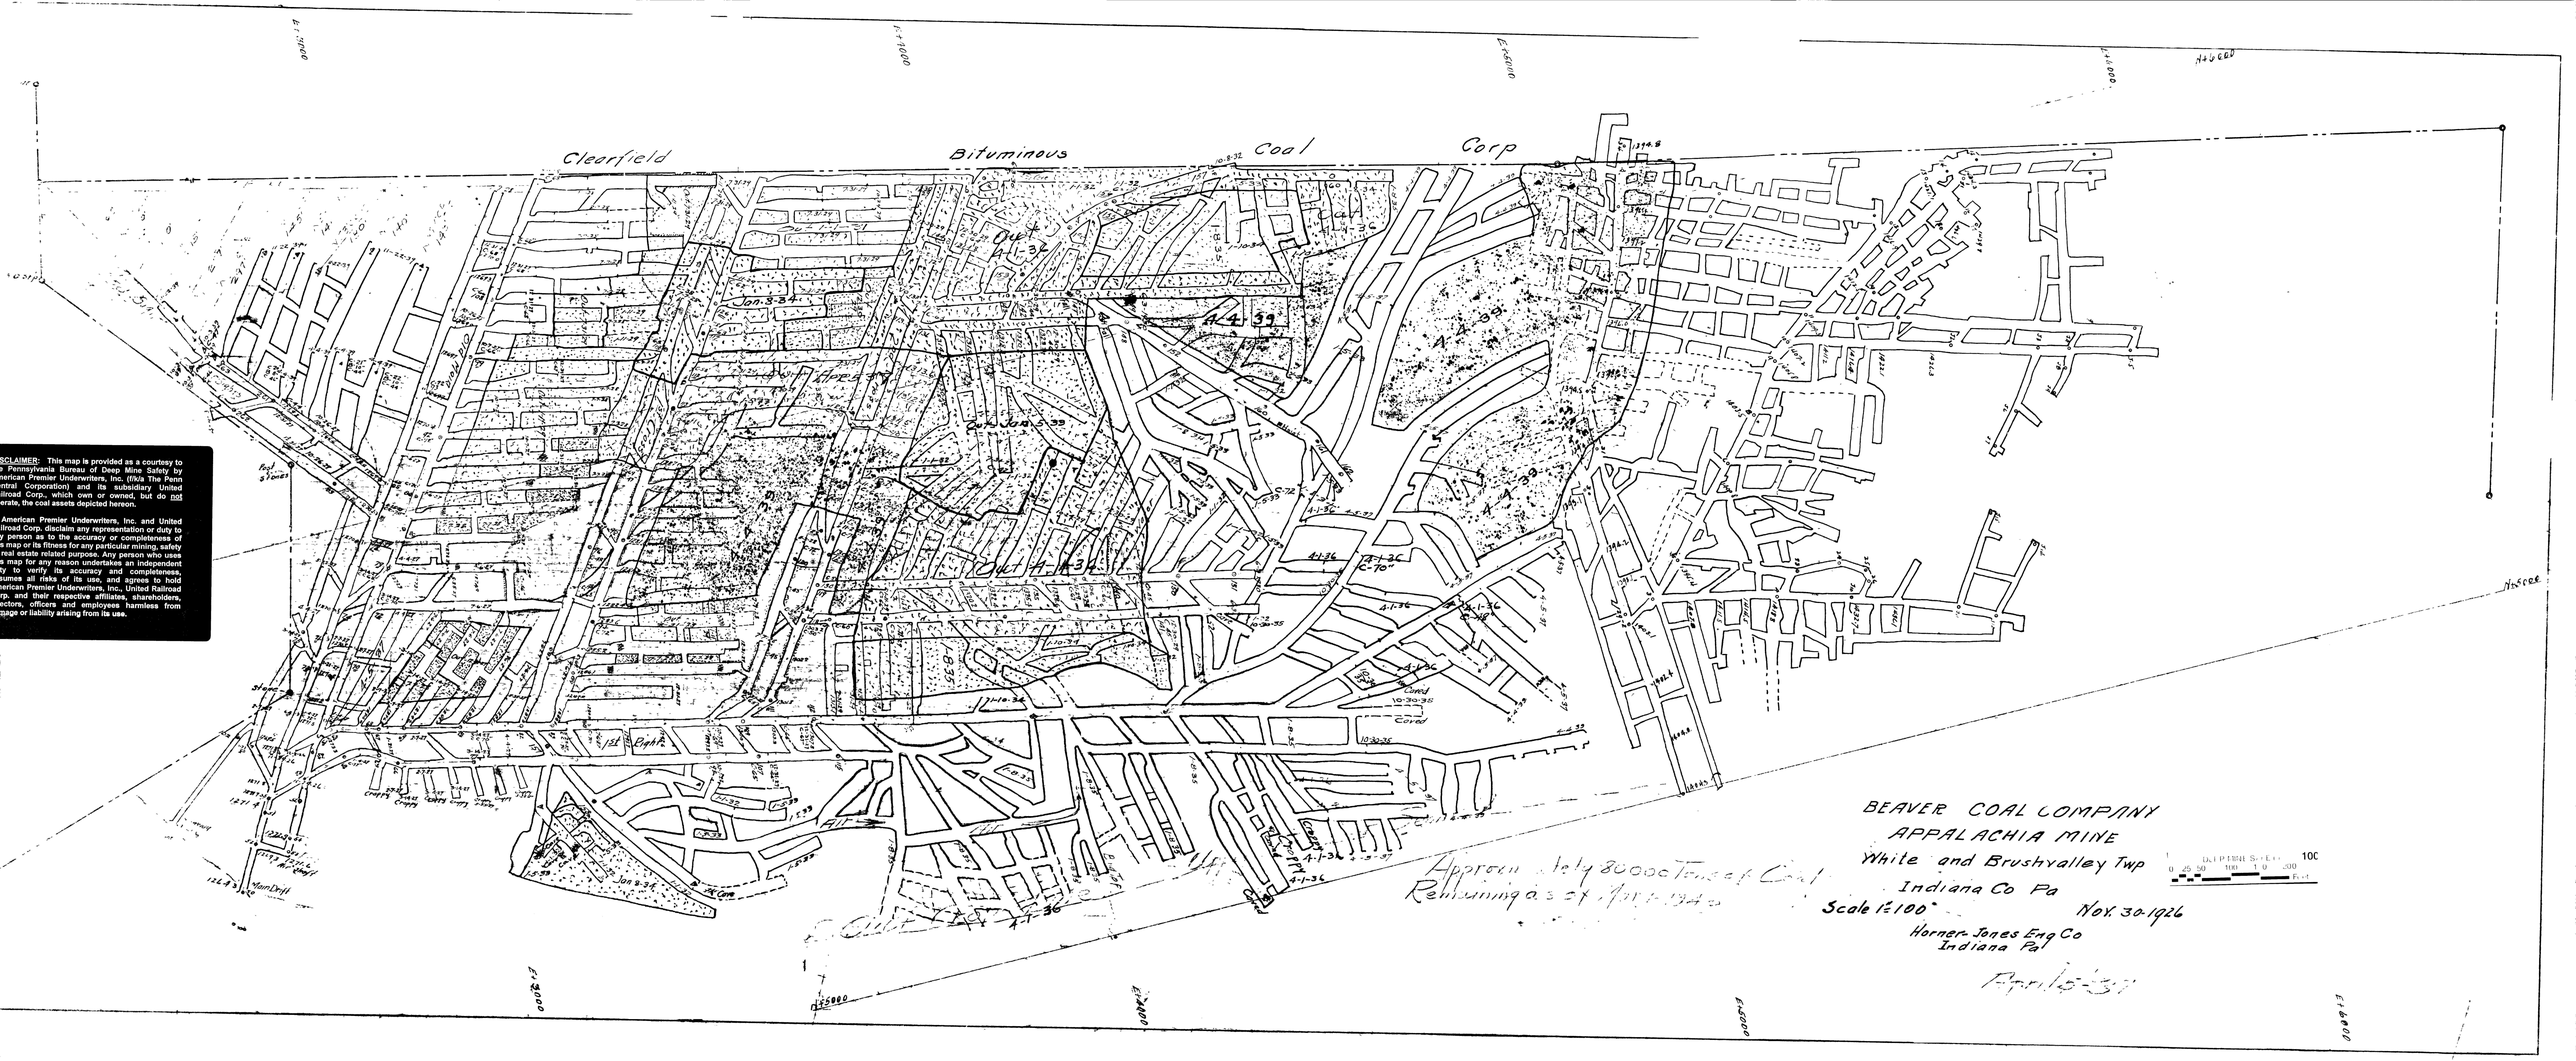
Clearfield Bituminous Coal Corp
BEAVER COAL COMPANY
APPALACHIA MINE
White and Brushvalley Twp
Indiana Co Pa
Scale 1"=100'
Nov. 30-1926
Horner-Jones Eng Co
Indiana Pa
Approx. 80000 Tons of Coal Remaining as of April 1934
Out 4-1-34
Out 4-1-34
Out 4-1-34
Out 4-1-36
Out 4-1-36
Out 4-1-36