


DISCLAIMER: This map is provided as a courtesy to the Pennsylvania Bureau of Deep Mine Safety by American Premier Underwriters, Inc. (f/k/a The Penn Central Corporation) and its subsidiary United Railroad Corp., which own or owned, but do not operate, the coal assets depicted herein.

American Premier Underwriters, Inc. and United Railroad Corp. disclaim any representation or duty to the Pennsylvania Bureau of Deep Mine Safety or to this map or its fitness for use in determining safety or real estate related purposes. Any use of this map for any reason undertakes an independent duty to verify its accuracy and completeness, assumes all risks of its use, and agrees to hold American Premier Underwriters, Inc., United Railroad Corp. and their respective affiliates, shareholders, directors, officers and employees harmless from damage or liability arising from its use.

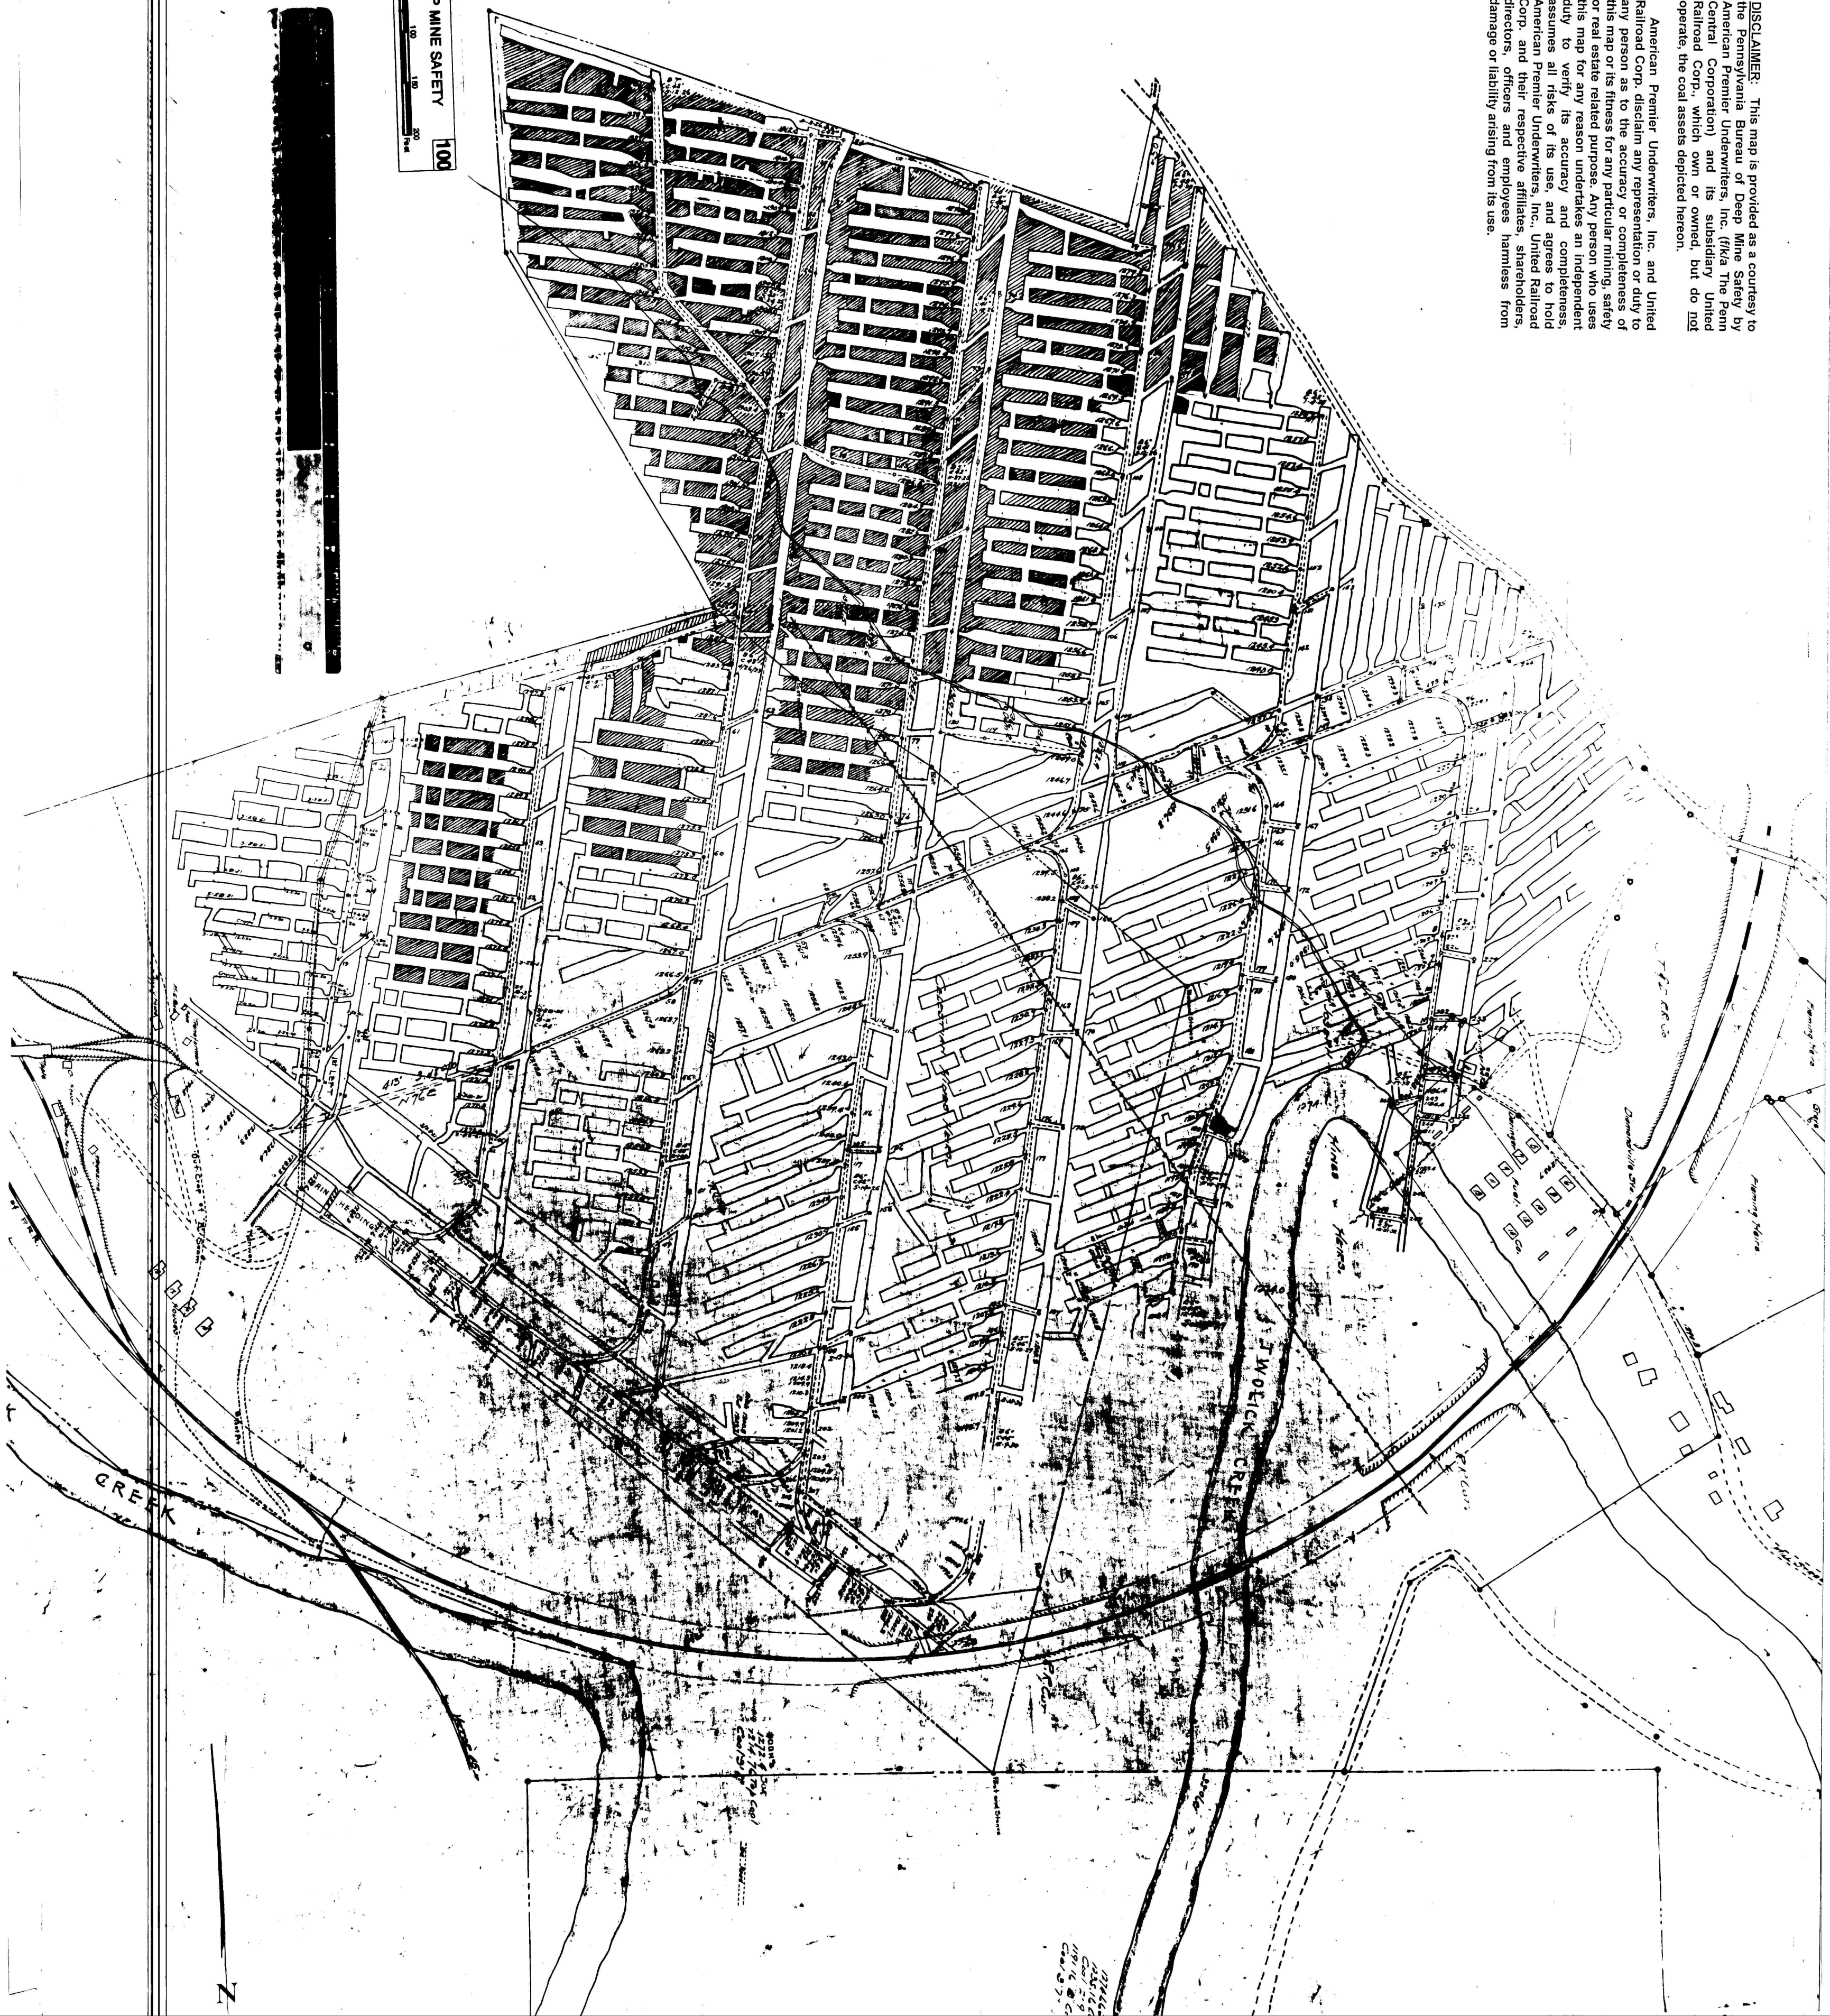

DEEP MINE SAFETY 100
0 50 100 200
Feet

