B-206

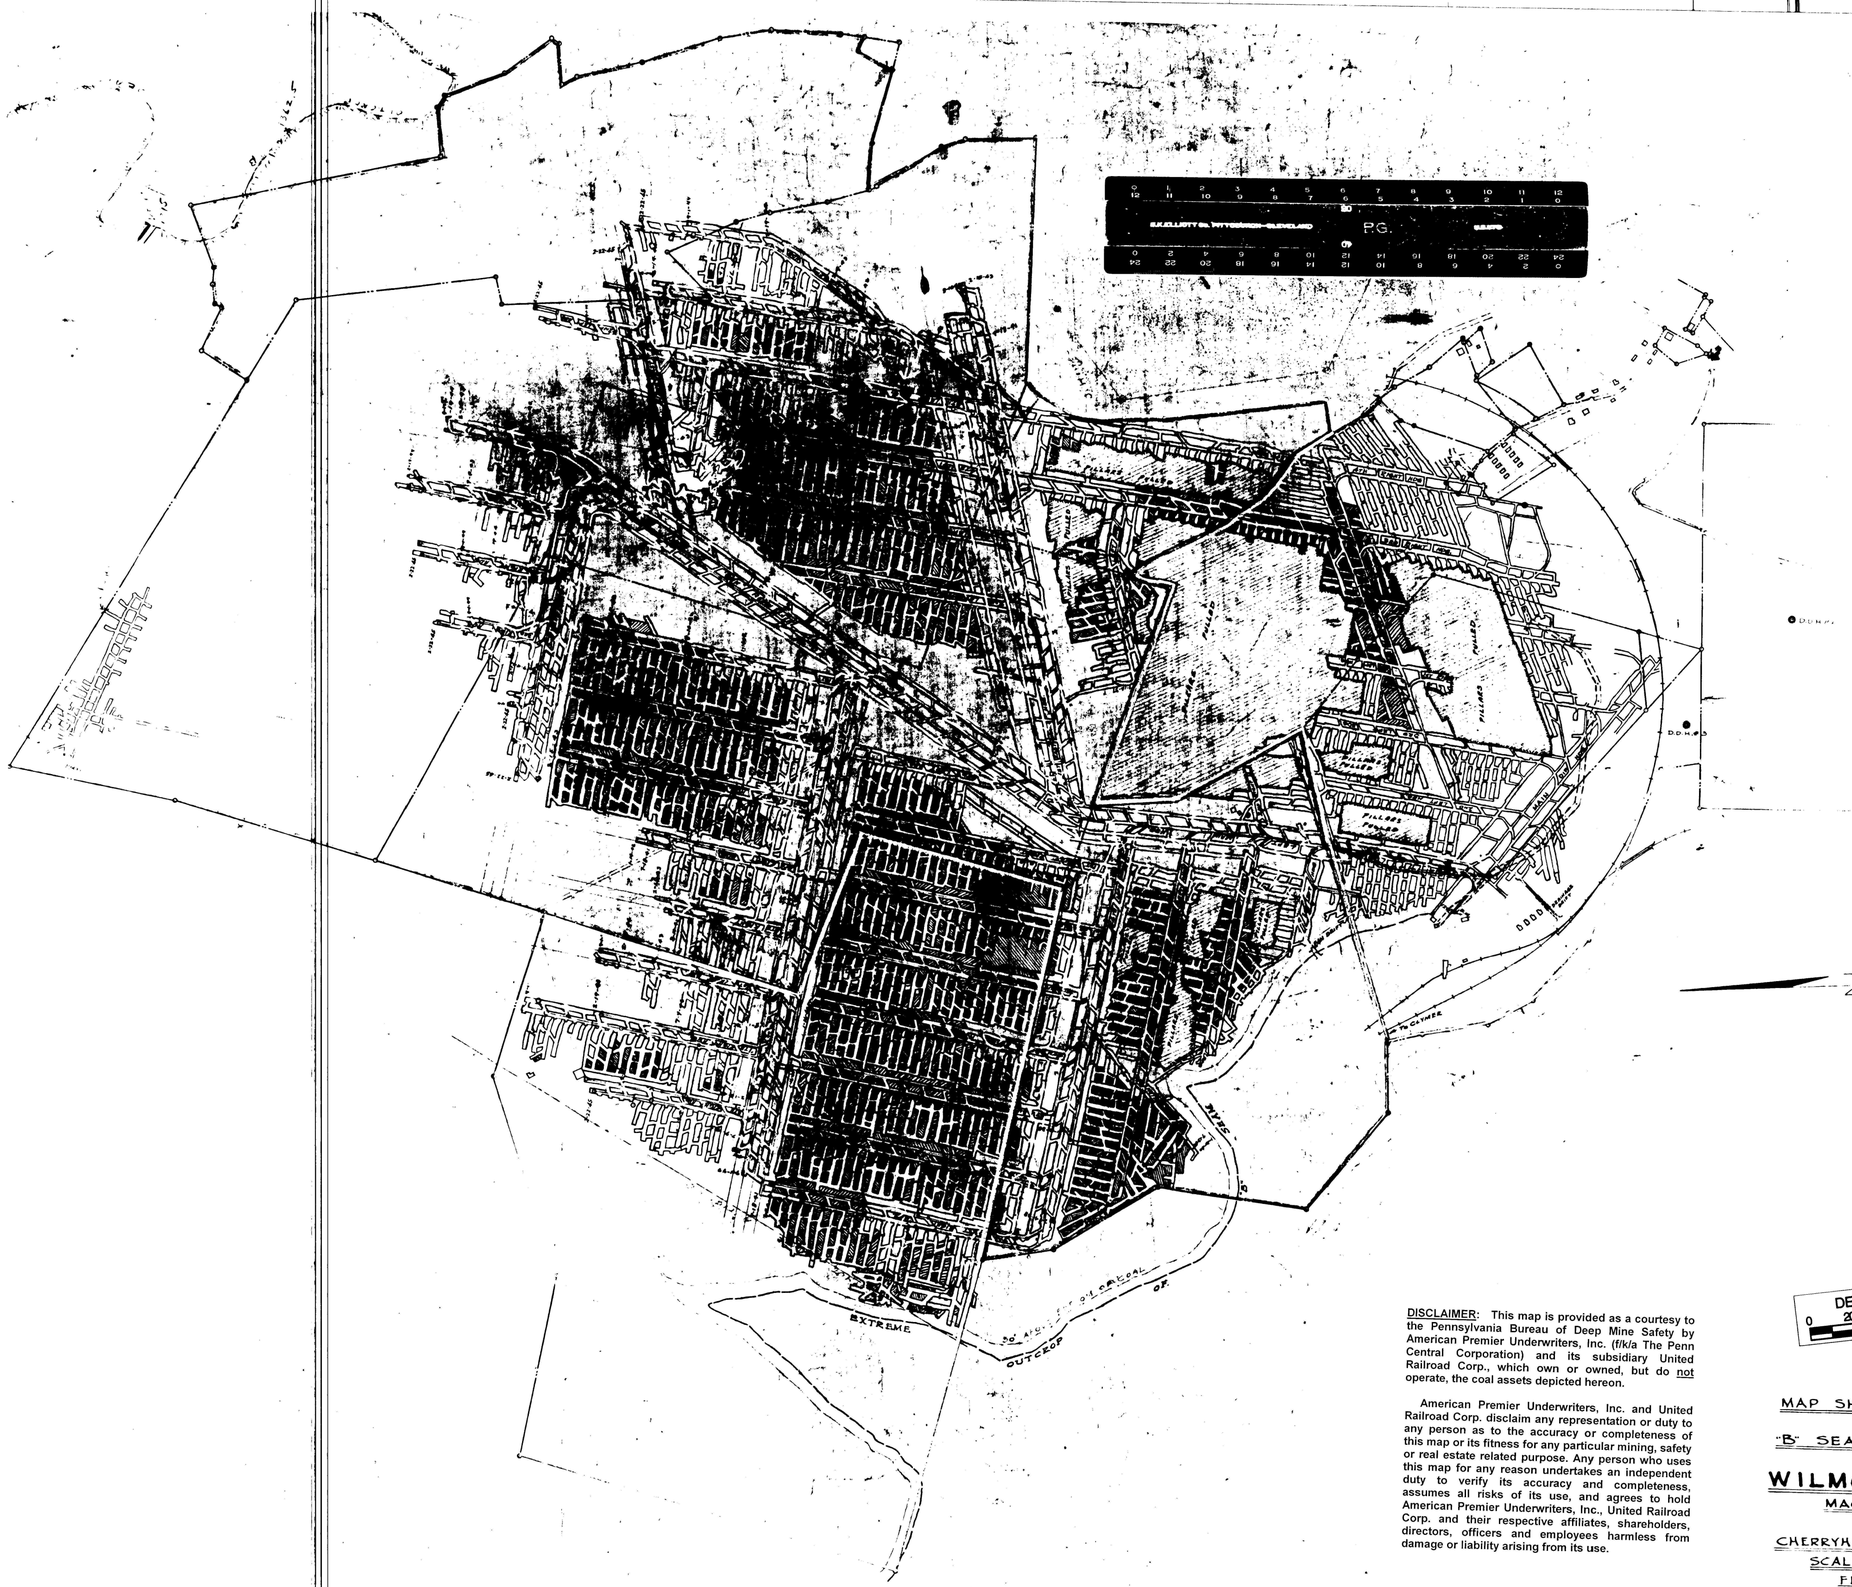

DISCLAIMER: This map is provided as a courtesy to the Pennsylvania Bureau of Deep Mine Safety by American Premier Underwriters, Inc. (f/k/a The Penn Central Corporation) and its subsidiary United Railroad Corp., which own or owned, but do not operate, the coal assets depicted hereon.

American Premier Underwriters, Inc. and United Railroad Corp. disclaim any representation or duty to any person as to the accuracy or completeness of this map or its fitness for any particular mining, safety or real estate related purpose. Any person who uses this map for any reason undertakes an independent duty to verify its accuracy and completeness, assumes all risks of its use, and agrees to hold American Premier Underwriters, Inc., United Railroad Corp. and their respective affiliates, shareholders, directors, officers and employees harmless from damage or liability arising from its use.

DEEP MINE SAFETY 400
0 200 400 800 Feet

MAP SHOWING PROPERTY
AND
"B" SEAM MINE WORKINGS
OF
WILMORE FUEL CO.
MACK No. 2 MINE
SITUATE IN
CHERRYHILL TWP., INDIANA CO., PA.
SCALE:- 1"=400' OCT. 30, 1937
FETTERMAN ENG'R. CO.
JOHNSTOWN, PA.