



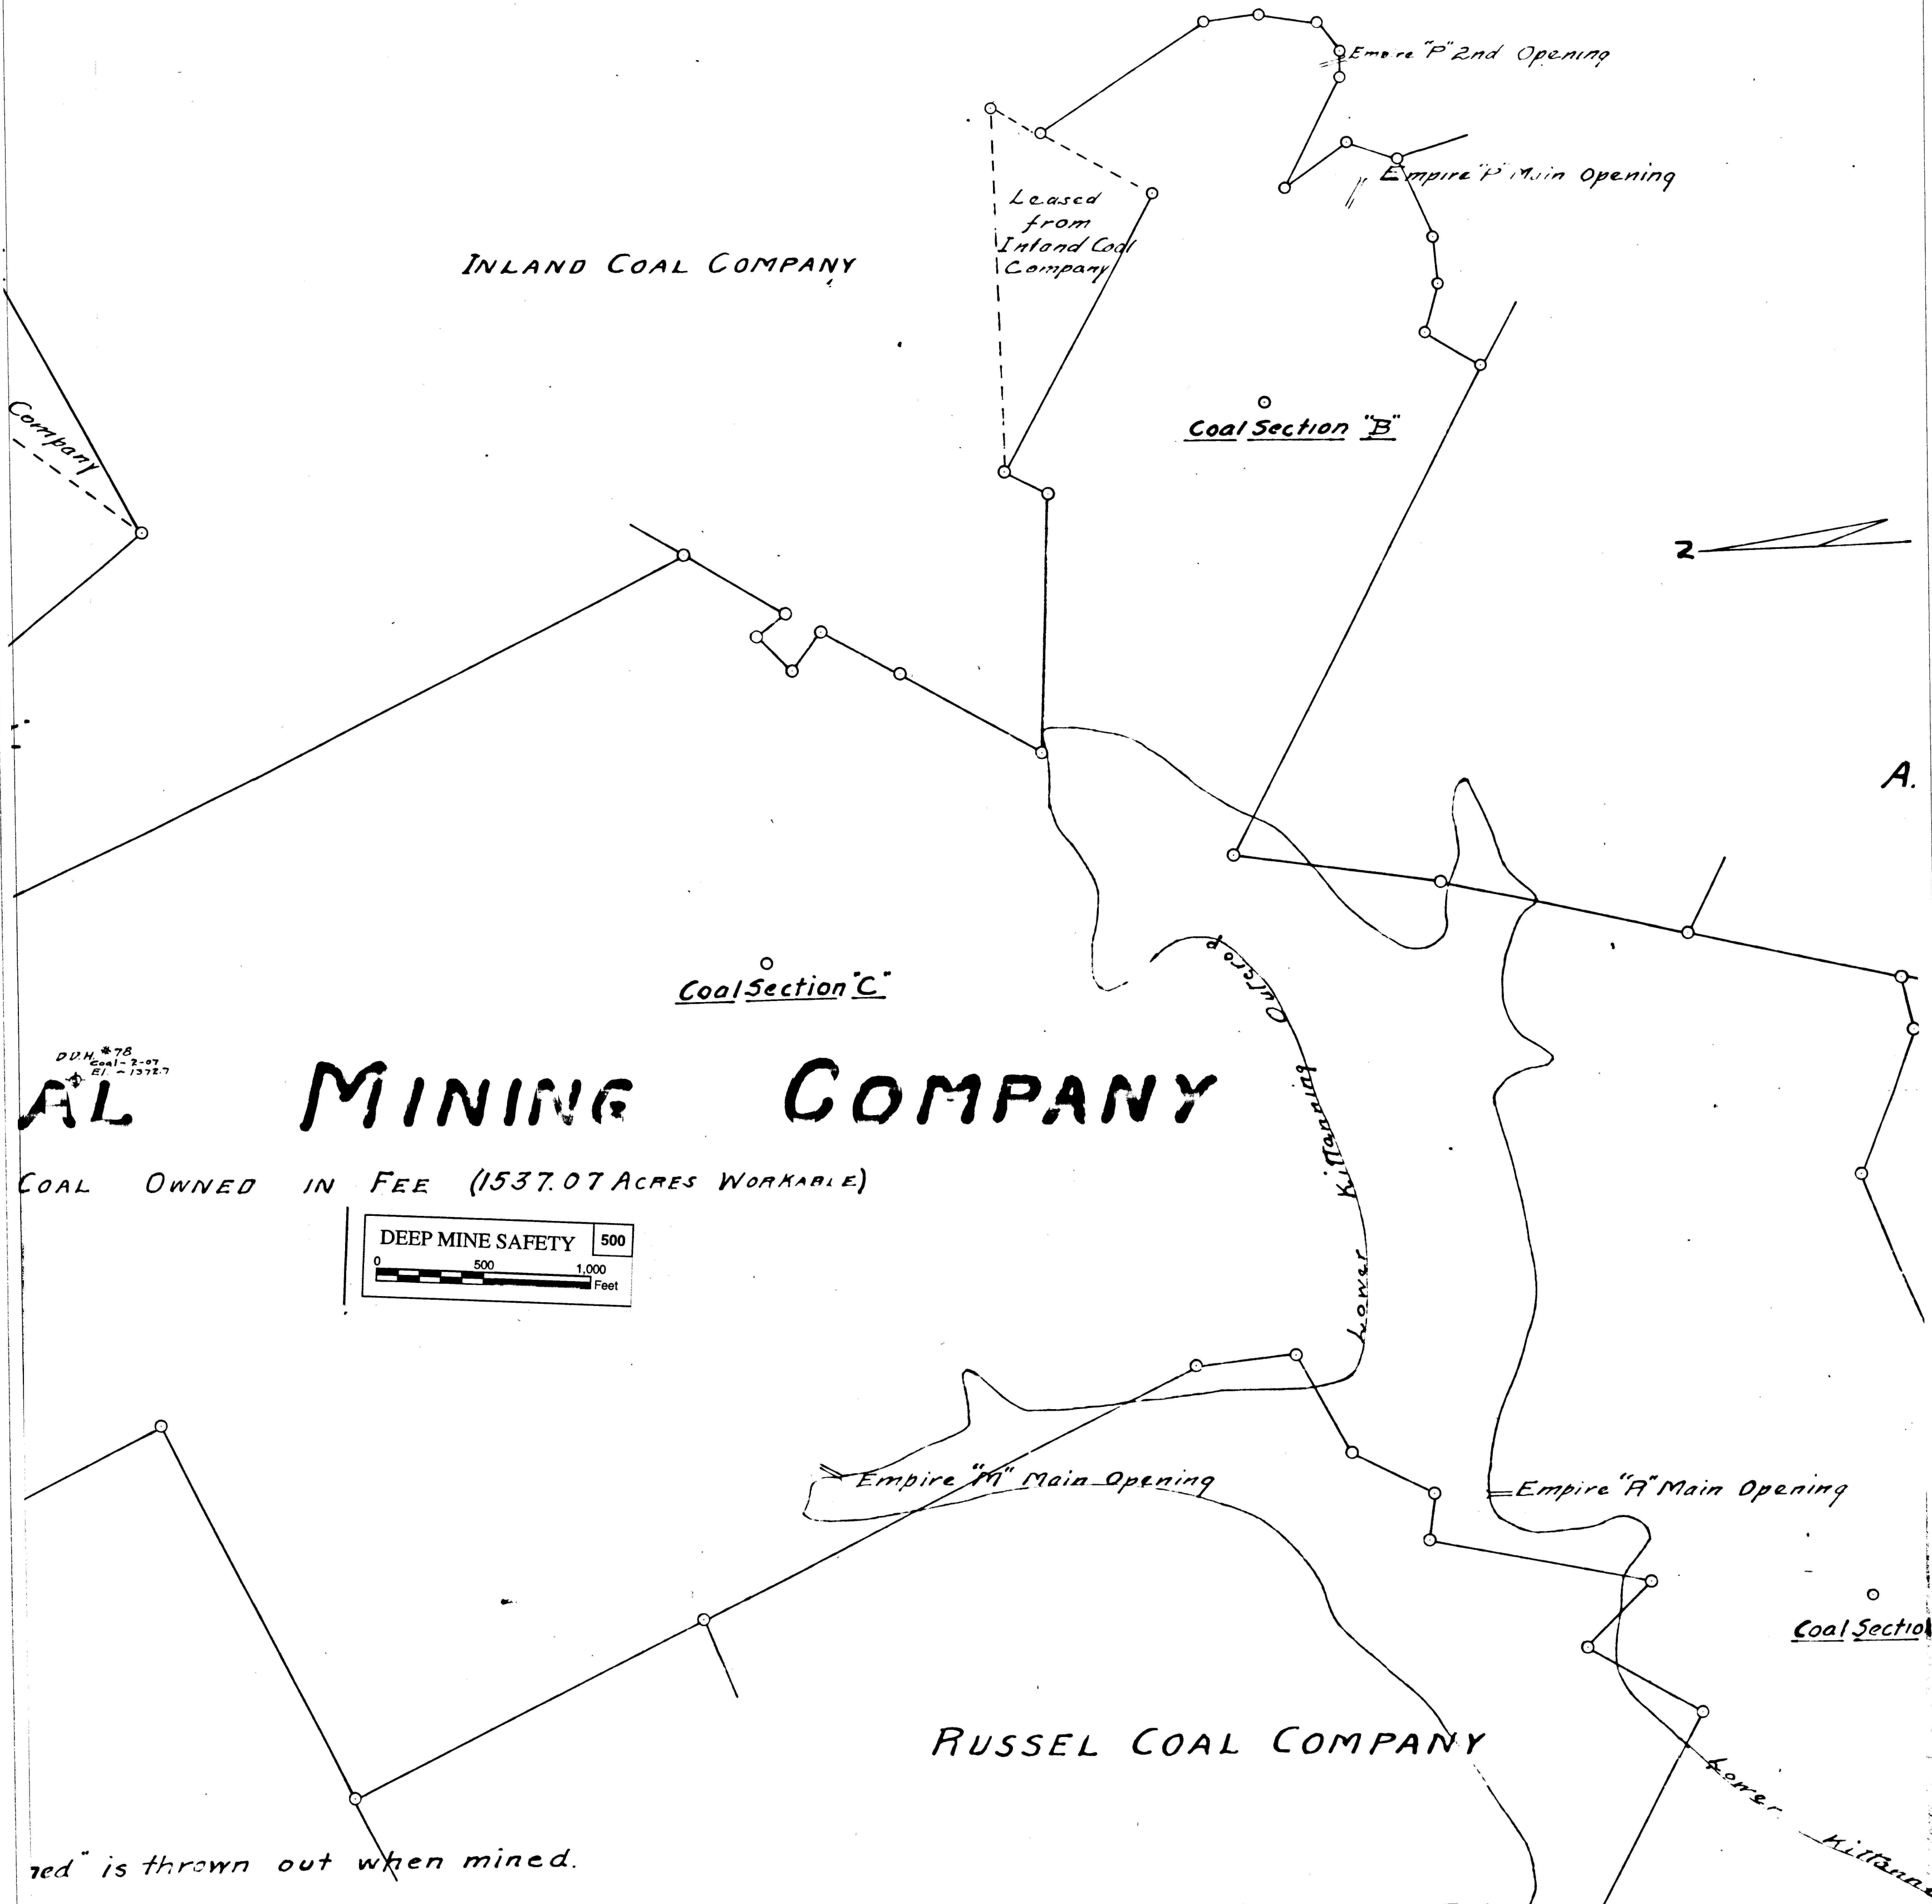

red" is thrown out when mined.

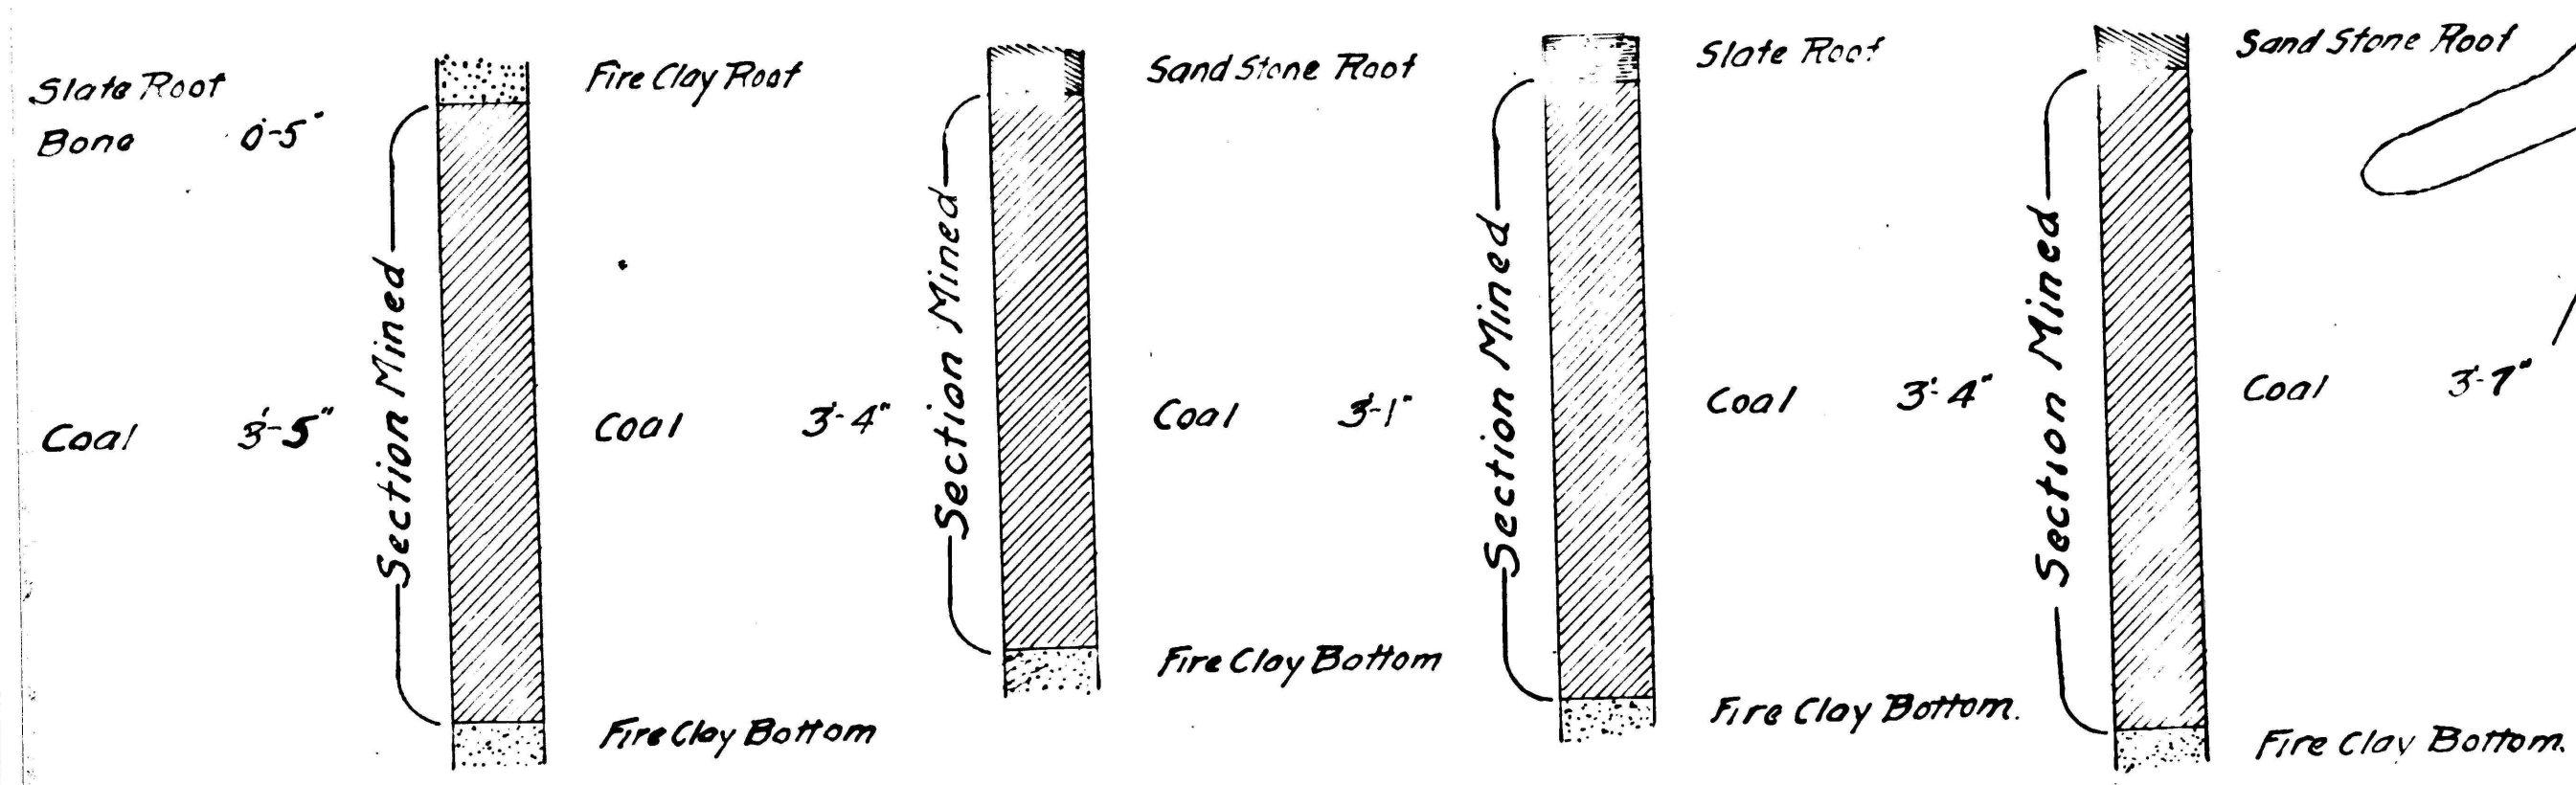

Fire Clay Bottom

Section F

Coal Mining Co.

2055