


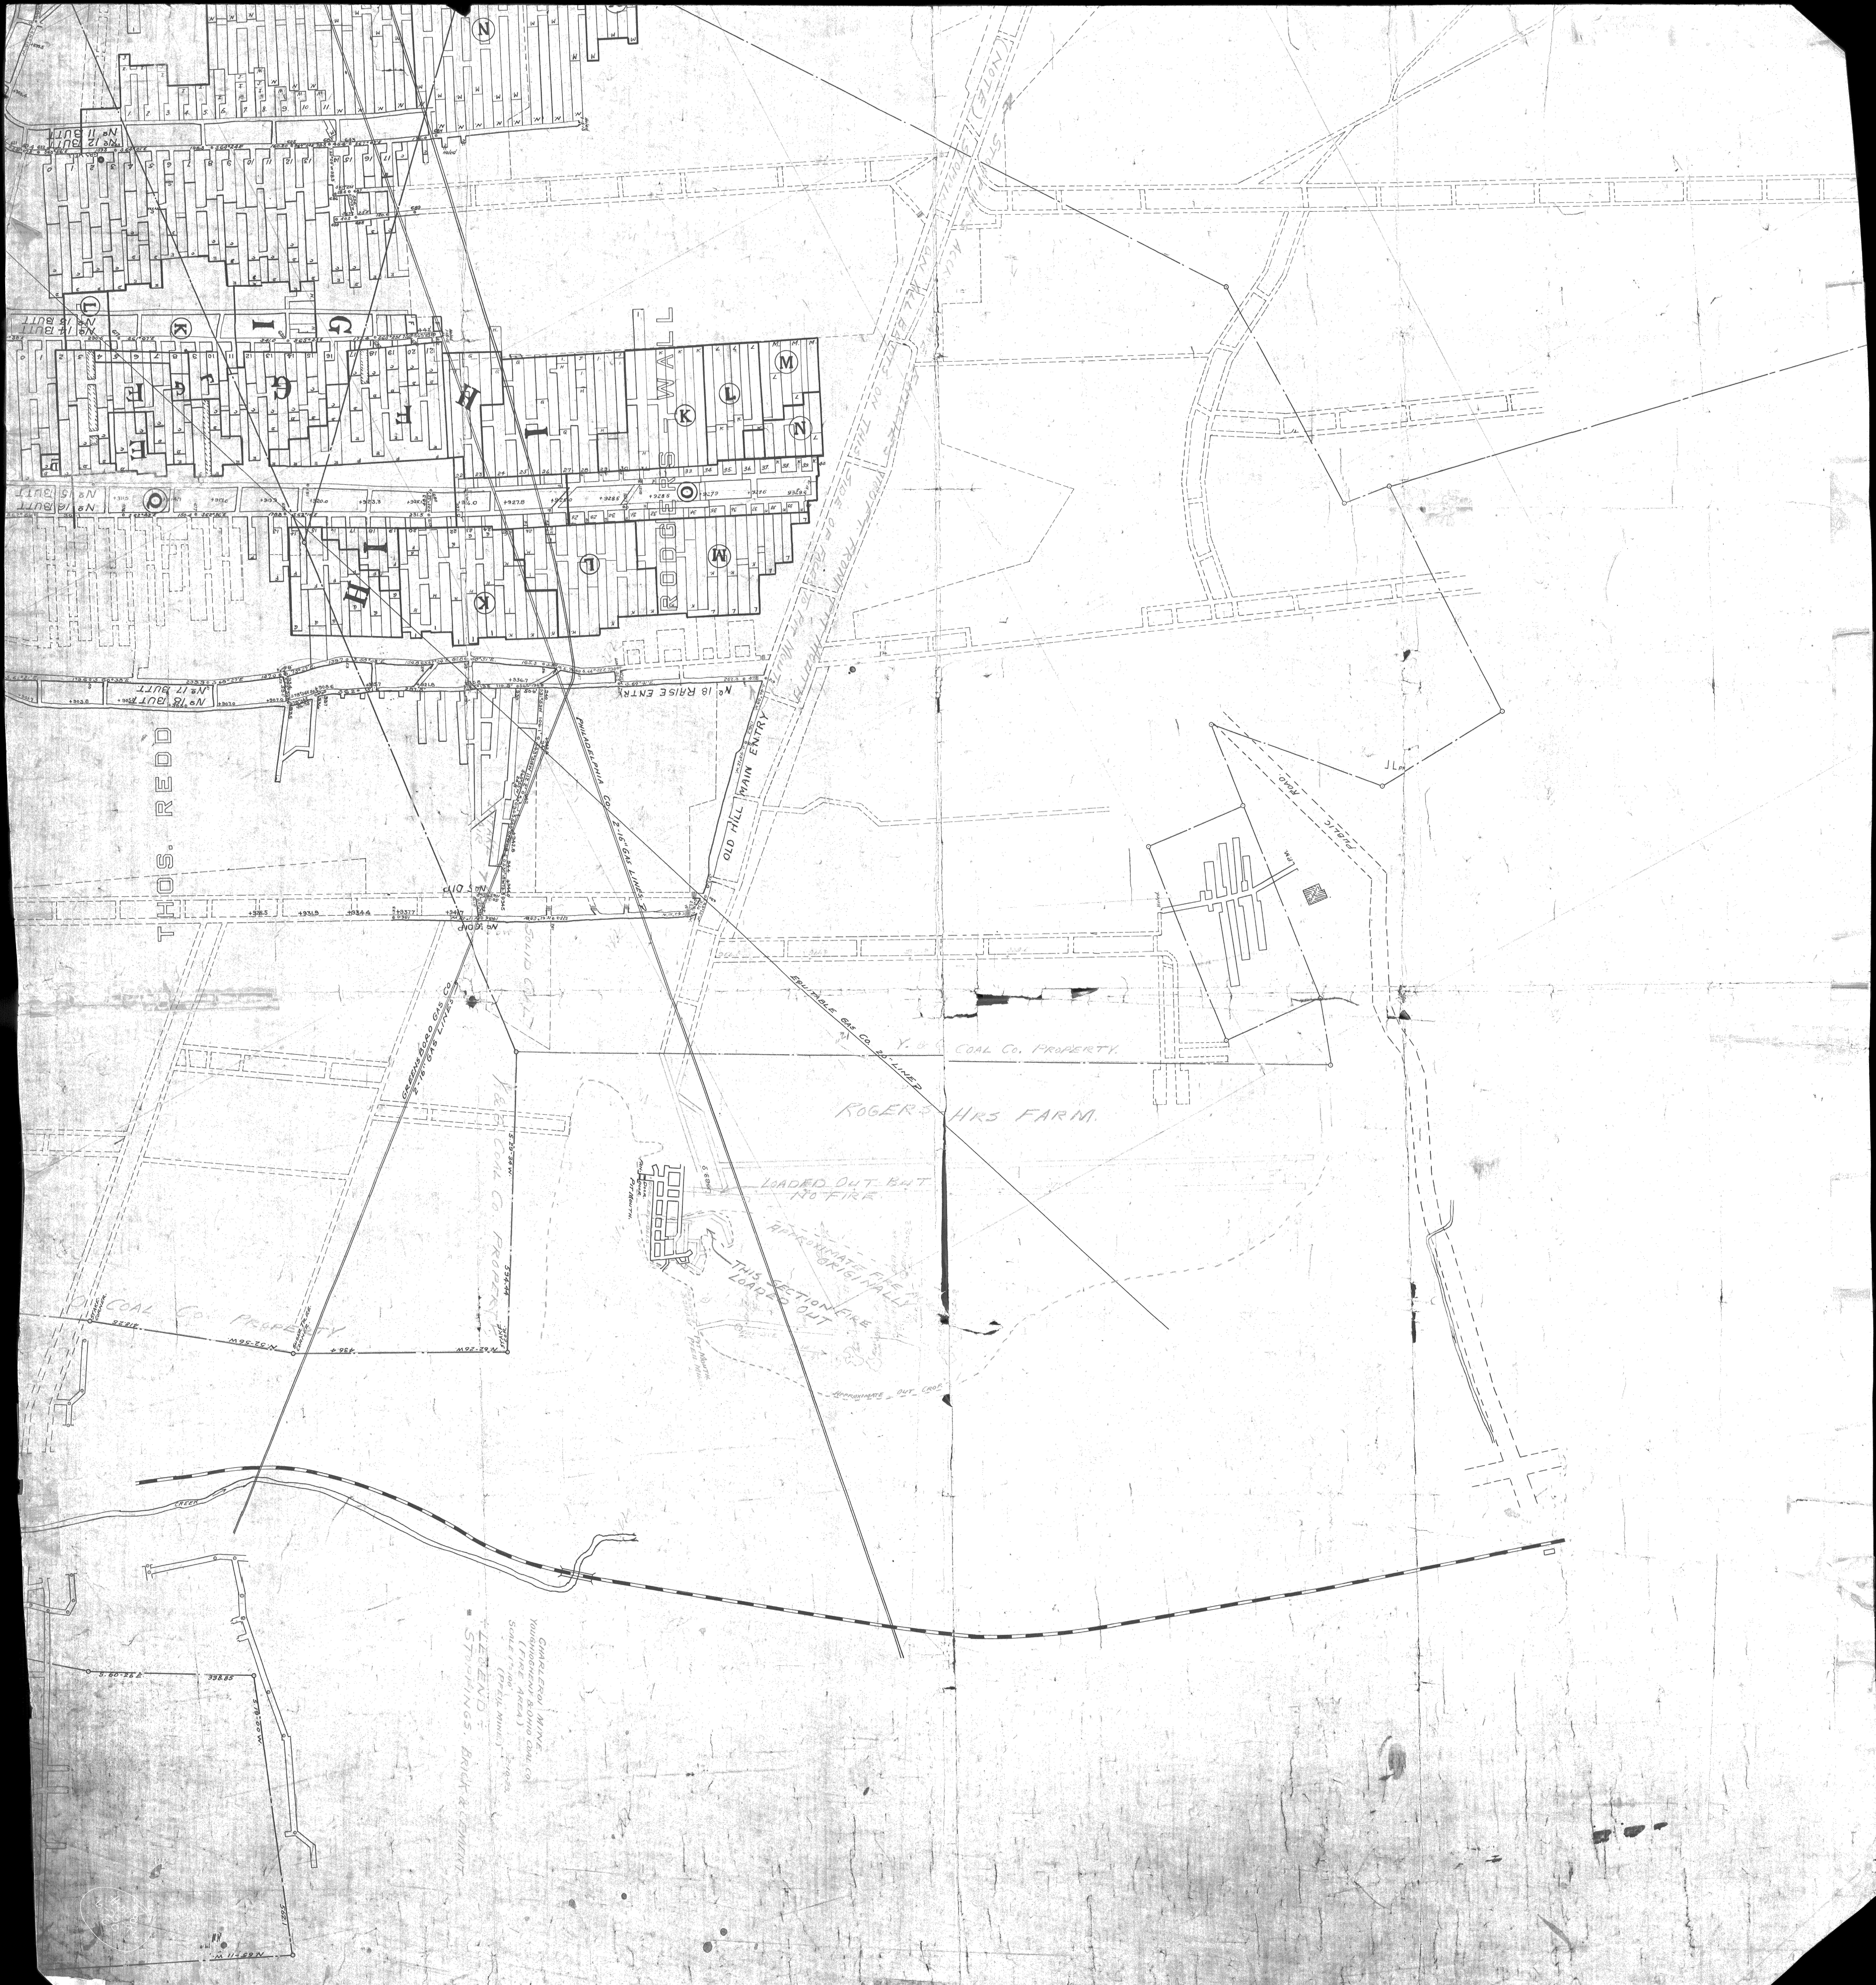

THOS. REDD

OLD HILL MAIN ENTRY

ROGERS WALL

Y. & C. COAL CO. PROPERTY

ROGERS HRS FARM

LOADED OUT BUT NO FIRE

APPROXIMATE FIRE AREA
THIS SECTION FIRE
LOADED OUT

APPROXIMATE OUT CREE

Y. & C. COAL CO. PROPERTY

LEGEND:
STOPPING, BRICK & CEMENT
CHARLES MINE
(FIRE AREA)
SOUTH (100' x 100')
SOUTH (100' x 100')