


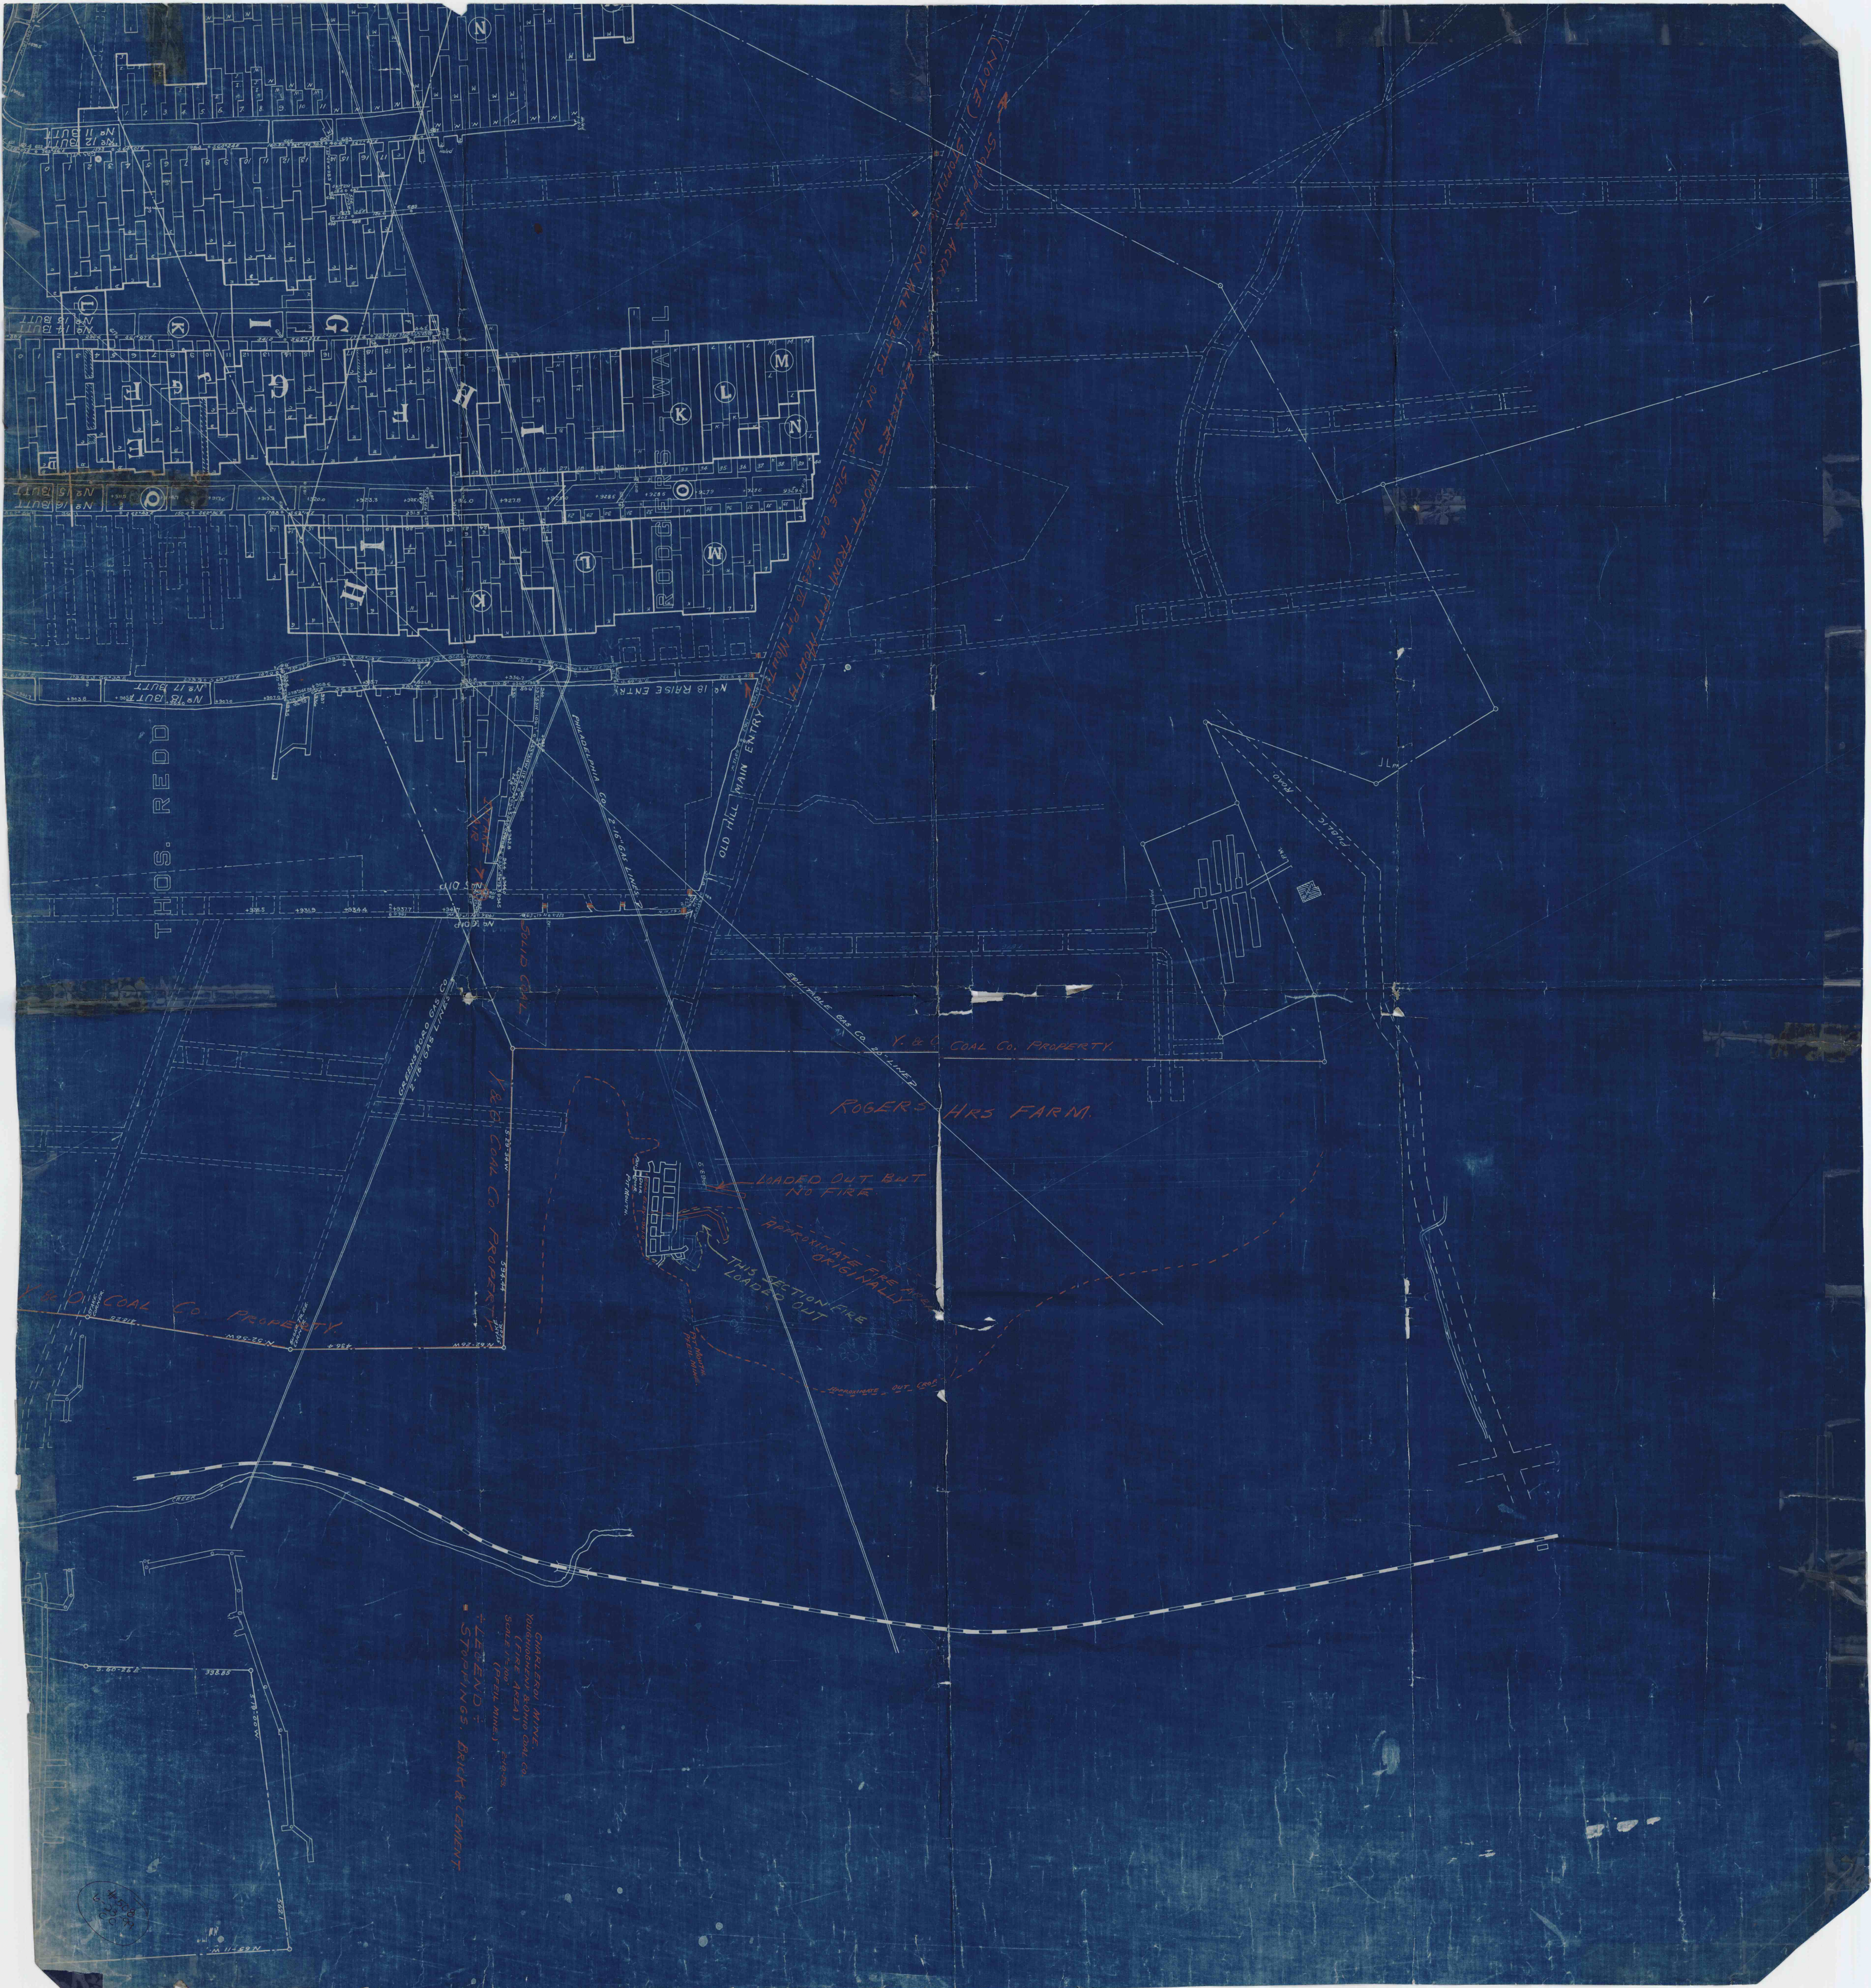

THOS. REDD

OLD HILL MAIN ENTRY

Y & O COAL CO. PROPERTY

ROGERS HRS FARM

LOADED OUT BUT NO FIRE

APPROXIMATE FIRE AREA
THIS SECTION FIRE
LOADED OUT

(FIRE AREA)
SCALE 1" = 100'
(FIRE AREA)
