


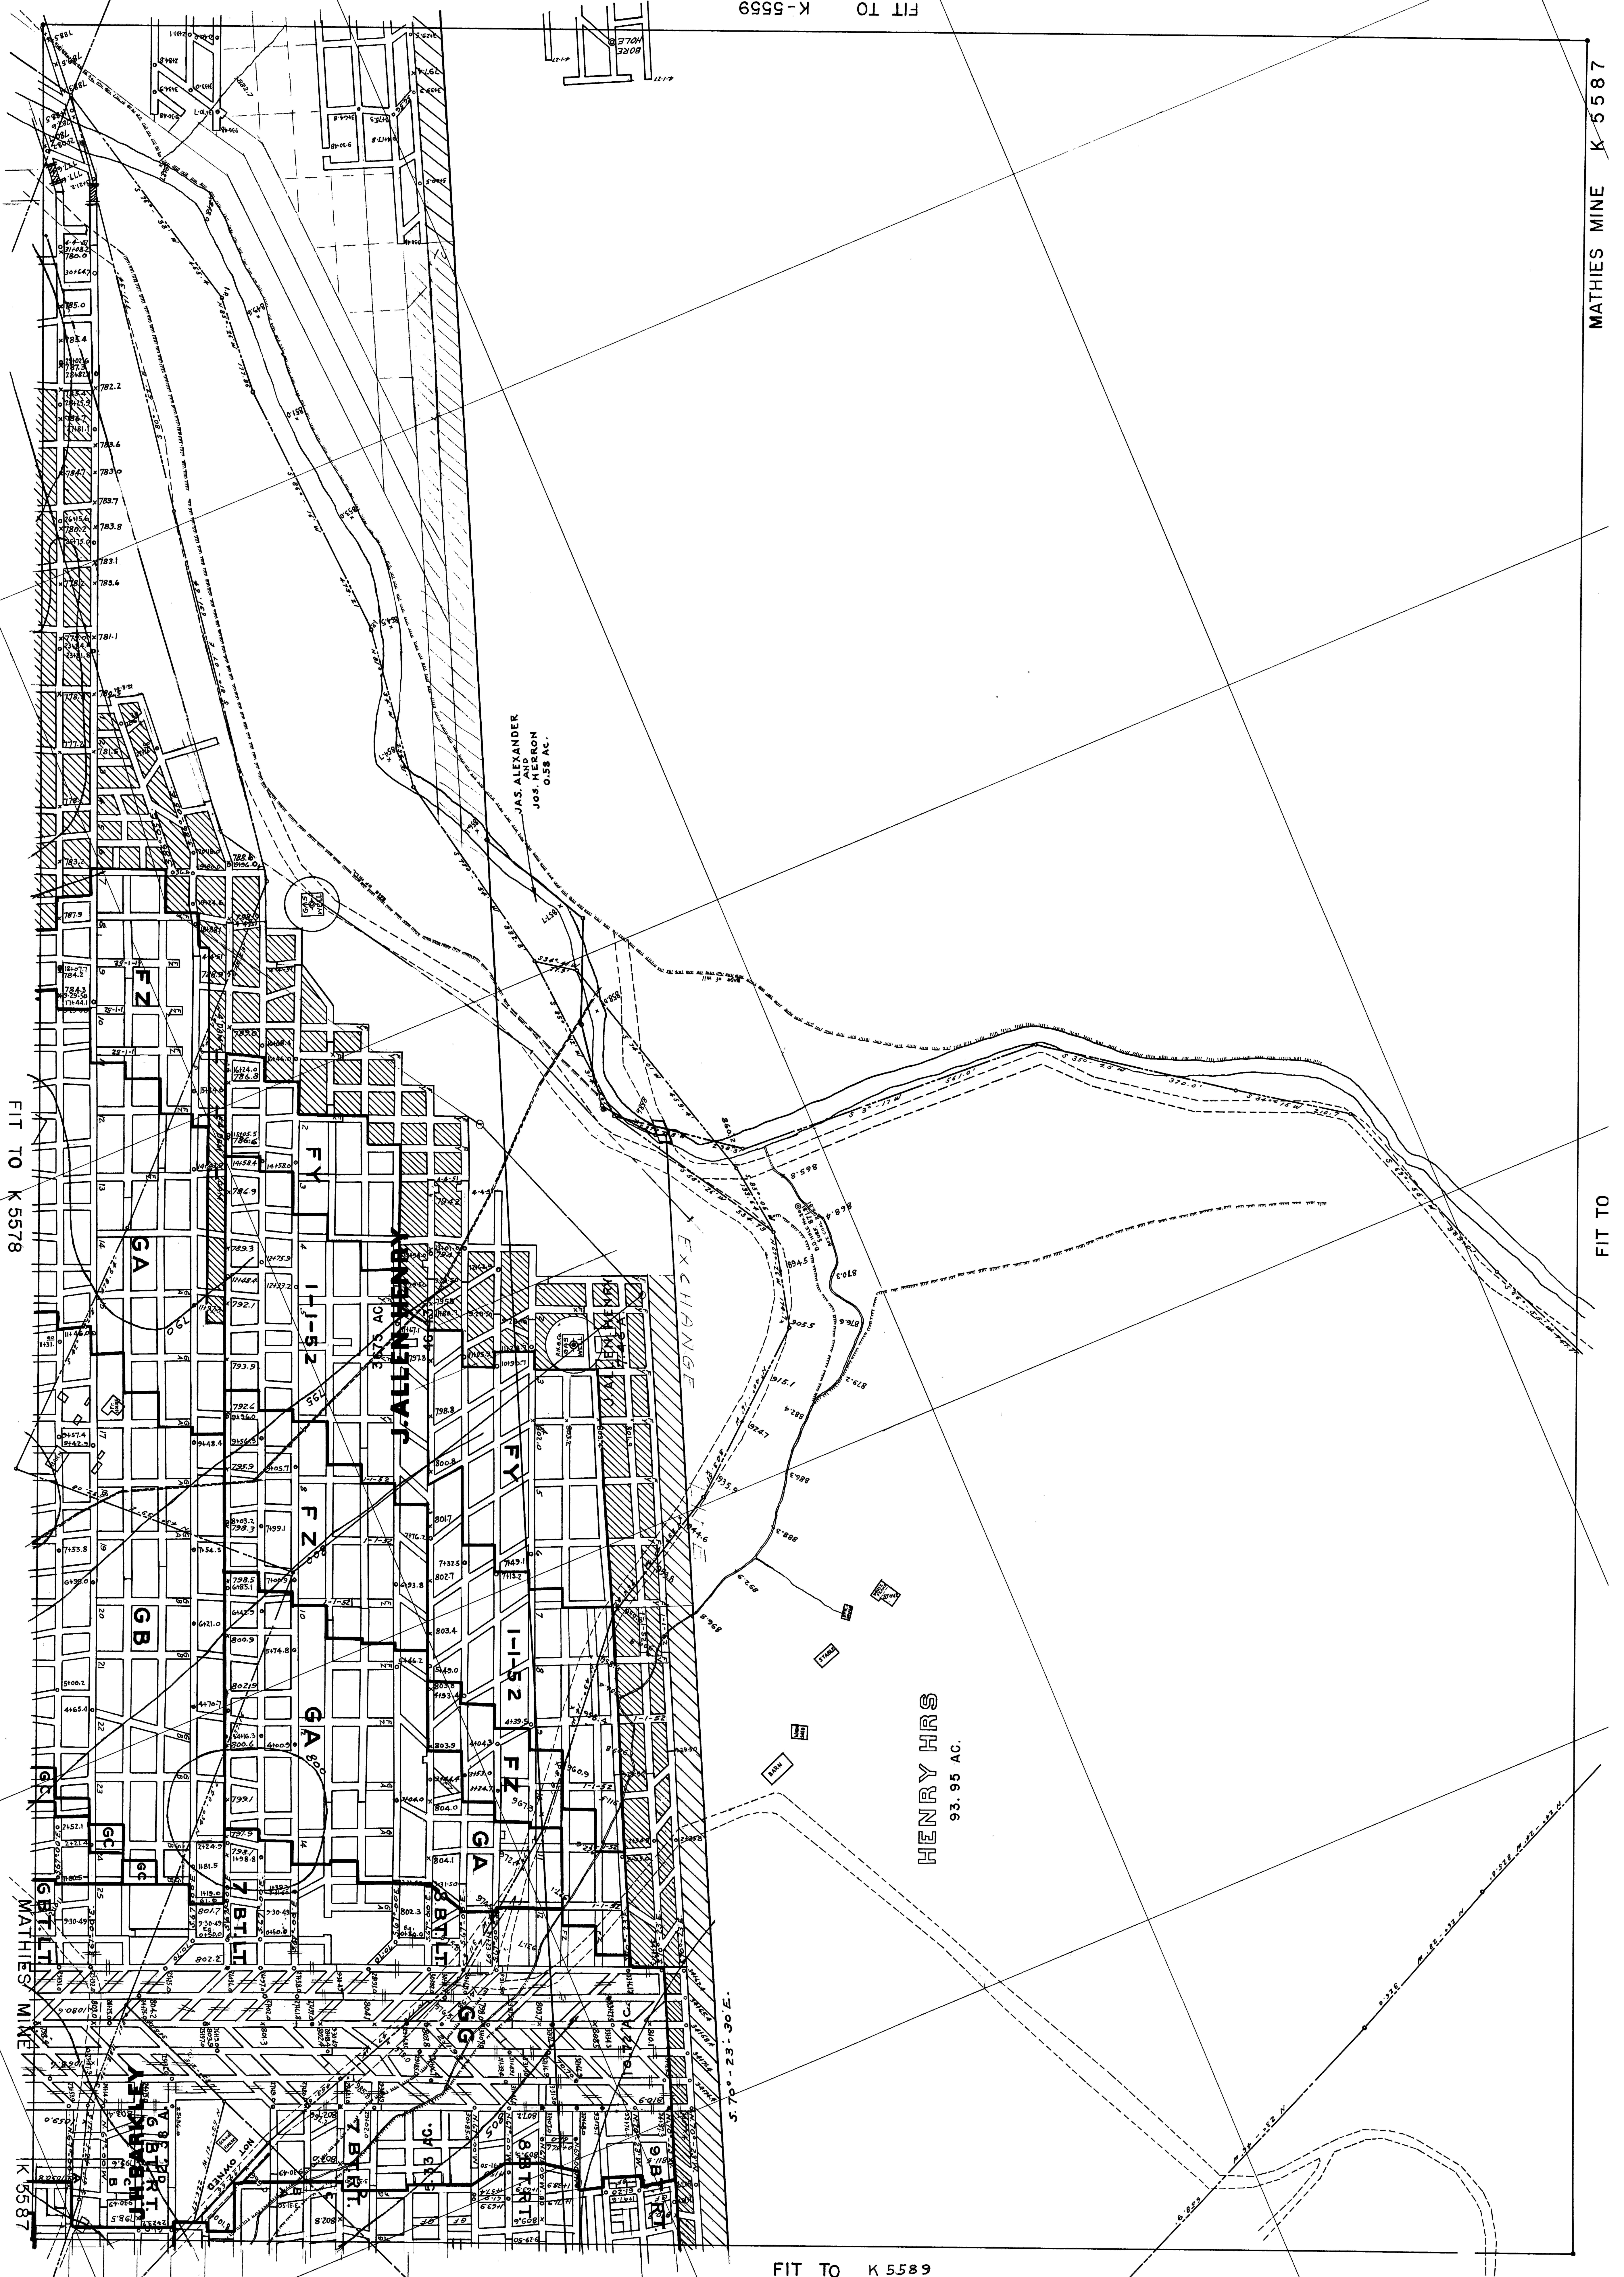

MATHIES MINE K-5587

FIT TO

FIT TO K-5589

FIT TO K-5578

K-5587

FIT TO K-5559