


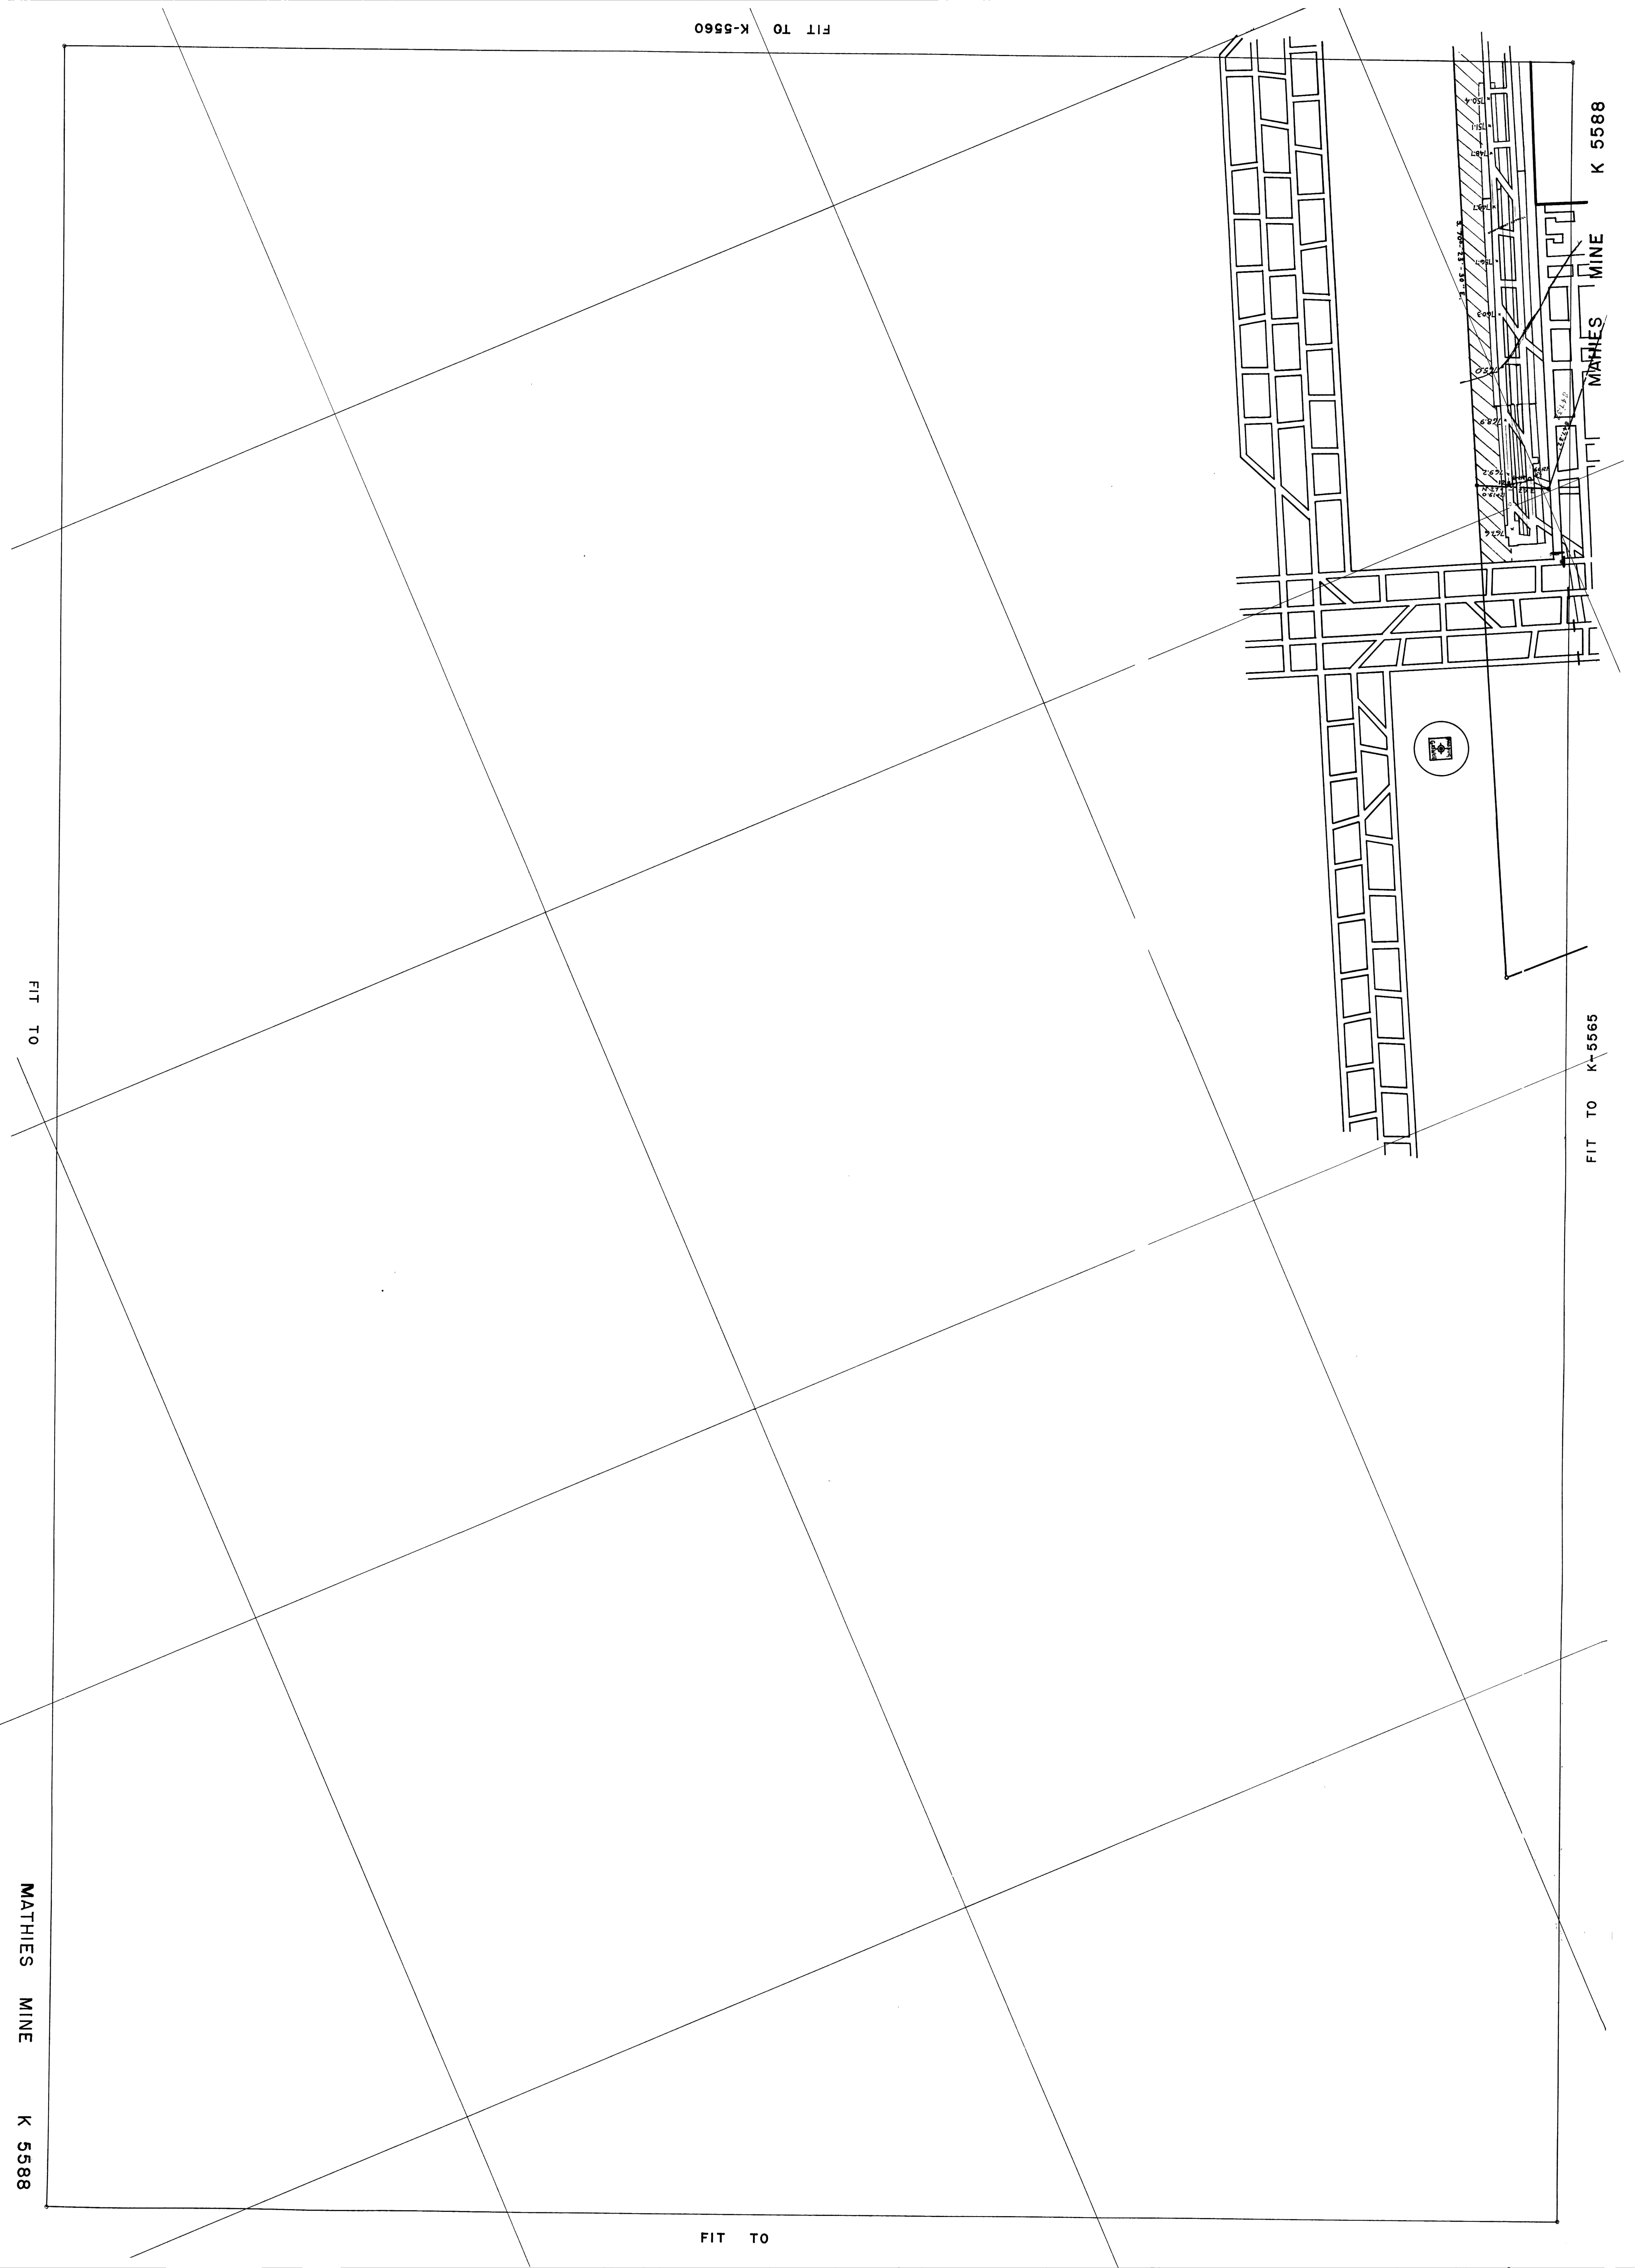

FIT TO

MATHIES MINE K 5588

FIT TO

FIT TO K-5560

FIT TO K-5565

MATHIES MINE K 5588