


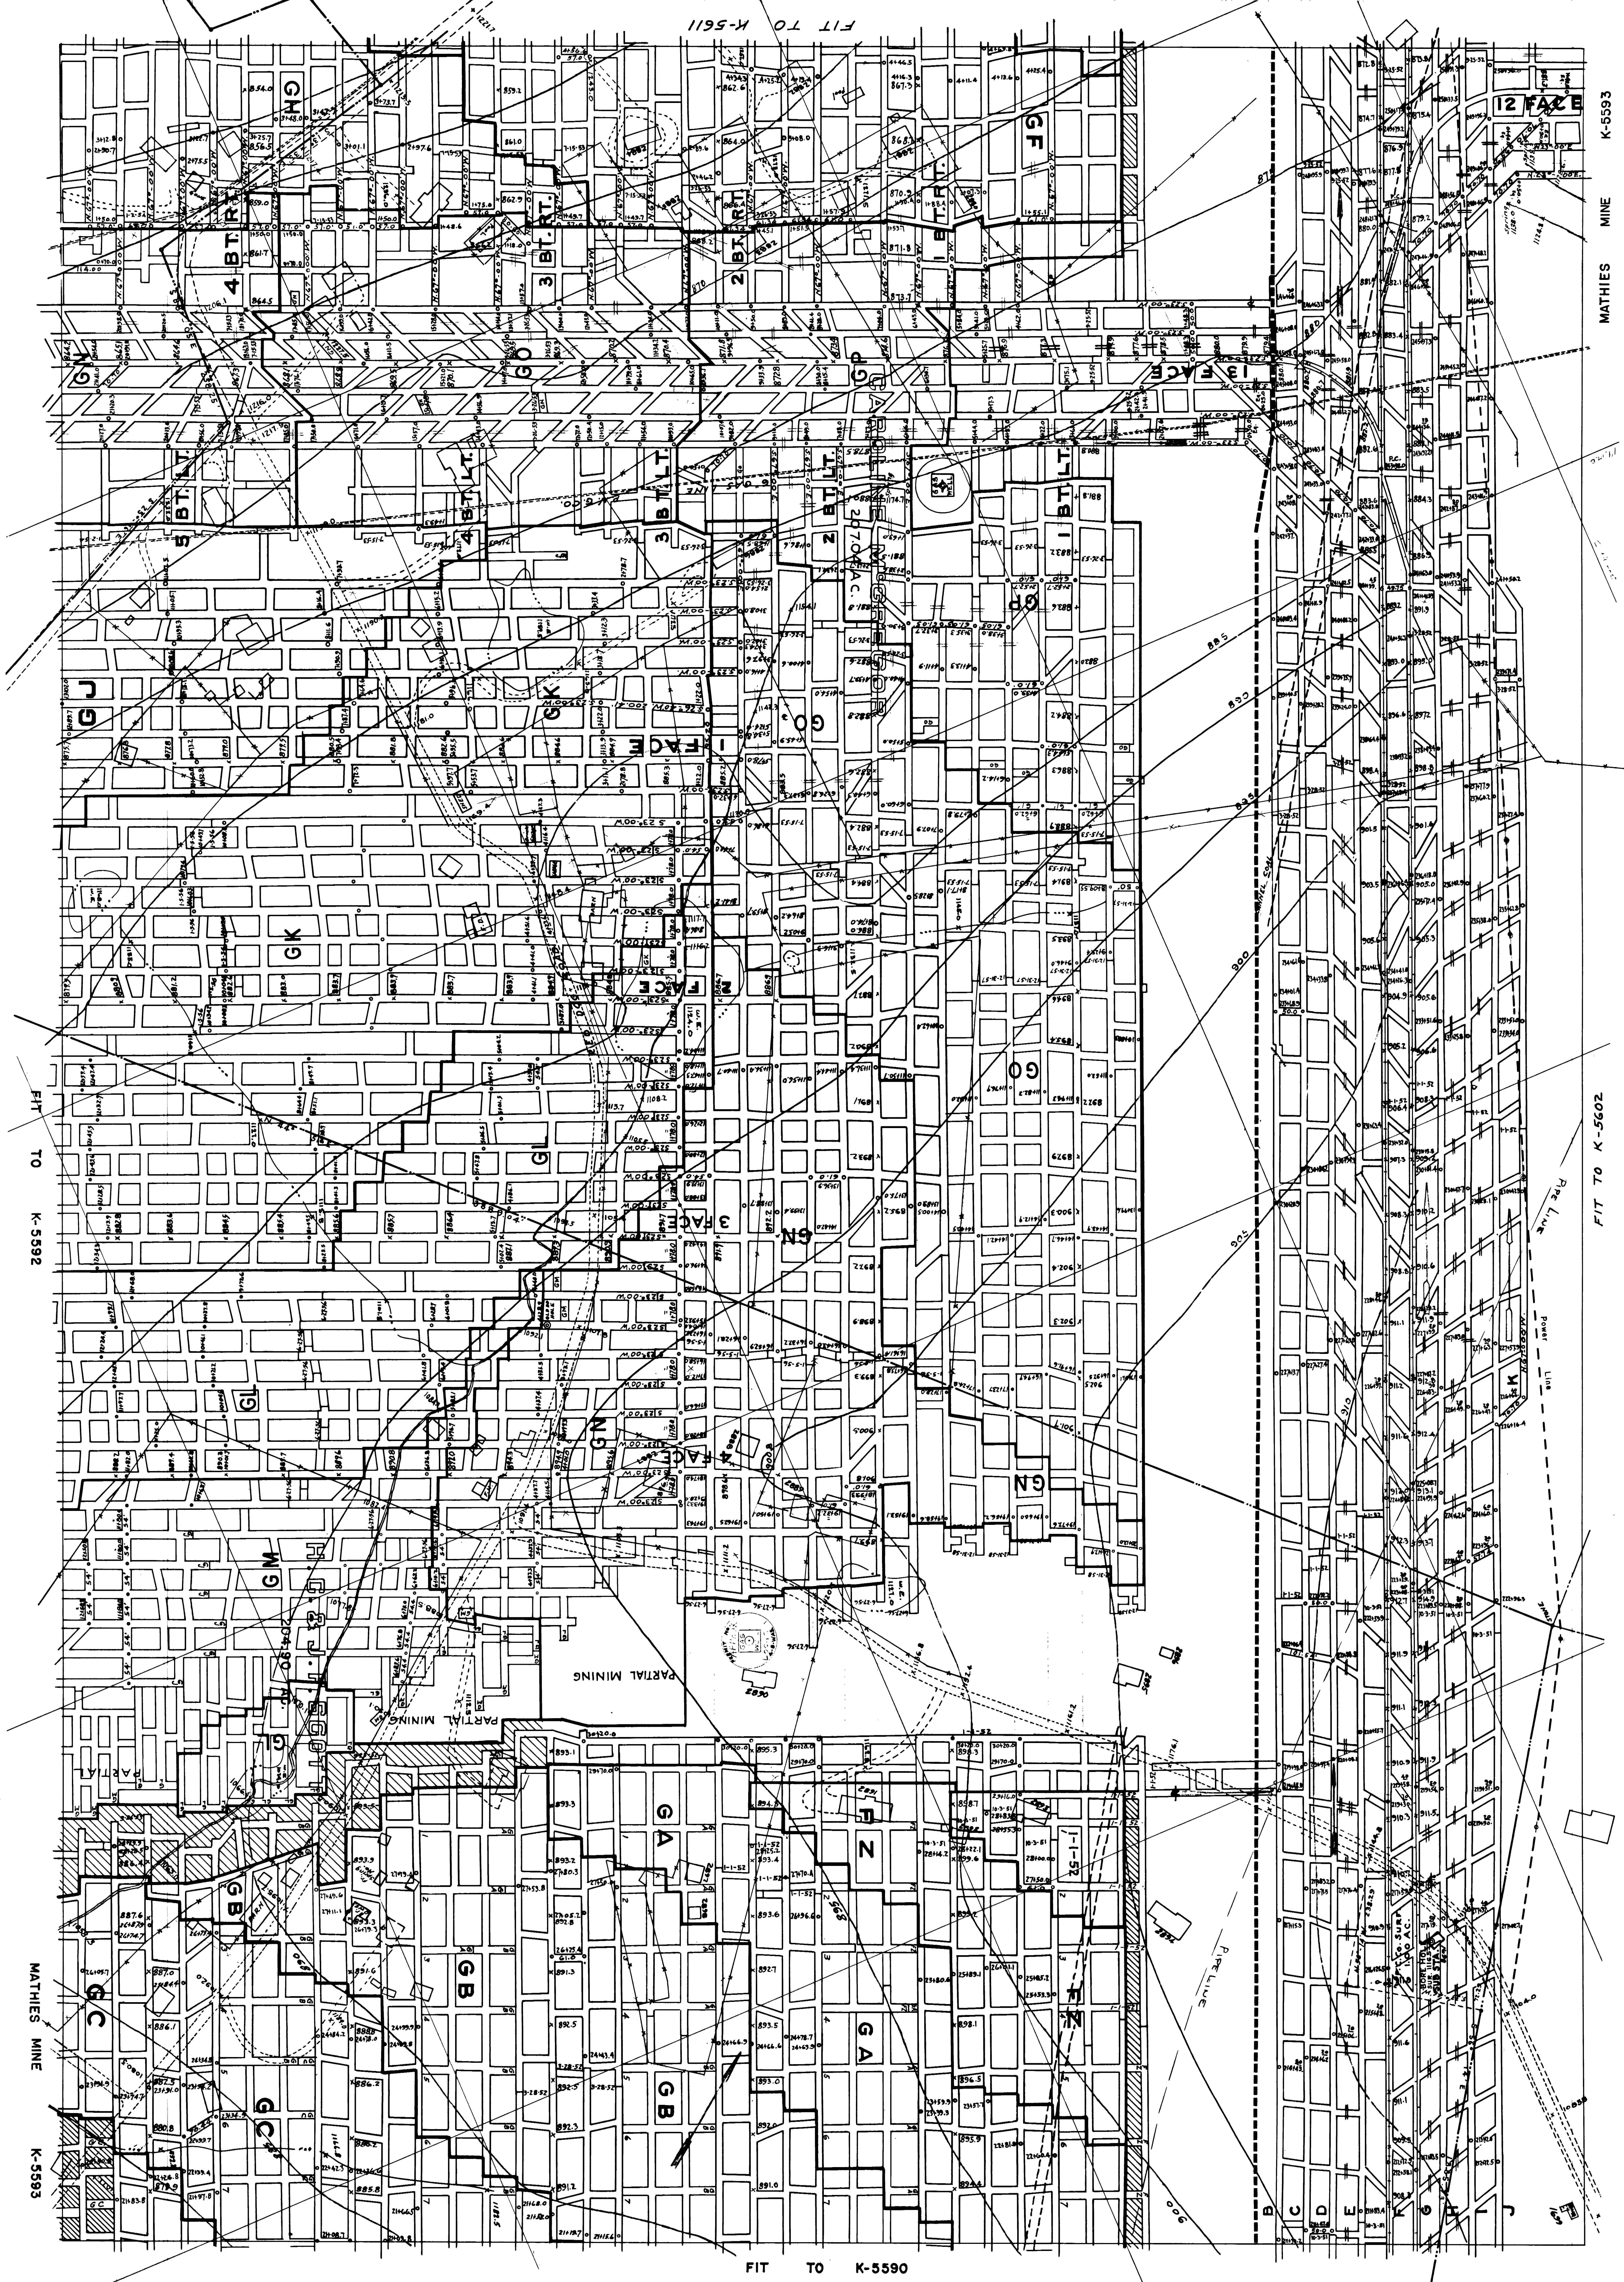

MATHIES **MINE** **K-5593**

FIT TO K-5602