


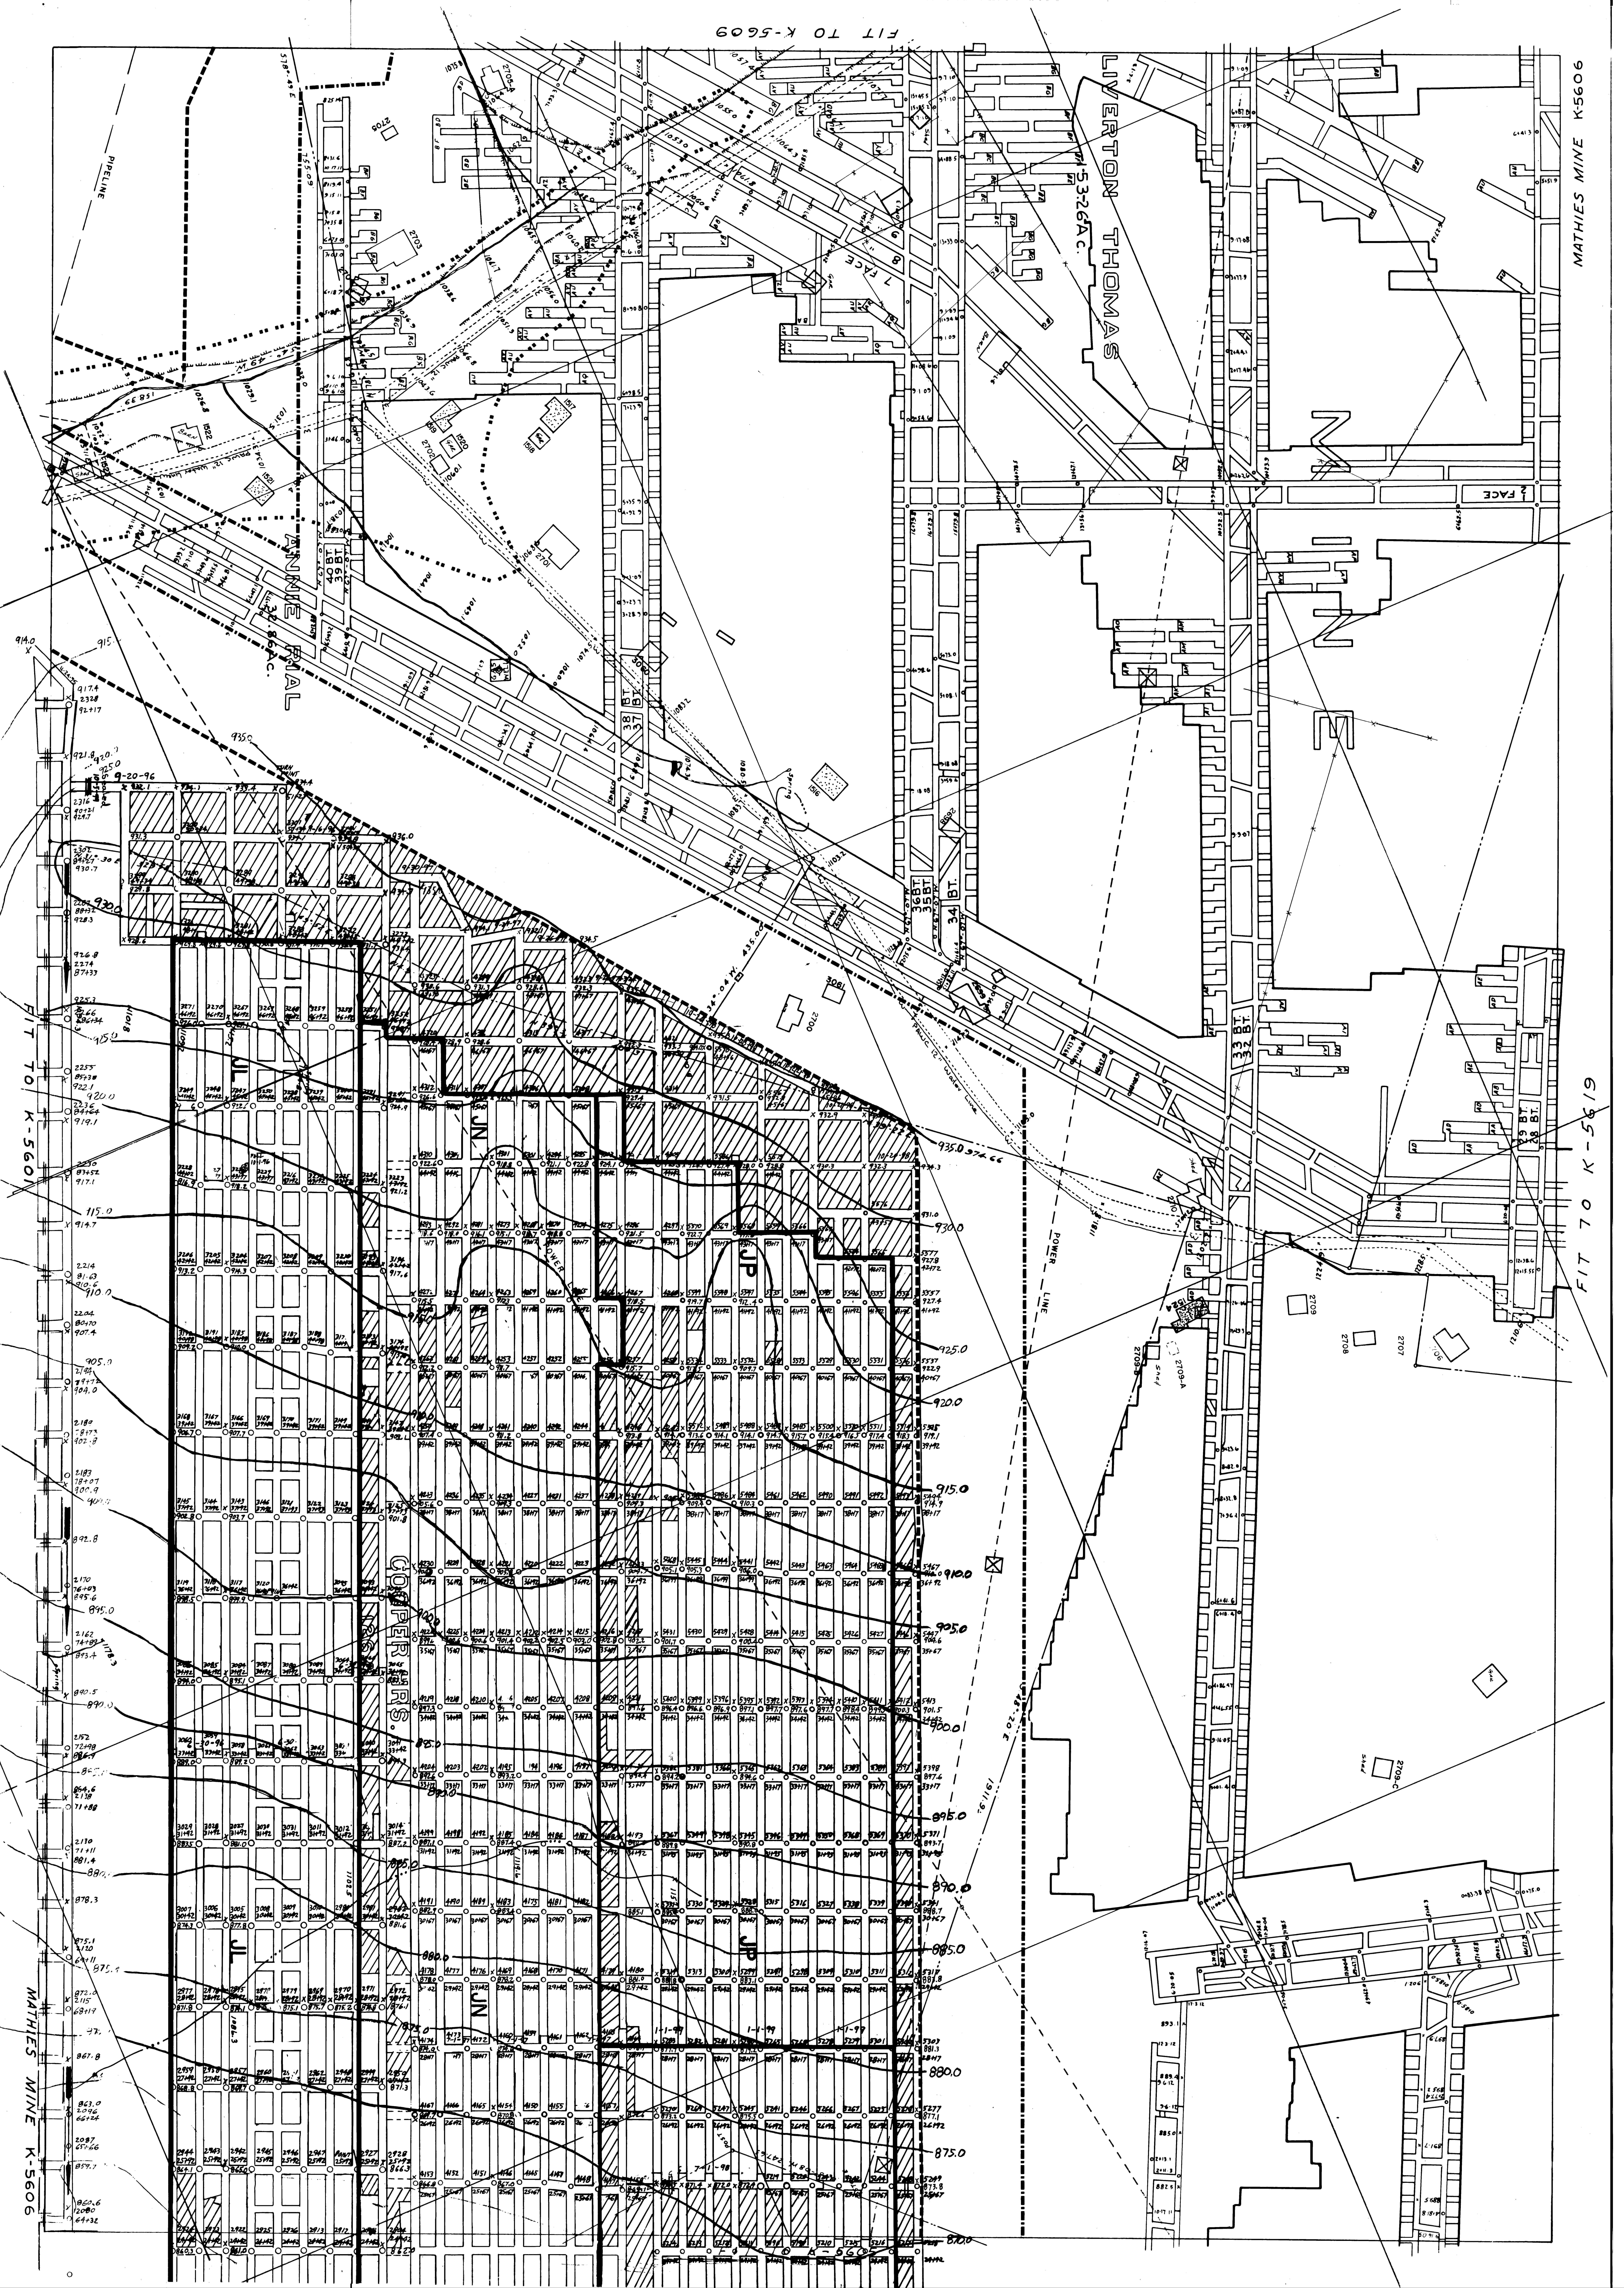

MATHIES MINE K-5606

